PARENT PARCEL: 04-00-007-102-034

CHILD PARCEL: AC CORR FROM 1.09 PER PRIOR DEED VOL 449, PG 275

STARTING POINT: C/L OF LAKE RD AND W LINE OF TEN BAKER'S ALLOTMENT

23-05084-A

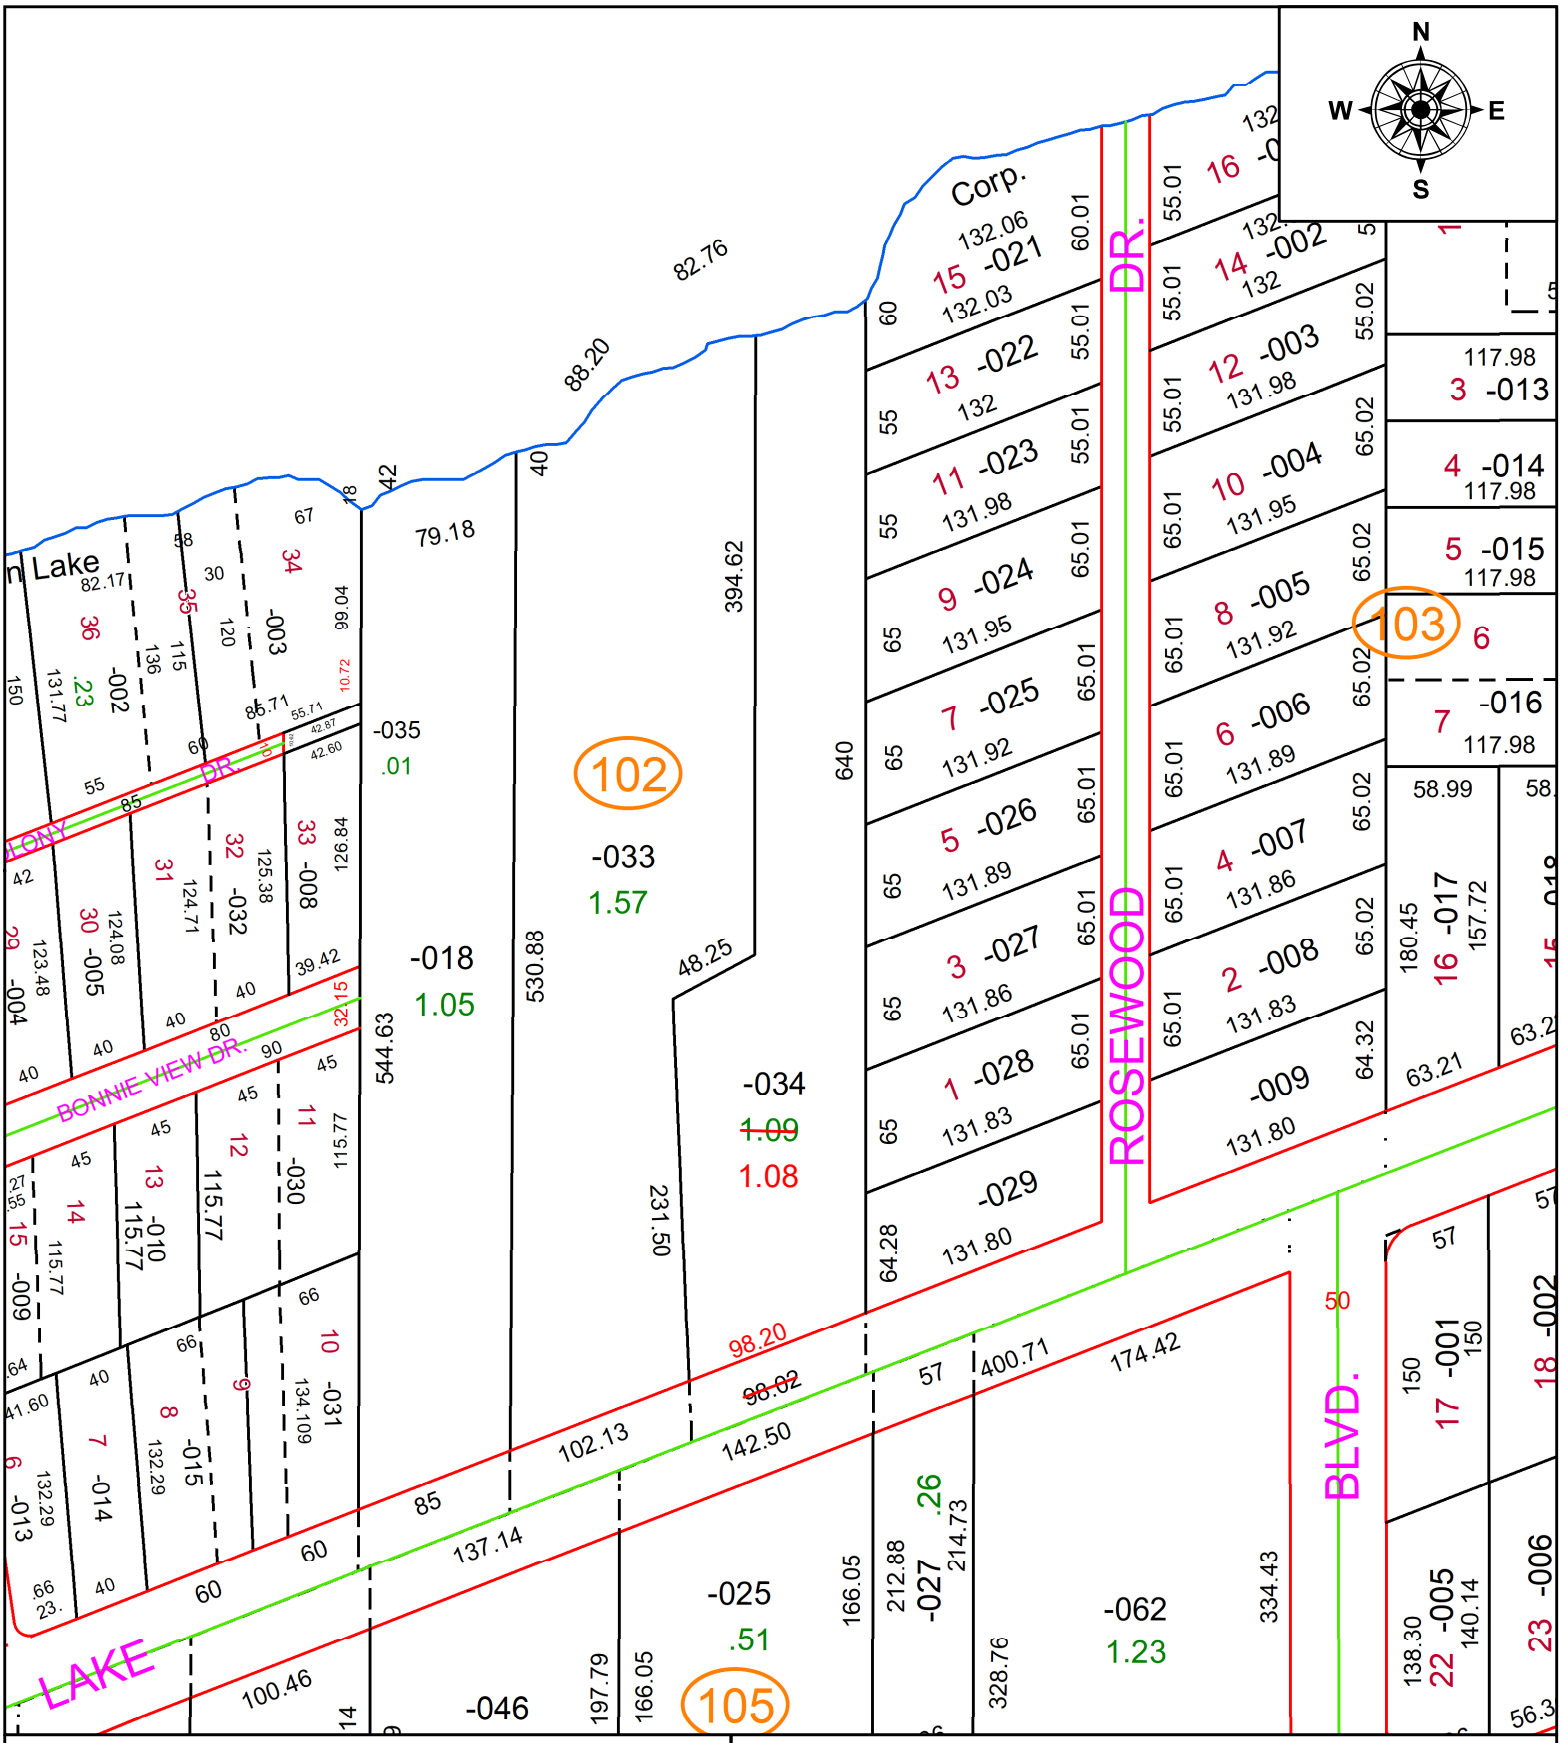

SPLITS/DEEDS PROCESSED

LORAIN COUNTY TAX MAP DEPARTMENT
226 MIDDLE AVE. ELYRIA, OH

SURVEYED BY: N/A **SURV # N/A**

CLOSURE: 1: 100789

MAP PAGE(S): 04-00-007

APPOVED BY: AC **DATE:** May 22, 2023

SCALE: 1 in = 100 ft **PRIOR INSTRUMENT:** VOL 449, PG 275