PARENT PARCEL: 04-00-028-102-165 & -166
CHILD PARCEL: 04-00-028-102-192
STARTING POINT: SW CORNER OF O/L 28 **AC CORR PER SURV BY AMY M. KELLY**

25-05085

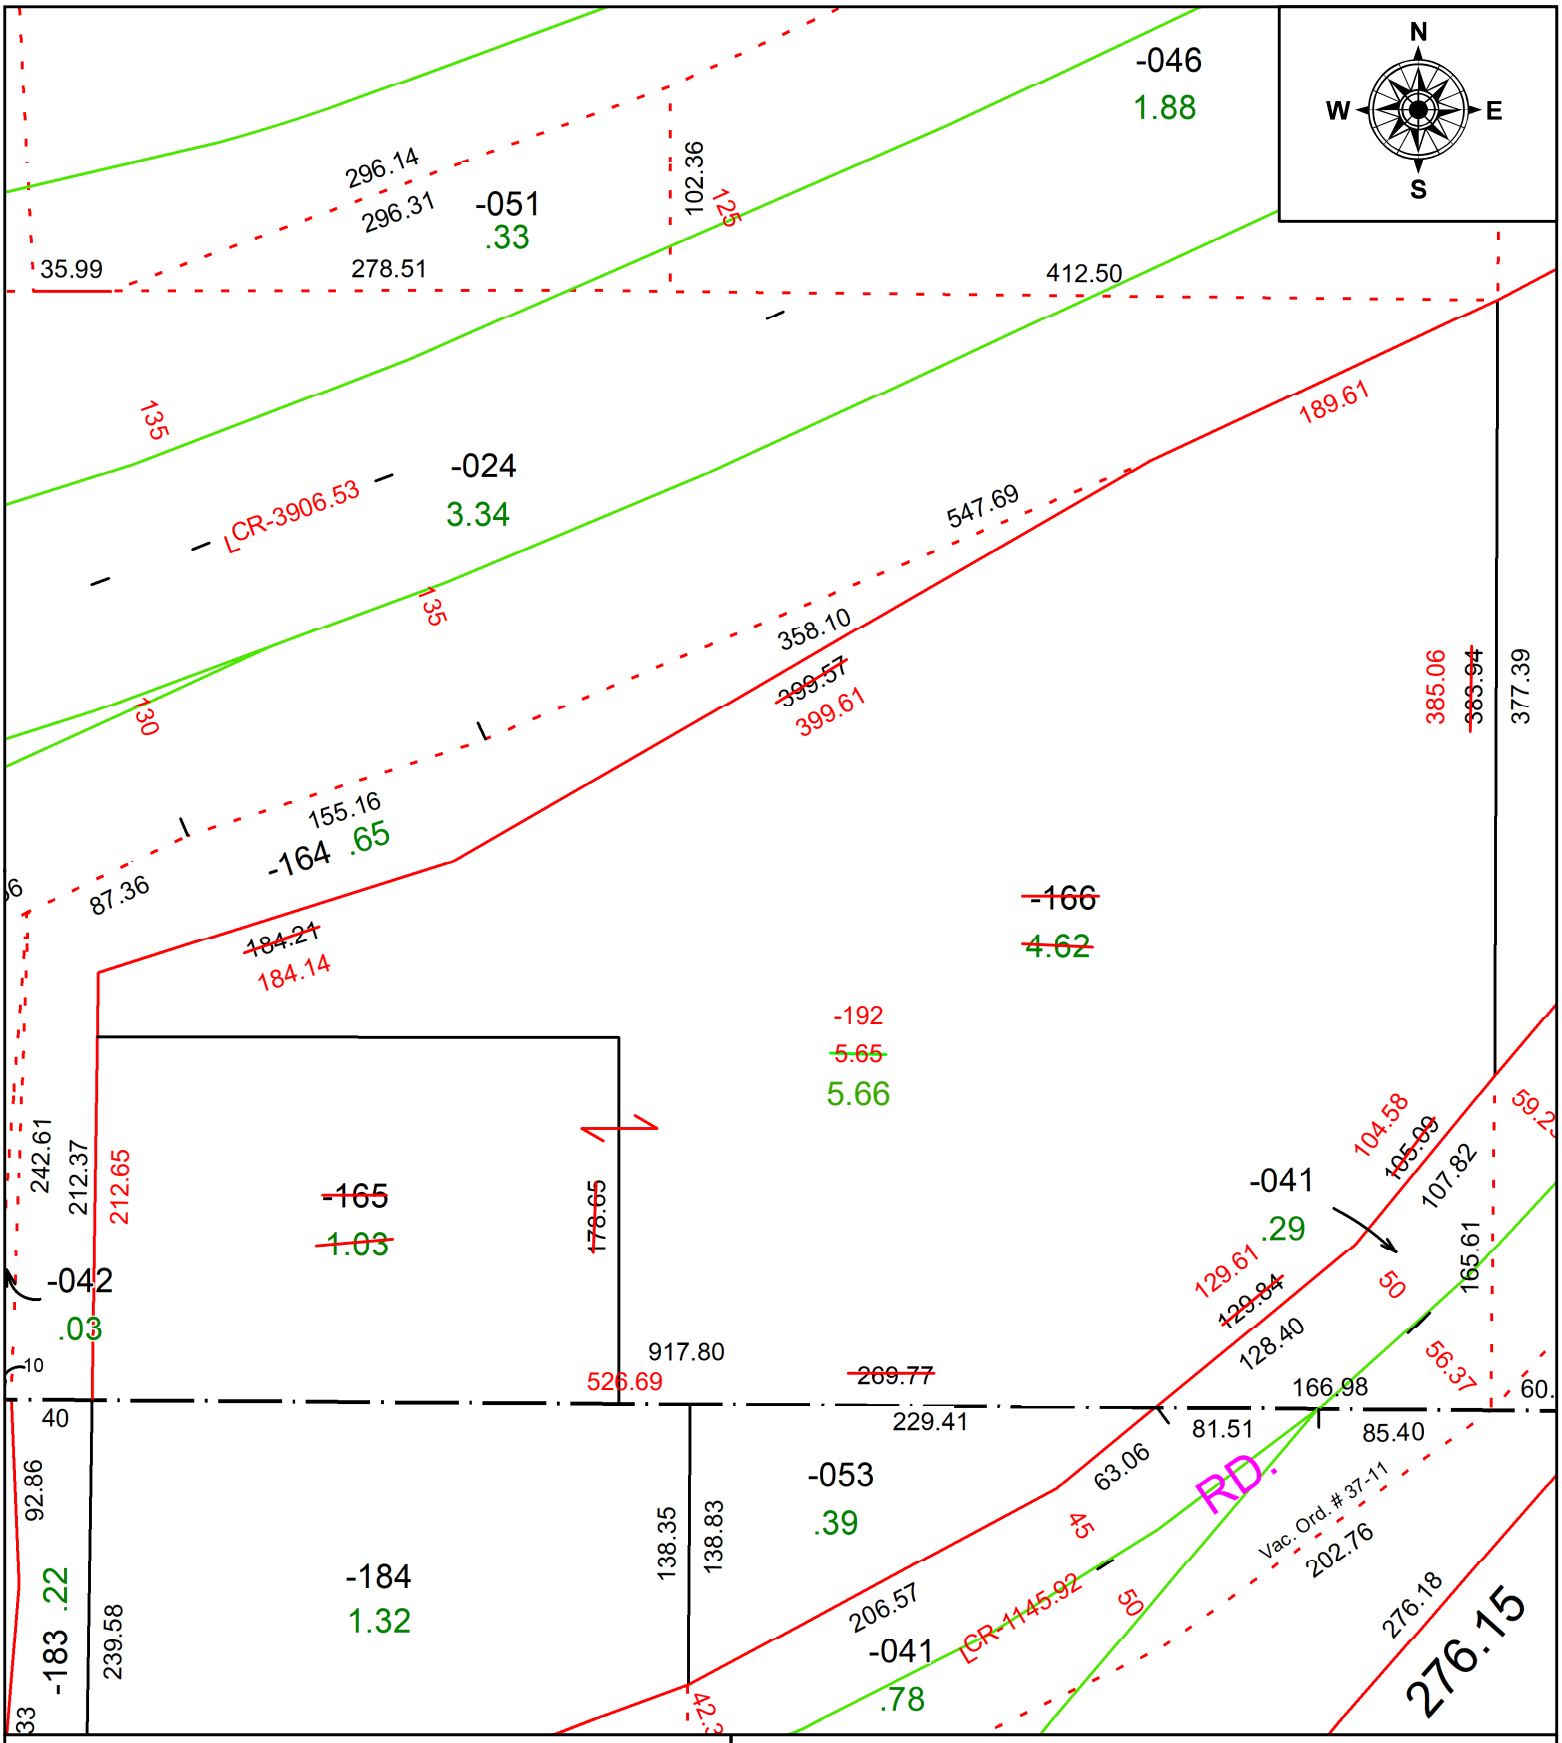

SPLITS/DEEDS PROCESSED
LORAIN COUNTY TAX MAP DEPARTMENT
226 MIDDLE AVE. ELYRIA, OH

SURVEYED BY: AMY M. KELLY **SURV # 51586**
CLOSURE: 1: 450158
MAP PAGE(S): 04-00-028
APPOVED BY: AC **DATE:** November 05, 2025
SCALE: 1 in = 95 ft **PRIOR INSTRUMENT:** 2025- 0071032