PARENT PARCEL: 12-00-066-104-016, -017, & 12-00-067-000-010

CHILD PARCEL: ACREAGE CORRECTION PER SURVEYOR STEVEN METCALF

STARTING POINT: NORTHWEST CORNER OF O.L. 66 & C/L OF ELYRIA-TWINSBURG RD

23-05089-C

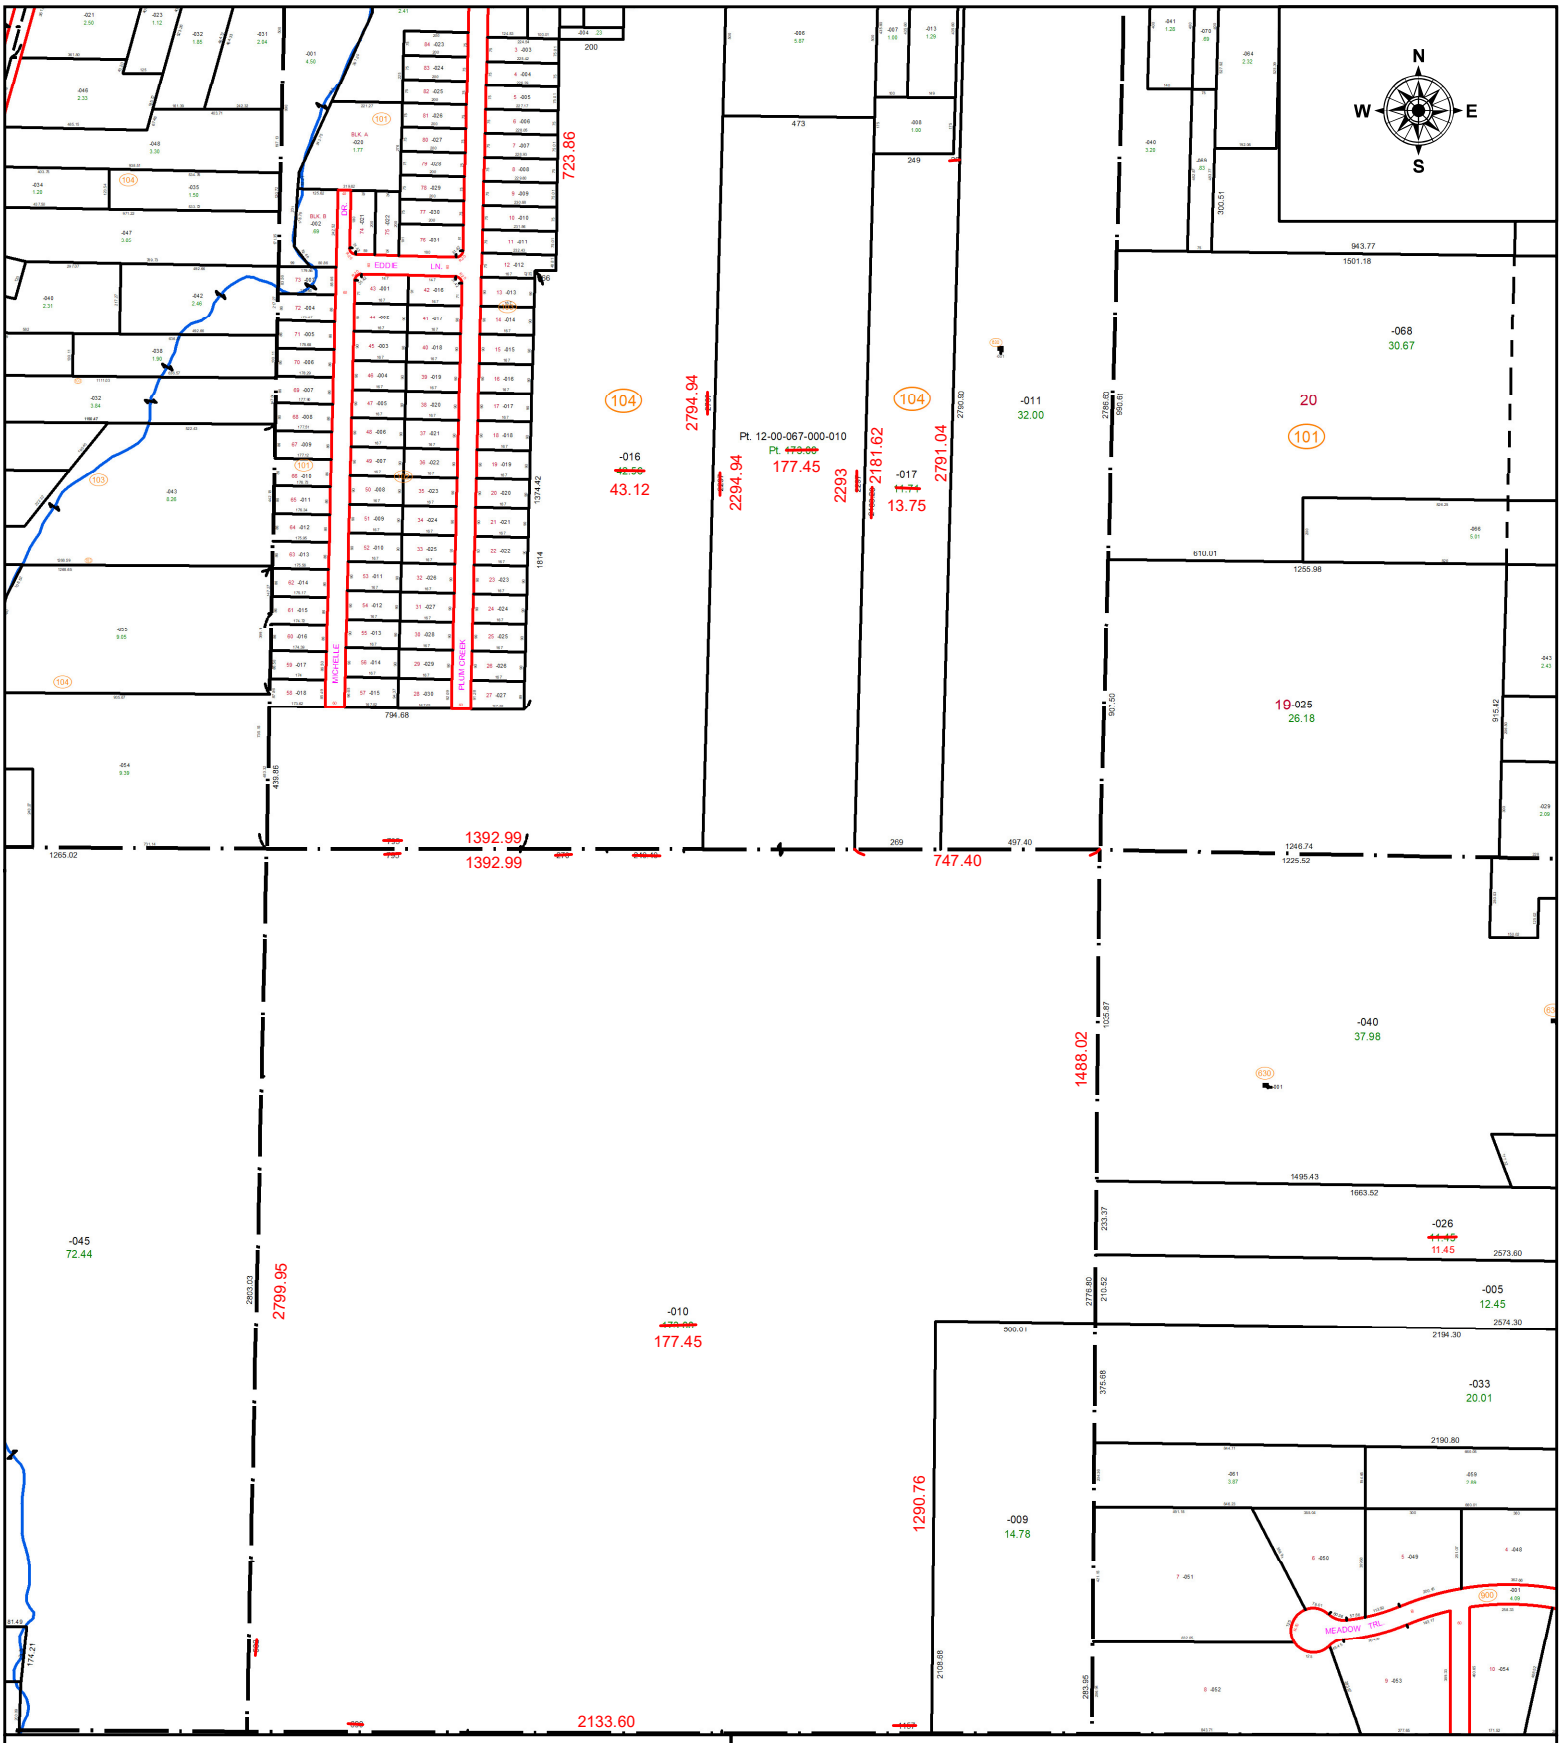

SPLITS/DEEDS PROCESSED

LORAIN COUNTY TAX MAP DEPARTMENT
226 MIDDLE AVE. ELYRIA, OH

SURVEYED BY: STEVEN METCALF — SURVEY # 50903

CLOSURE: 1: 640625

MAP PAGE(S): 12-00-066 & 12-00-067

APPOVED BY: WRZ **DATE:** 5/30/2023

SCALE: 1" = 600 **PRIOR INSTRUMENT:** #2016-0573888