PARENT PARCEL: 07-00-018-105-041, -042, & -123
CHILD PARCEL: 07-00-018-105-175
STARTING POINT: SW CORNER OF S/L 5

25-05090

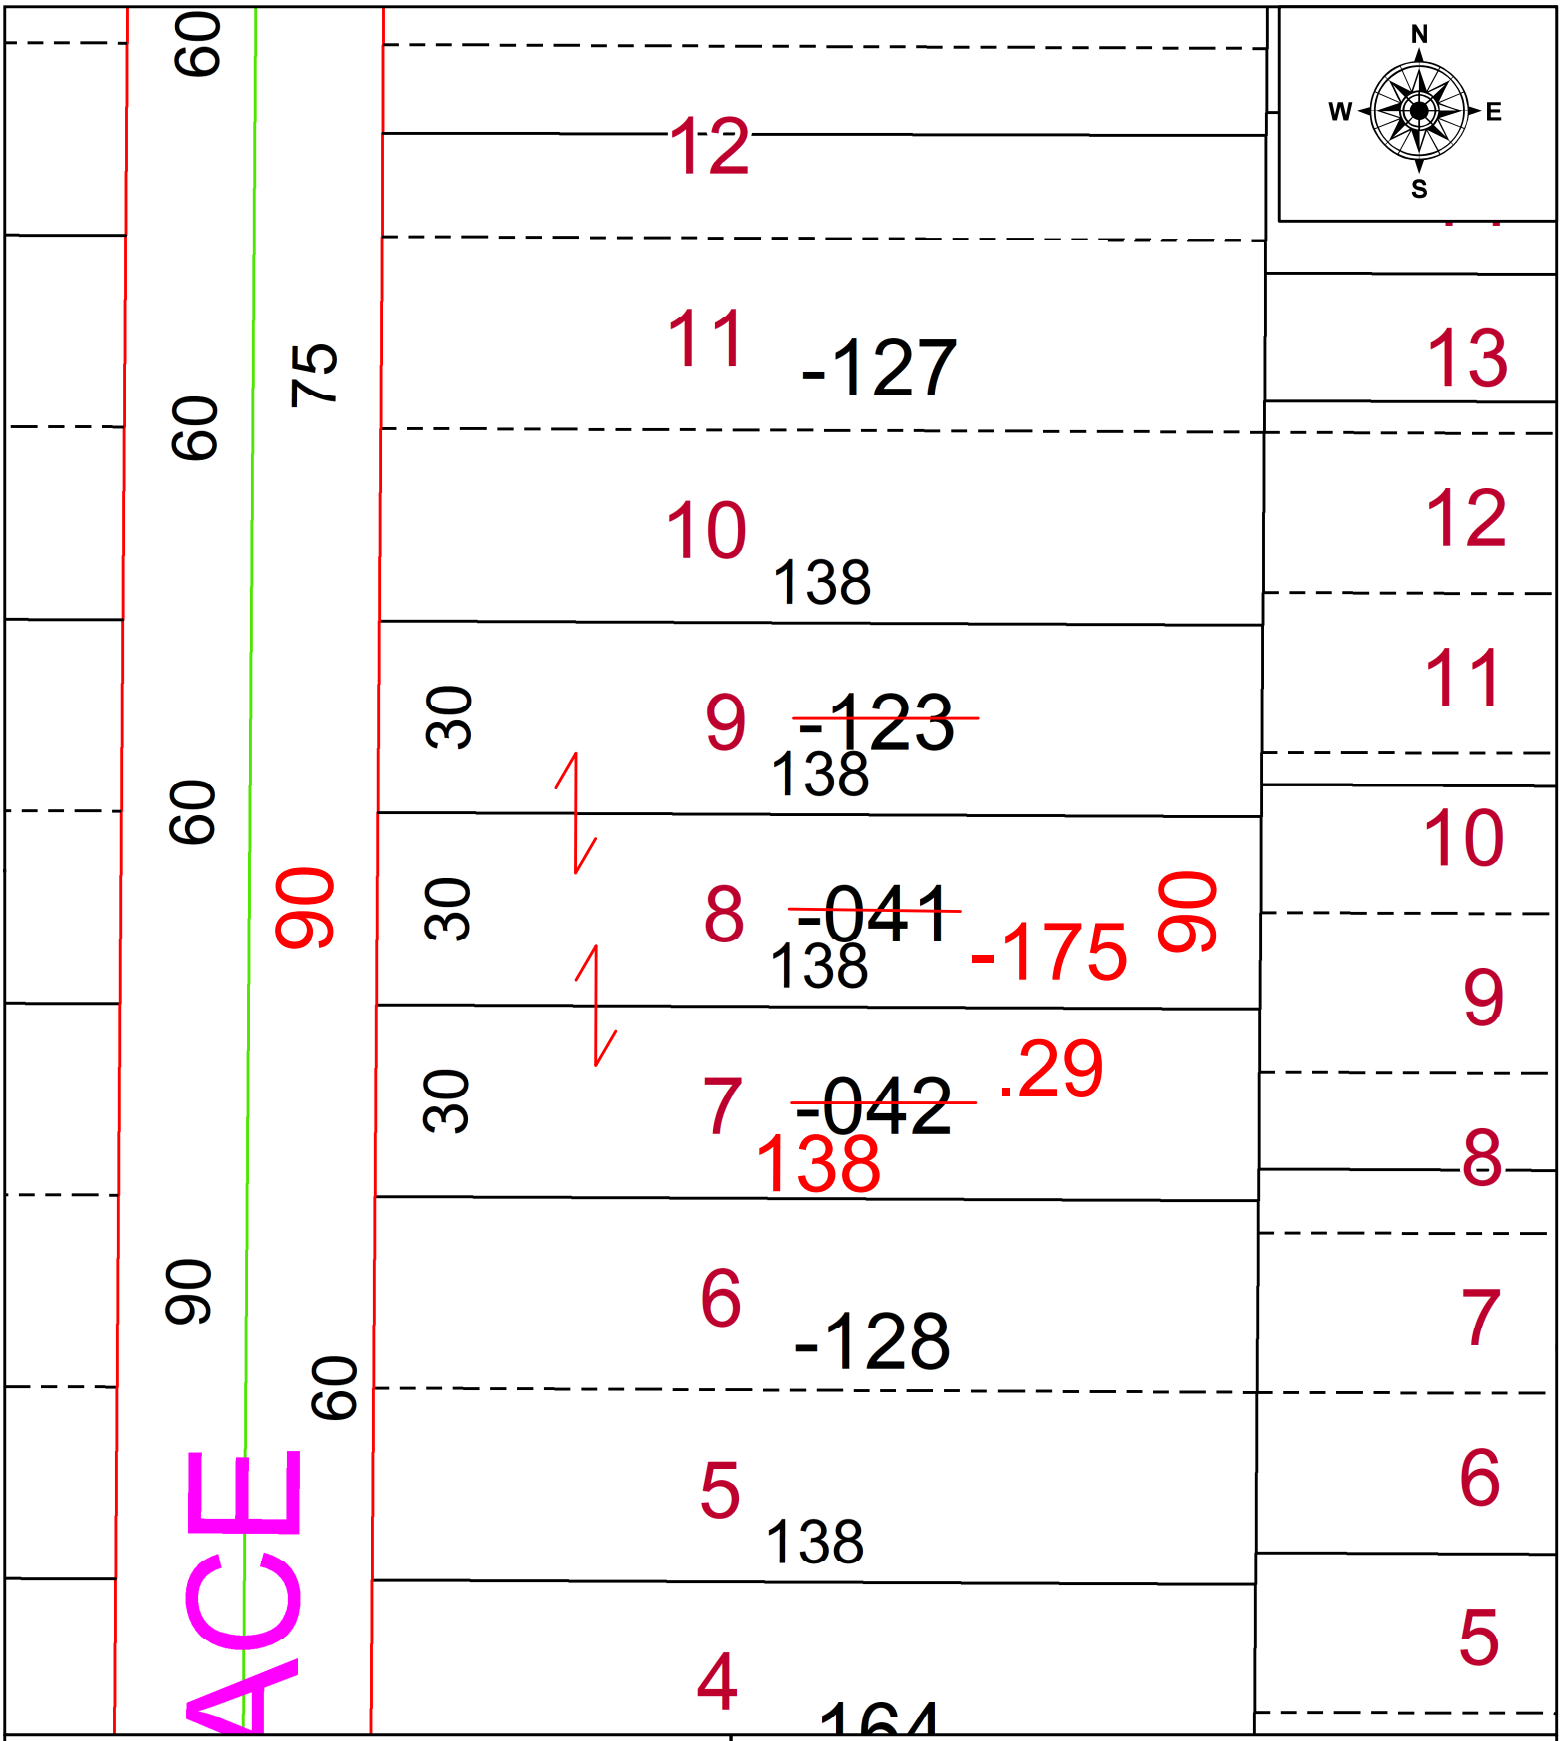

SPLITS/DEEDS PROCESSED
LORAIN COUNTY TAX MAP DEPARTMENT
226 MIDDLE AVE. ELYRIA, OH

SURVEYED BY: JOSHUA S. RIEDY **SURV # 51593**
CLOSURE: 1: INF
MAP PAGE(S): 07-00-018
APPOVED BY: AC **DATE:** November 13, 2025
SCALE: 1 in = 30 ft **PRIOR INSTRUMENT:** 2025- 0065813