PARENT PARCEL: 10-00-003-115-024 & -025

CHILD PARCEL: 10-00-003-115-062

STARTING POINT: C/L OF BIGGS RD

25-05094

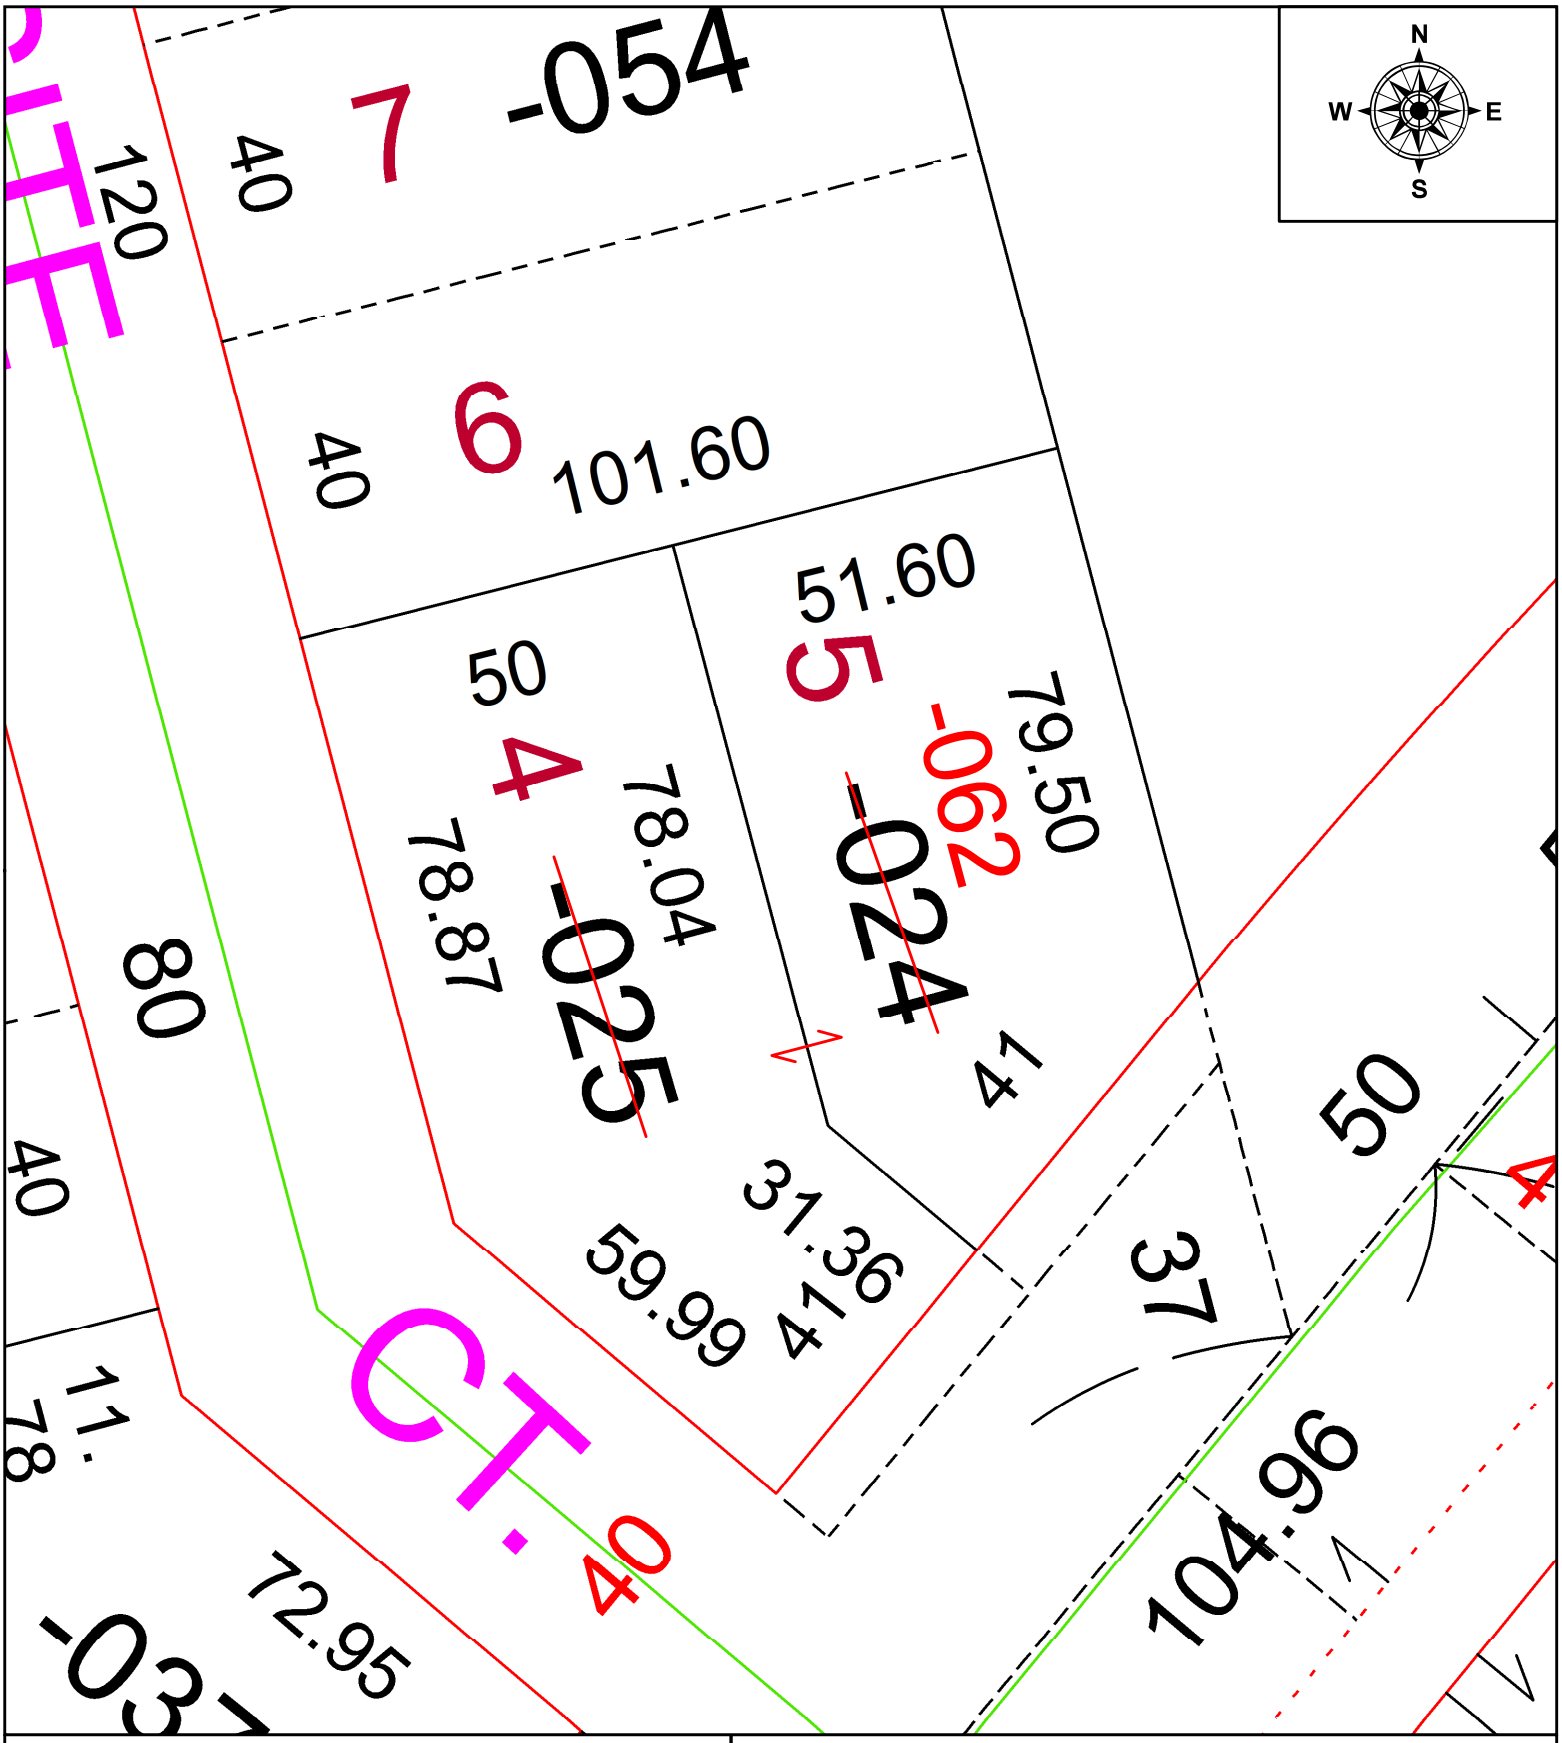

SPLITS/DEEDS PROCESSED

LORAIN COUNTY TAX MAP DEPARTMENT
226 MIDDLE AVE. ELYRIA, OH

SURVEYED BY: N/A **SURV # N/A**

CLOSURE: 1: N/A

MAP PAGE(S): 10-00-003

APPOVED BY: AC **DATE:** November 19, 2025

SCALE: 1 in = 25 ft **PRIOR INSTRUMENT:** 2025- 0062672