PARENT PARCEL: 12-00-059-000-028

CHILD PARCEL: AC CORR PER SURV BY JOHN A. DECHANT JR.

STARTING POINT: C/L OF OSBORNE RD AND JAQUAY

23-05095-A

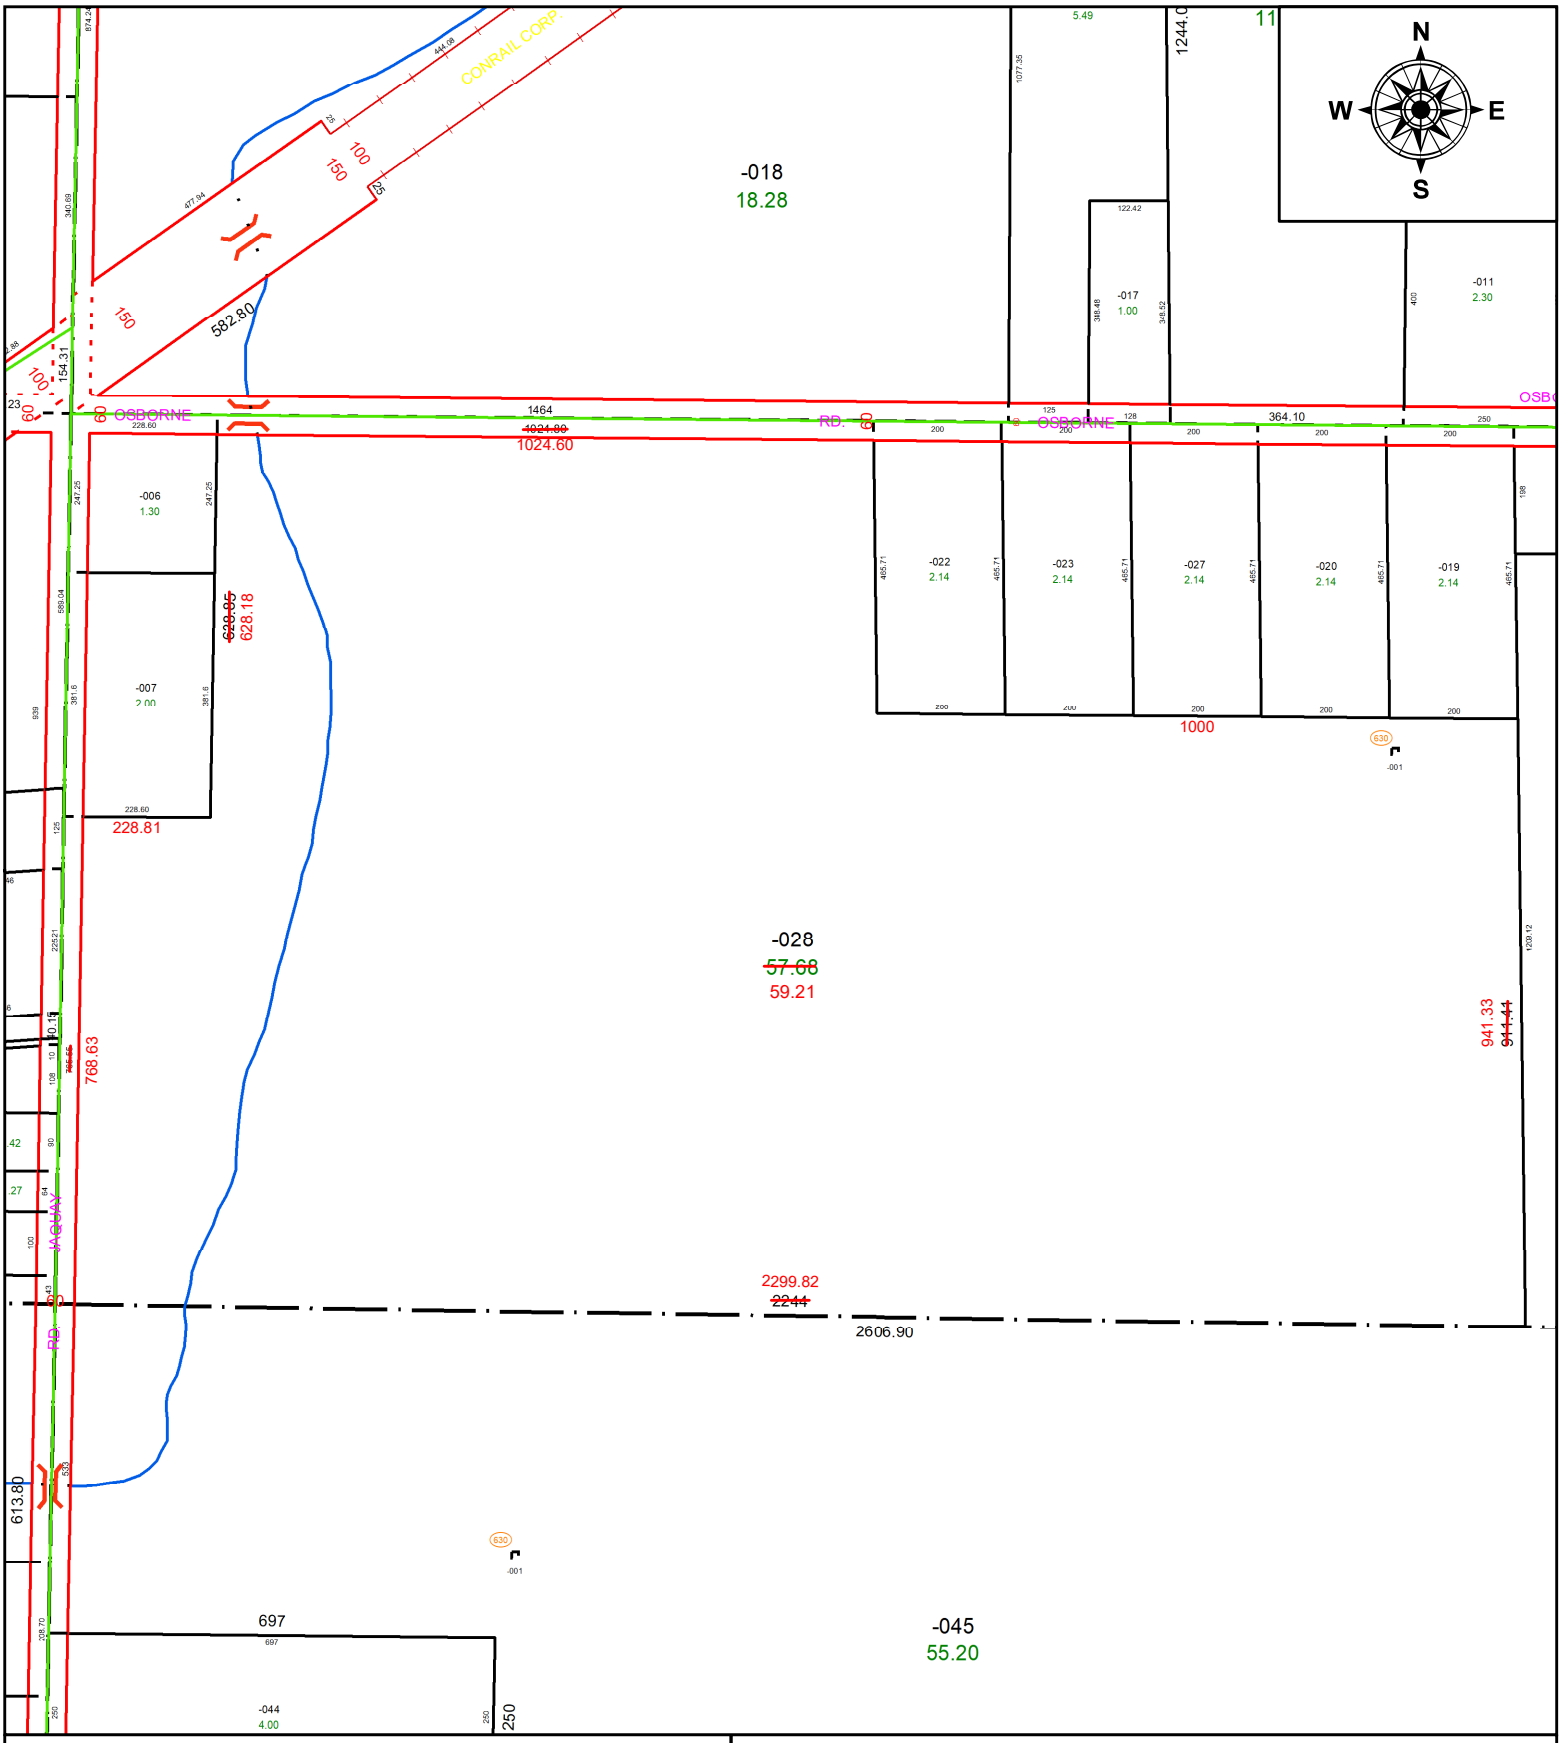

SPLITS/DEEDS PROCESSED

LORAIN COUNTY TAX MAP DEPARTMENT
226 MIDDLE AVE. ELYRIA, OH

SURVEYED BY: JOHN A. DECHANT JR **SURV # 50912**

CLOSURE: 1: 580595

MAP PAGE(S): 12-00-059

APPOVED BY: AC **DATE:** June 07, 2023

SCALE: 1 in = 300 ft **PRIOR INSTRUMENT:** 2021- 0827294