PARENT PARCEL: 18-00-048-000-030 & -031

CHILD PARCEL: 18-00-048-000-032, -033, & -034 AC CORR PER SURVEYOR JAMES ALLEN COTTRELL

STARTING POINT: INTERSECTION OF C/LS OF JONES RD & QUARRY RD

25-05095

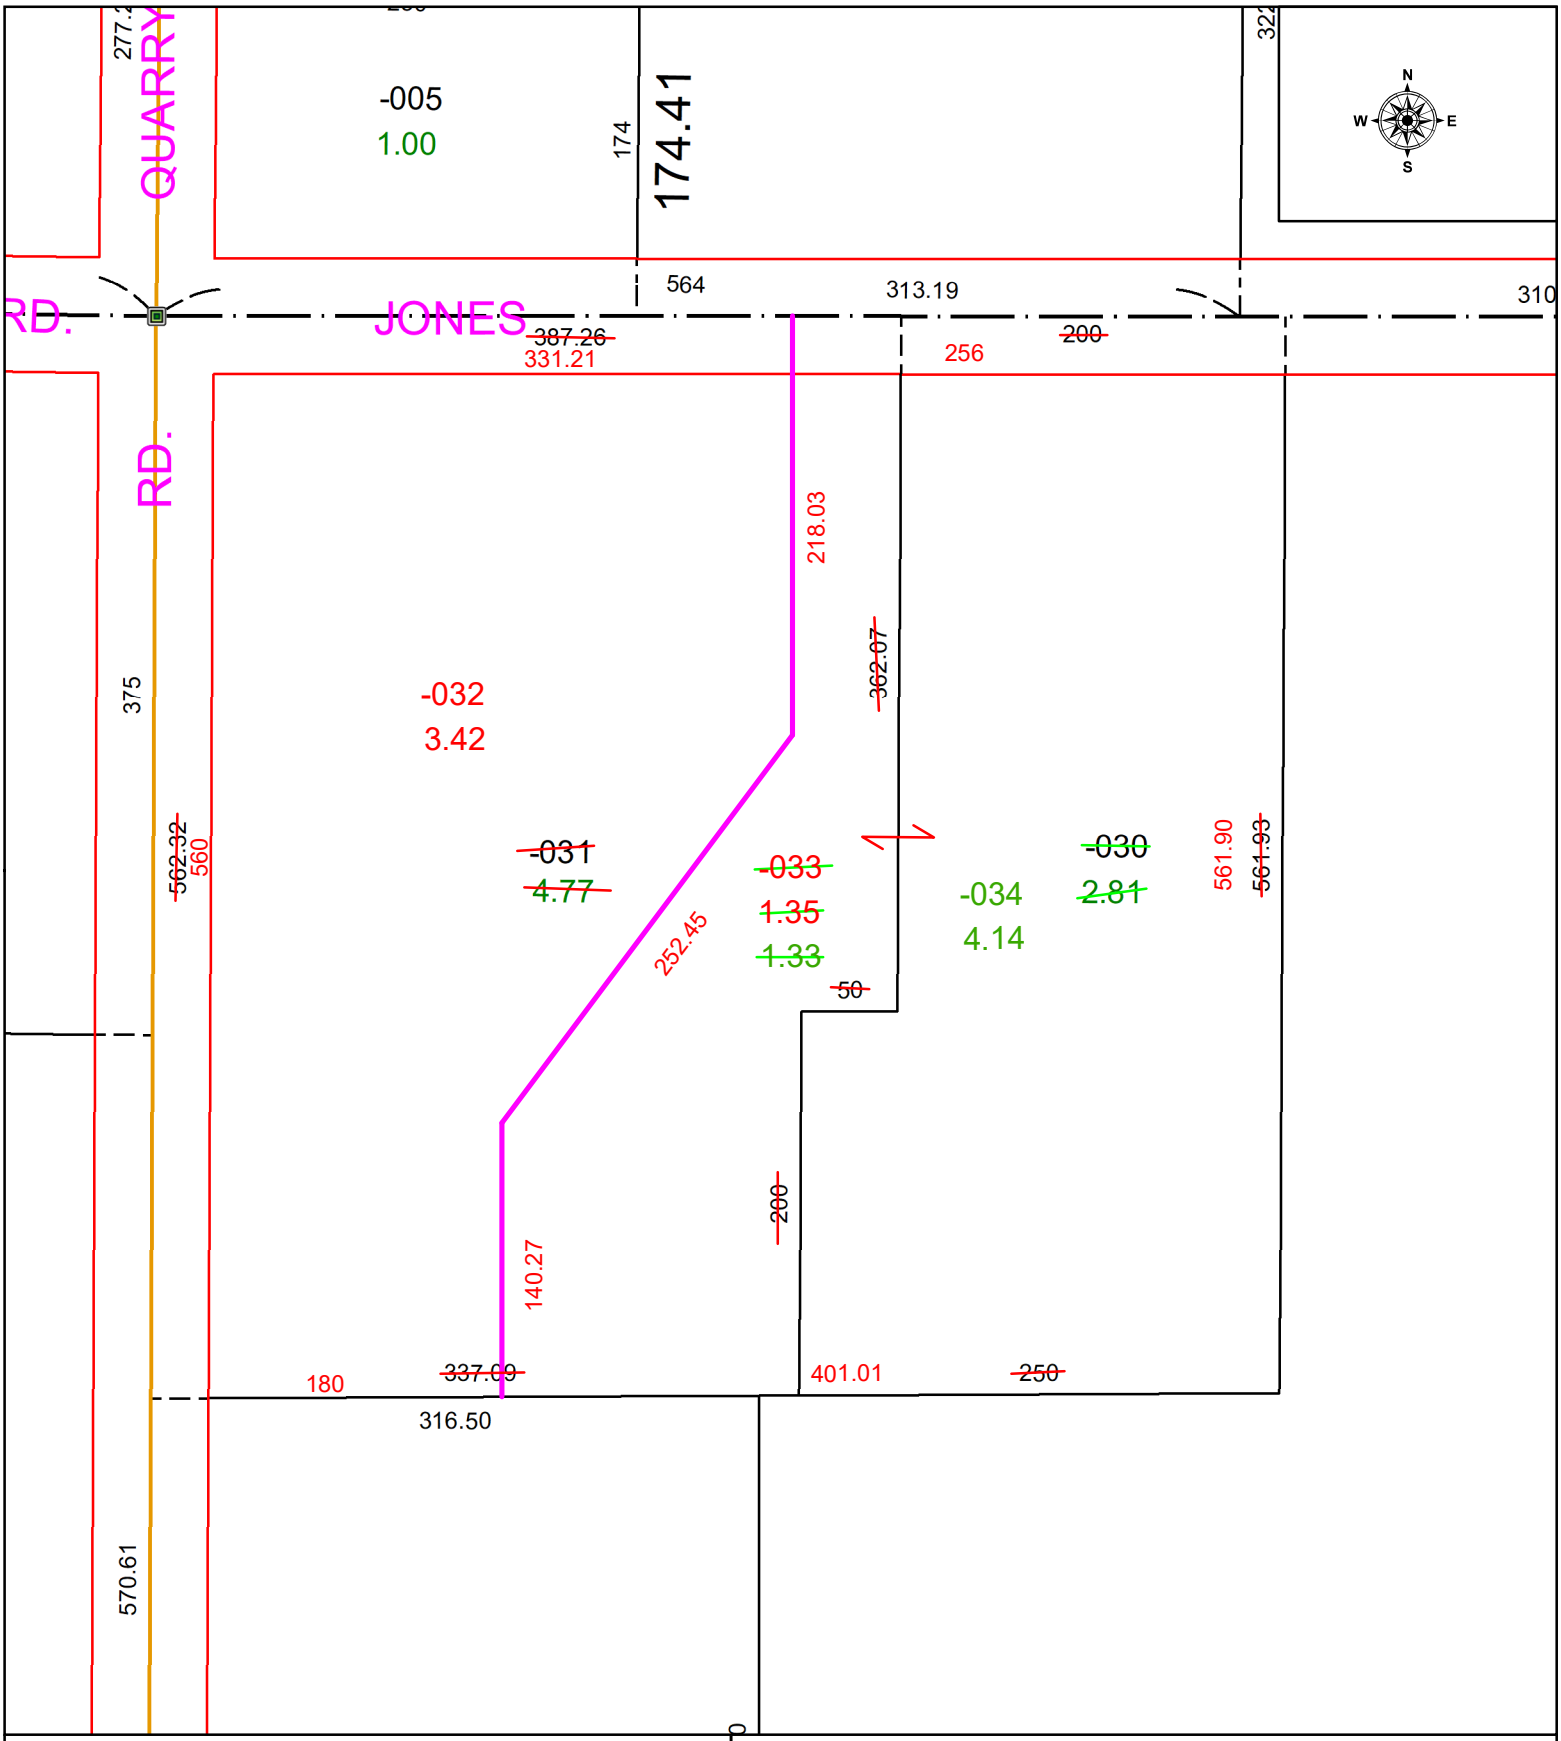

SPLITS/DEEDS PROCESSED

LORAIN COUNTY TAX MAP DEPARTMENT
226 MIDDLE AVE. ELYRIA, OH

SURVEYED BY: JAMES ALLEN COTTRELL SURVEY # 51602

CLOSURE: 1: 344960

MAP PAGE(S): 18-00-048

APPOVED BY: WRZ **DATE:** 11/20/2025

SCALE: 1" = 100 **PRIOR INSTRUMENT:** #2006-0157645