PARENT PARCEL: 05-00-071-000-065

CHILD PARCEL: 05-00-071-000-066 & -067

STARTING POINT: UNCOMBINED DUE TO BEING COMBINED ACROSS TAX DISTRICTS, WHICH ISN'T ALLOWED

23-05096-U

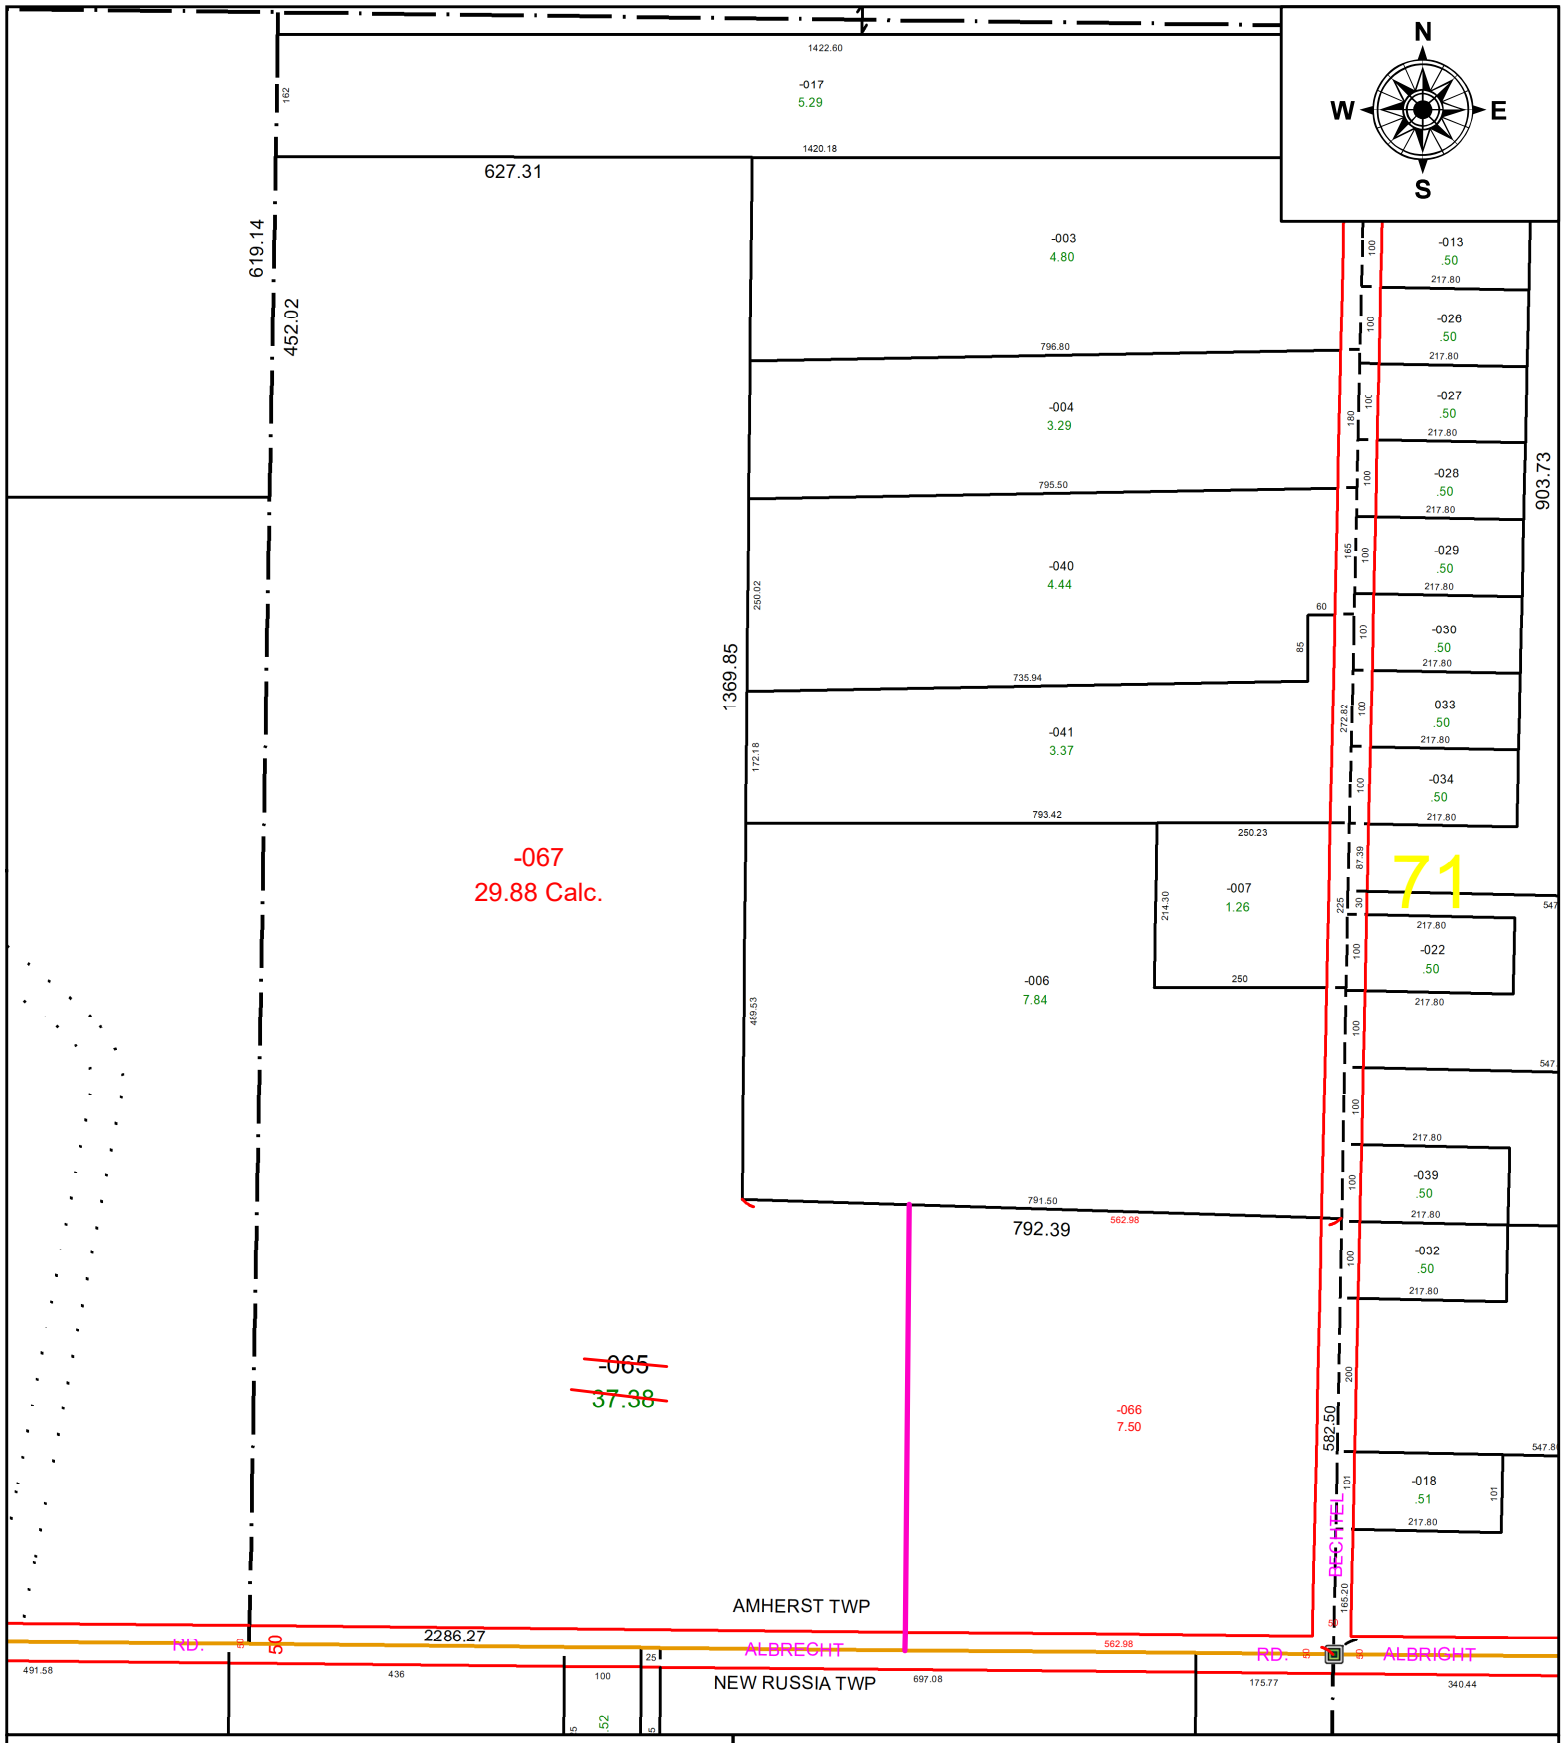

SPLITS/DEEDS PROCESSED

LORAIN COUNTY TAX MAP DEPARTMENT
226 MIDDLE AVE. ELYRIA, OH

SURVEYED BY: N/A **SURVEY #:** N/A

CLOSURE: N/A

MAP PAGE(S): 05-00-071

APPOVED BY: DMA **DATE:** 6/8/2023

SCALE: 1" = 250' **PRIOR INSTRUMENT:** 2018-0670720