PARENT PARCEL: 12-00-051-000-040 & -050

CHILD PARCEL: AC CORR PER SURV BY ROBERT M. RUFFING

STARTING POINT: C/L OF W RIVER RD AND O/L 51

23-05098-A

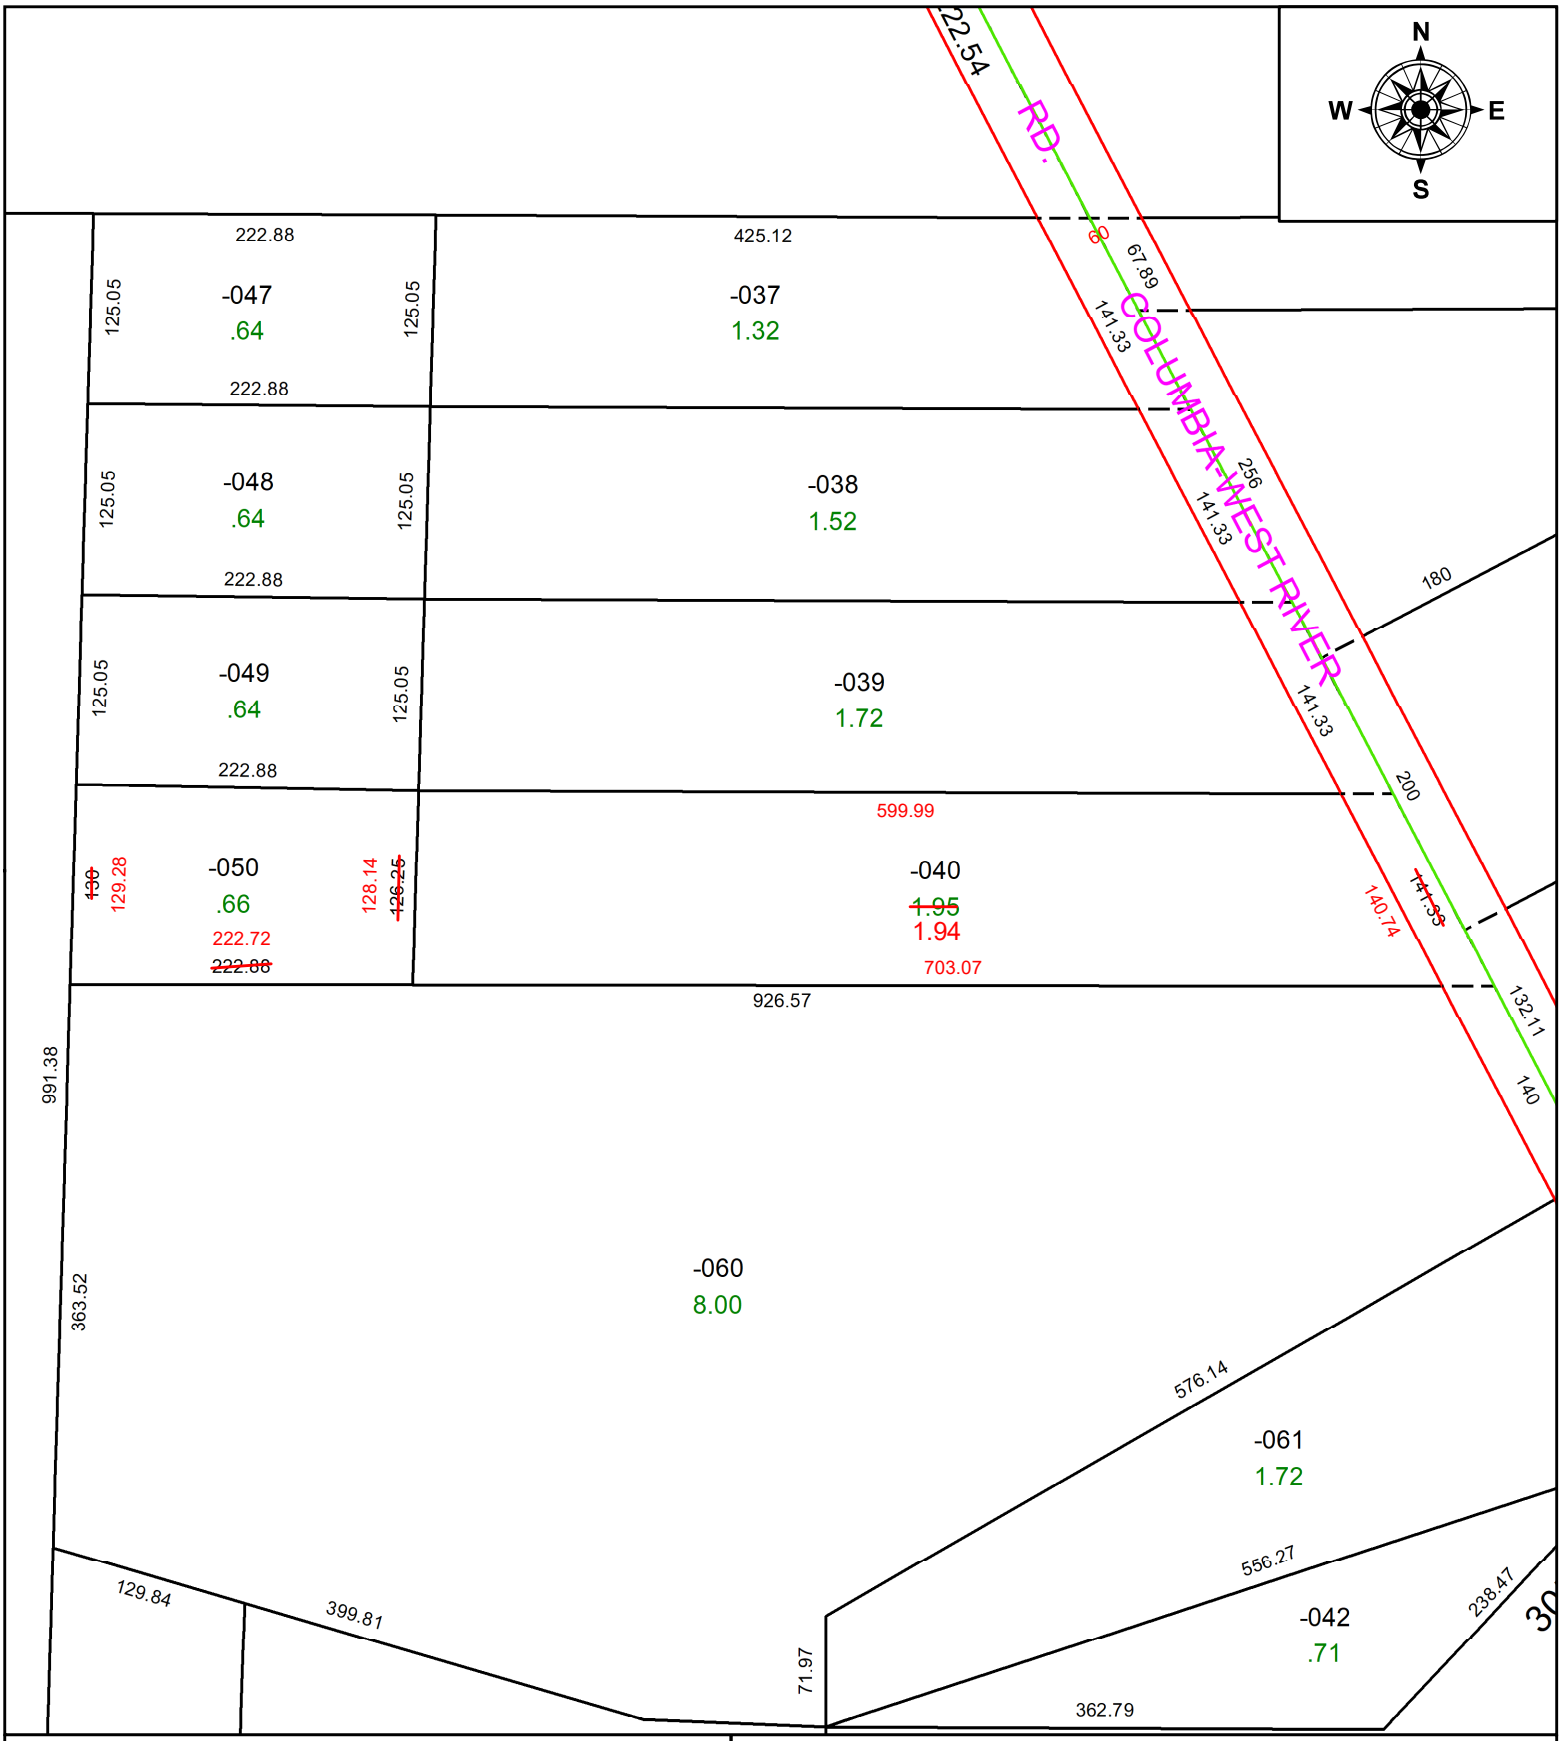

SPLITS/DEEDS PROCESSED

LORAIN COUNTY TAX MAP DEPARTMENT
226 MIDDLE AVE. ELYRIA, OH

SURVEYED BY: ROBERT M. RUFFING **SURV # 50914**

CLOSURE: 1: 576769

MAP PAGE(S): 12-00-051-B

APPOVED BY: AC **DATE:** June 08, 2023

SCALE: 1 in = 125 ft **PRIOR INSTRUMENT:** 2014- 0514699