PARENT PARCEL: 08-13-003-000-007 & -013

CHILD PARCEL: 08-13-003-000-015, -016, & -017

STARTING POINT: SE CORNER OF O/L 3 **AC CORR PER SURV BY THOMAS A. SIMON**

25-05099

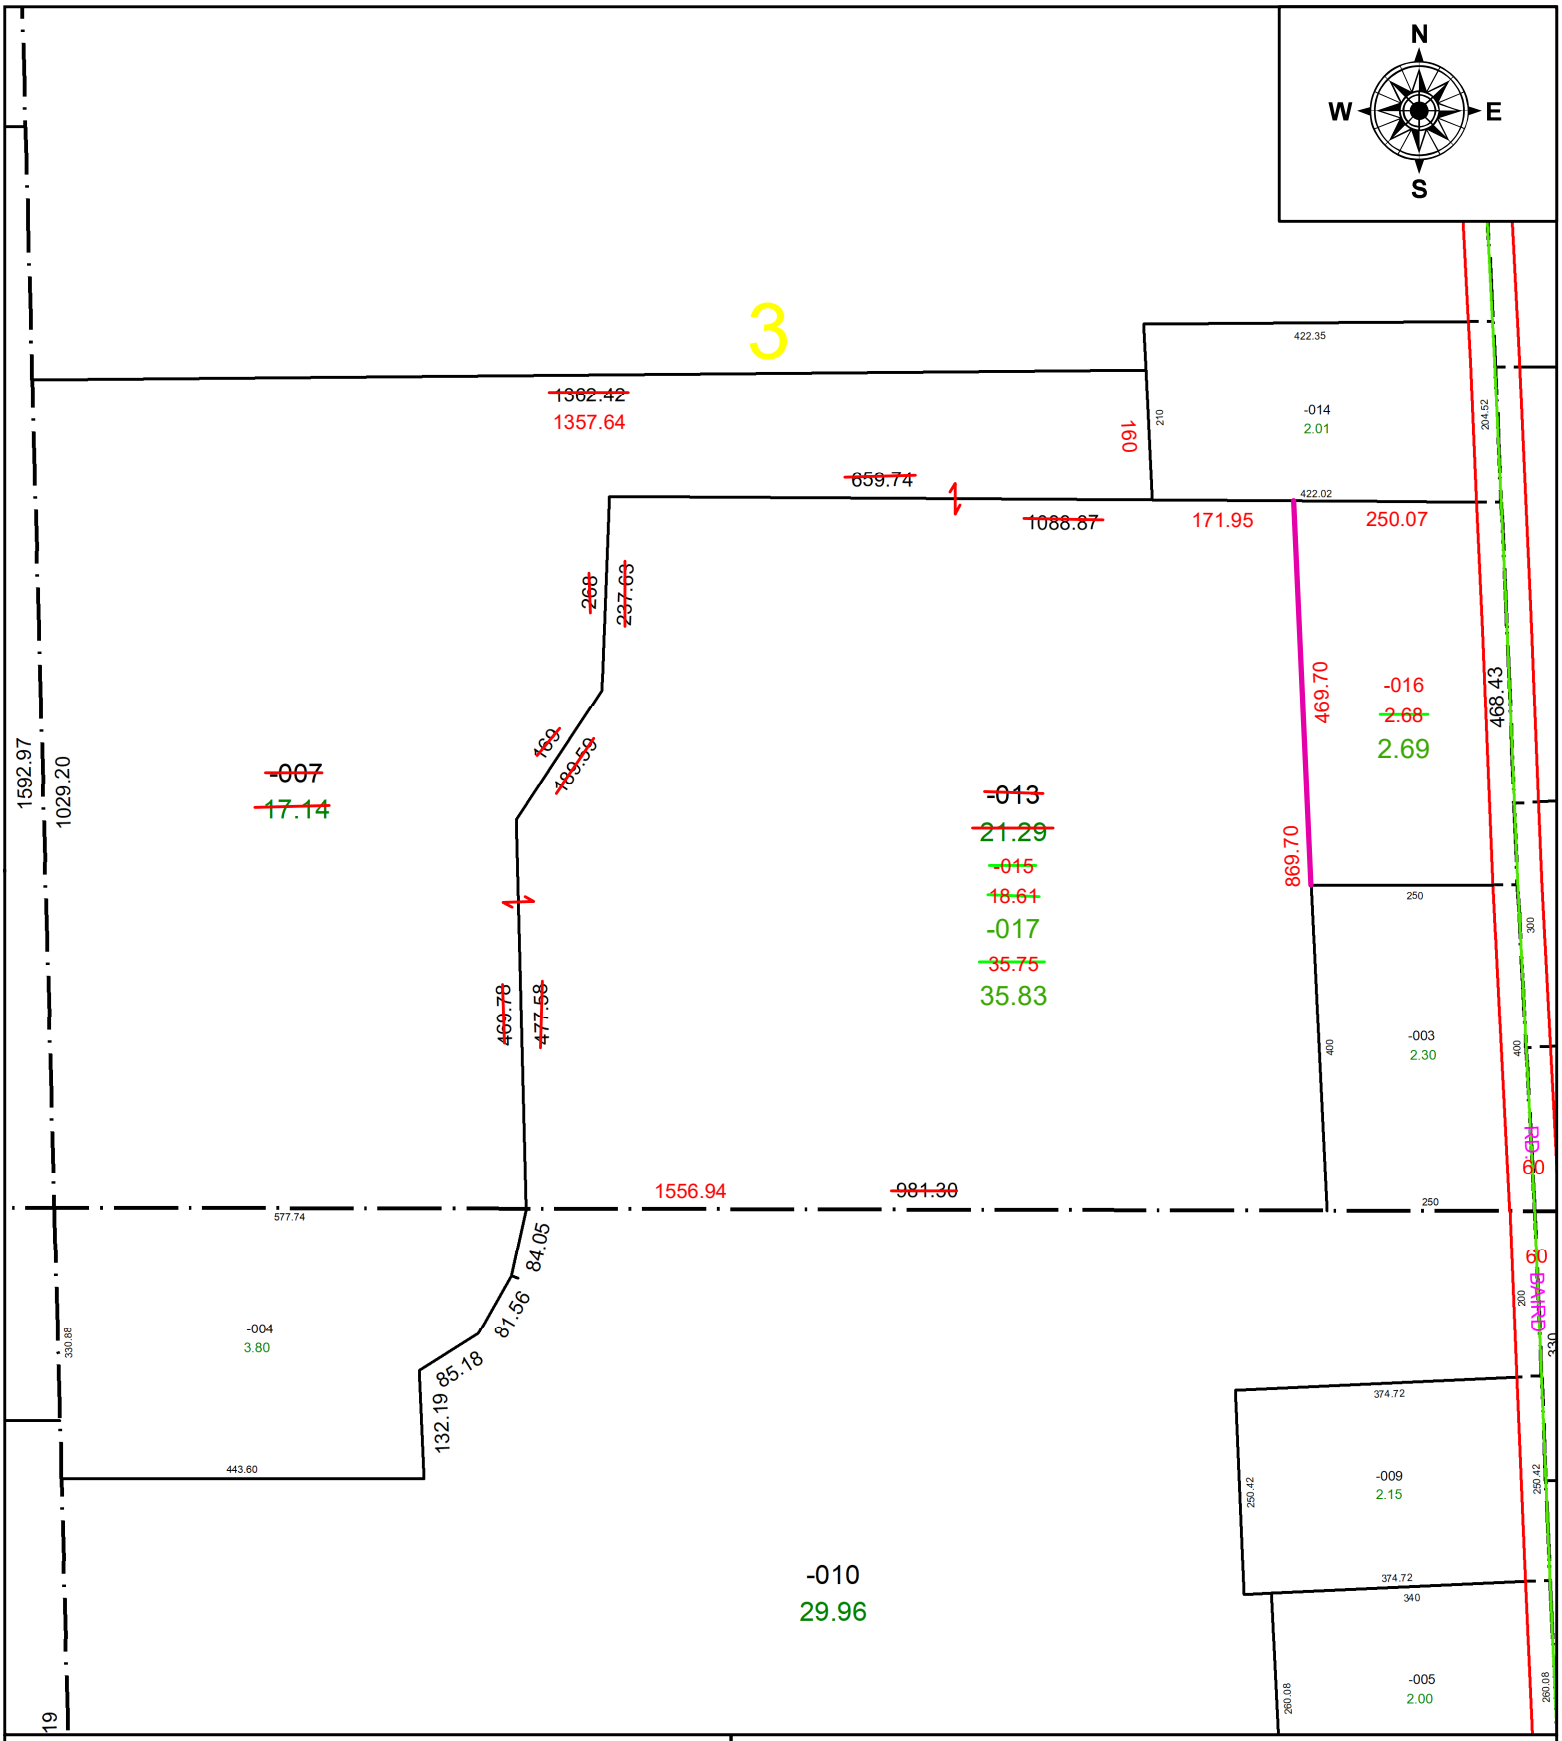

SPLITS/DEEDS PROCESSED

LORAIN COUNTY TAX MAP DEPARTMENT
226 MIDDLE AVE. ELYRIA, OH

SURVEYED BY: THOMAS A. SIMON **SURV # 51605**

CLOSURE: 1: 436069

MAP PAGE(S): 08-13-003

APPOVED BY: AC **DATE:** November 24, 2025

SCALE: 1 in = 235 ft **PRIOR INSTRUMENT:** 2024- 0002819