PARENT PARCEL: 03-00-086-101-018 & 03-00-086-102-019

CHILD PARCEL: AC. CORR.

STARTING POINT: S.W. CORNER S/L 25 SHEFF. LAND CO. ADDITION P.V 4 PG. 23

23-05102-C

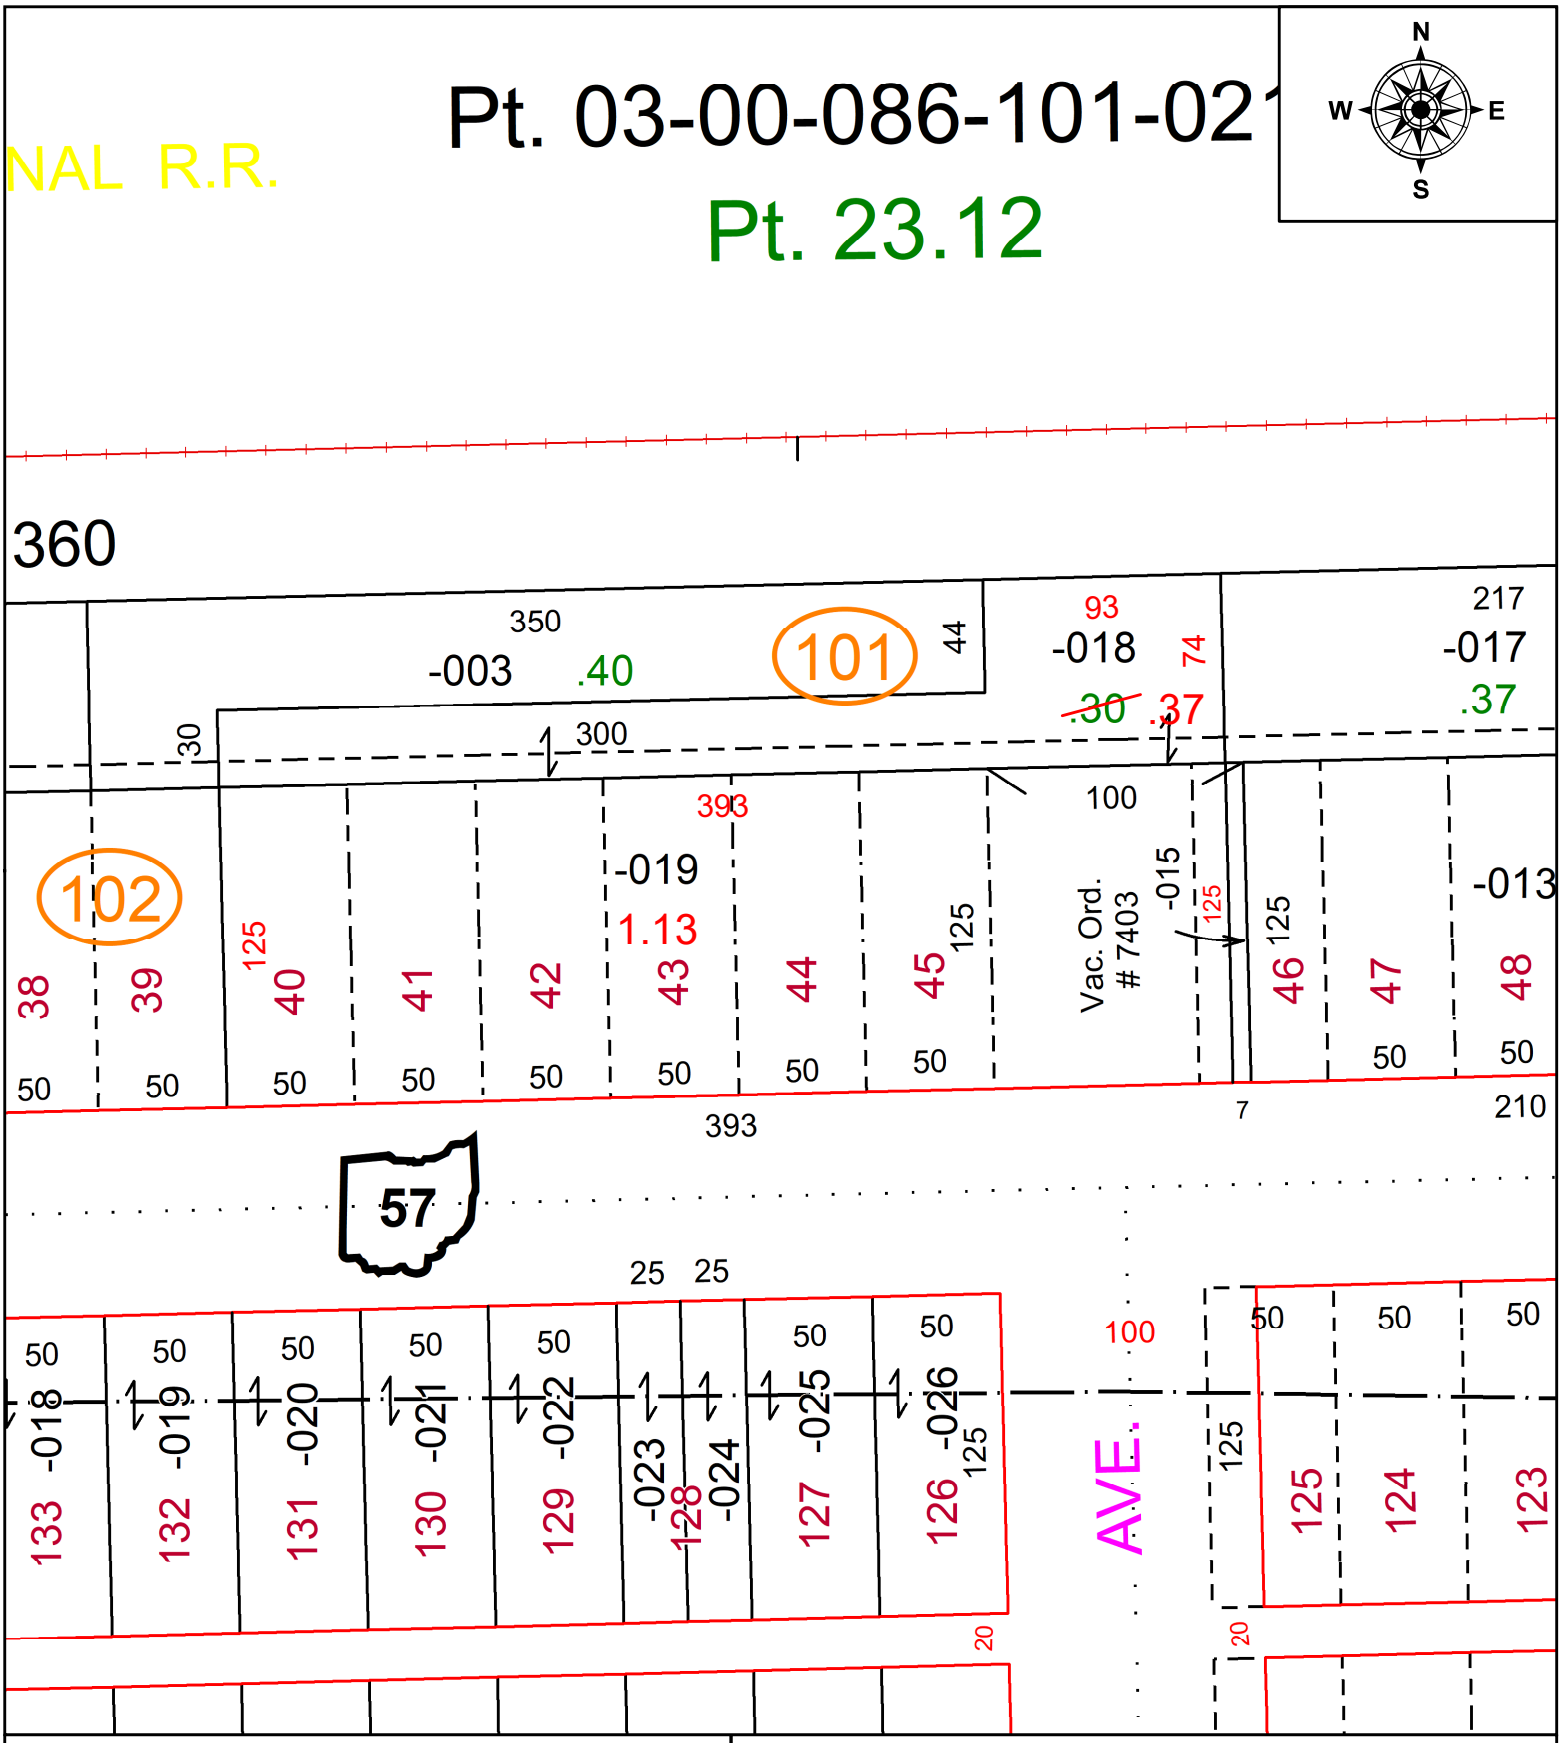

SPLITS/DEEDS PROCESSED

LORAIN COUNTY TAX MAP DEPARTMENT
226 MIDDLE AVE. ELYRIA, OH

SURVEYED BY: ROBERT RUFFING **SURVEY #:** 50923

CLOSURE: 1:-2147483648

MAP PAGE(S): 03-00-086

APPOVED BY: DMA **DATE:** 6/21/2023

SCALE: 1" = 75' **PRIOR INSTRUMENT:** 2020-0773703