PARENT PARCEL: 06-25-036-108-016

CHILD PARCEL: FRONT & DEPTH TO AC CORR PER SURV BY THOMAS A. SIMON

STARTING POINT: INTS. OF WEST LINE OF HARWOOD ST & NORT LINE OF CLEVELAND ST

23-05104-A

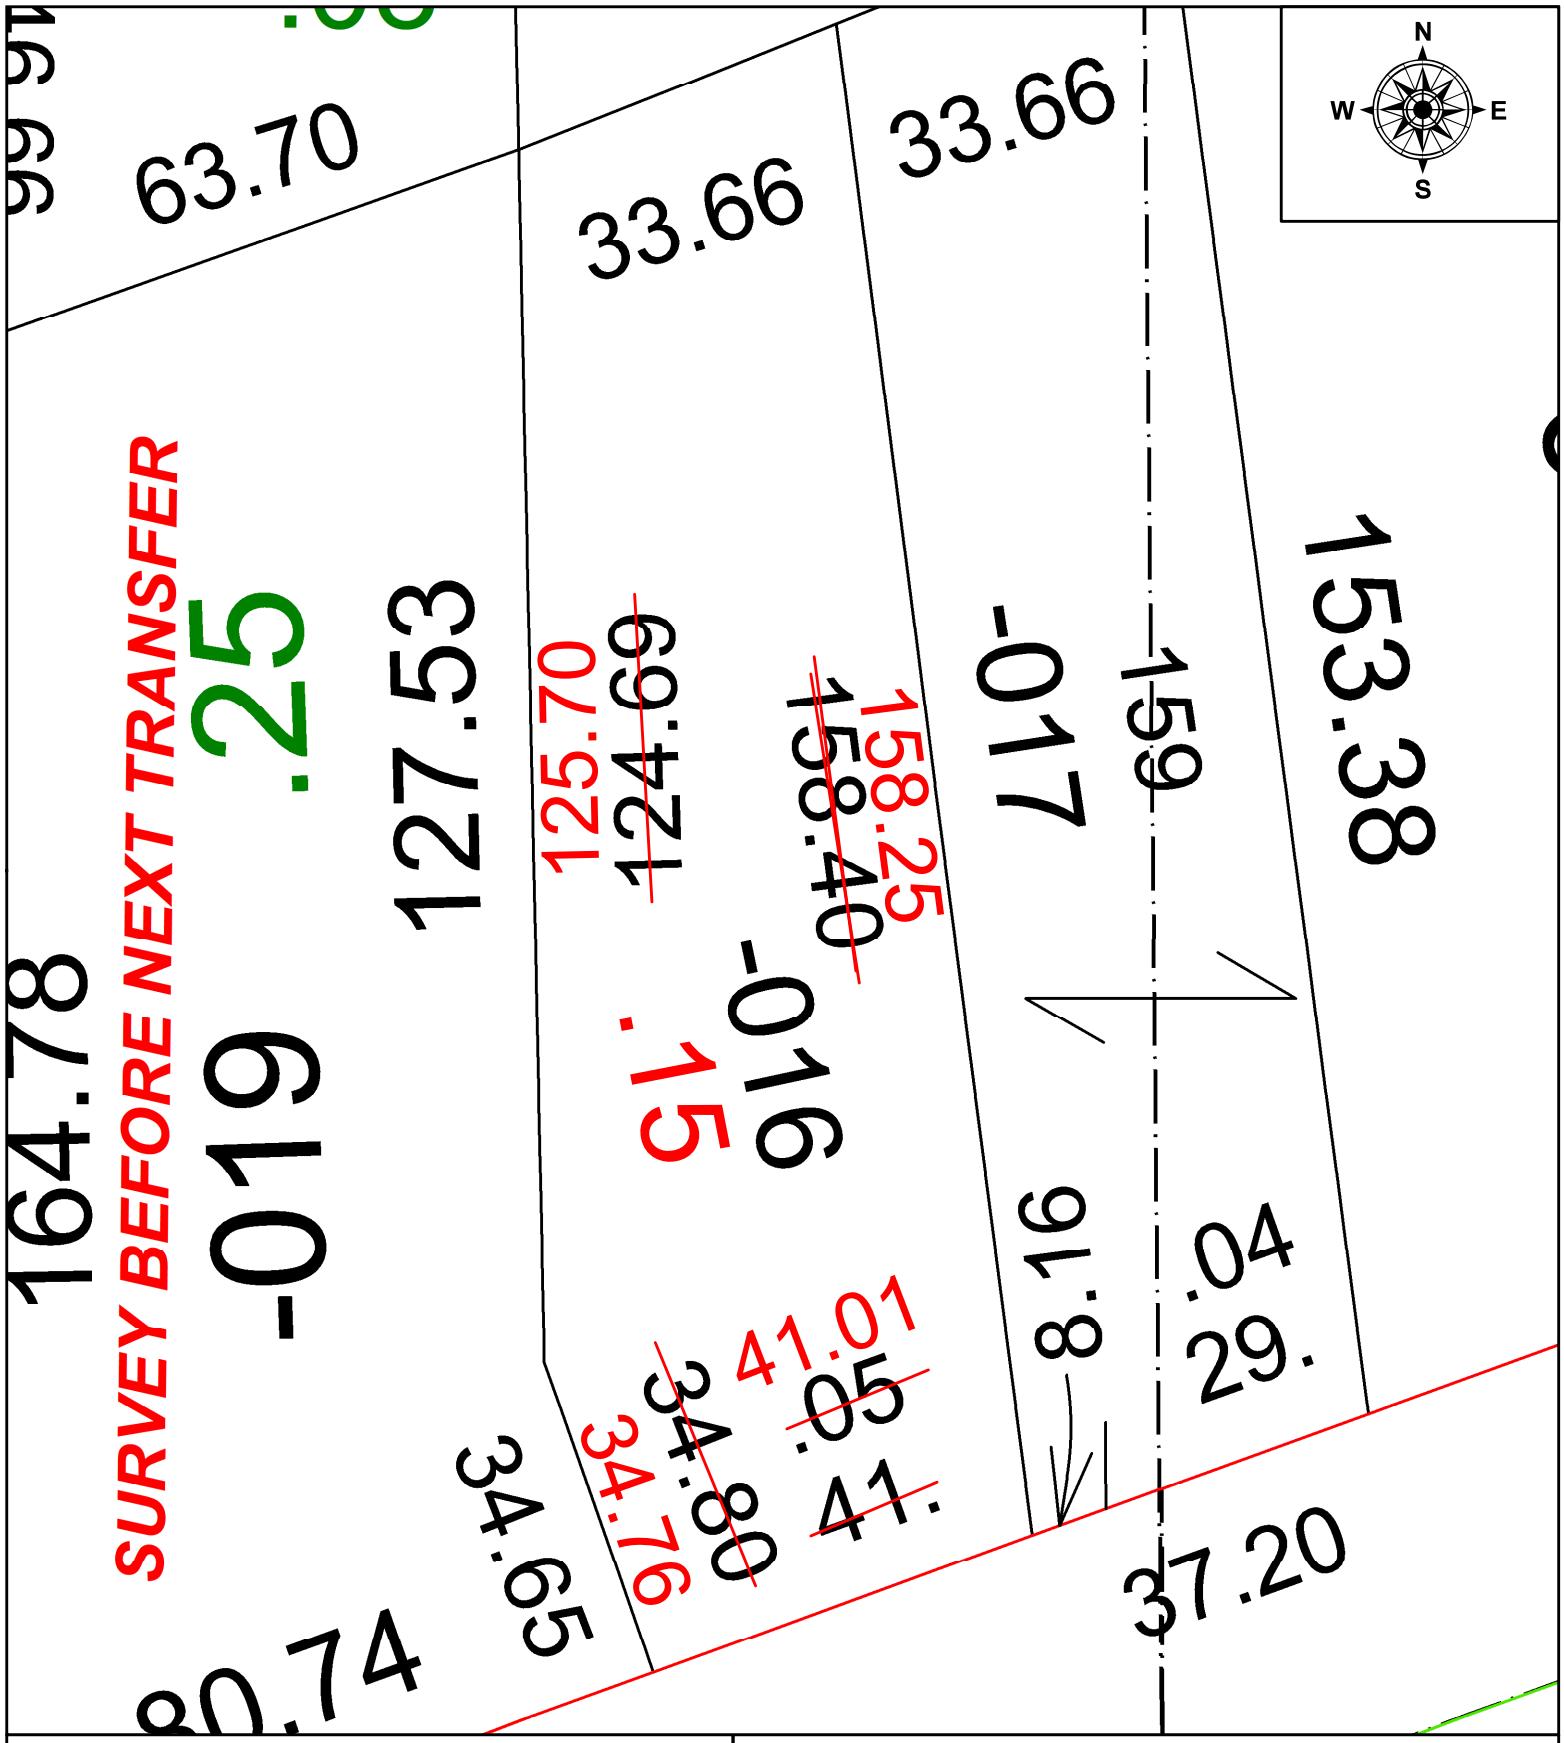

SPLITS/DEEDS PROCESSED

LORAIN COUNTY TAX MAP DEPARTMENT
226 MIDDLE AVE. ELYRIA, OH

SURVEYED BY: THOMAS A. SIMON **SURVEY #:** 50926

CLOSURE: 1: 79,780

MAP PAGE(S): 06-25-036

APPOVED BY: SP **DATE:** 6/22/2023

SCALE: 1" = 20' **PRIOR INSTRUMENT:** 2007-0195338