PARENT PARCEL: 02-01-003-149-017 & -018

CHILD PARCEL:

STARTING POINT: INTERSECTION OF NORTHERLY LINE OF W. 18TH ST & EASTERLY LINE OF BRAMAN CT

23-05105-C

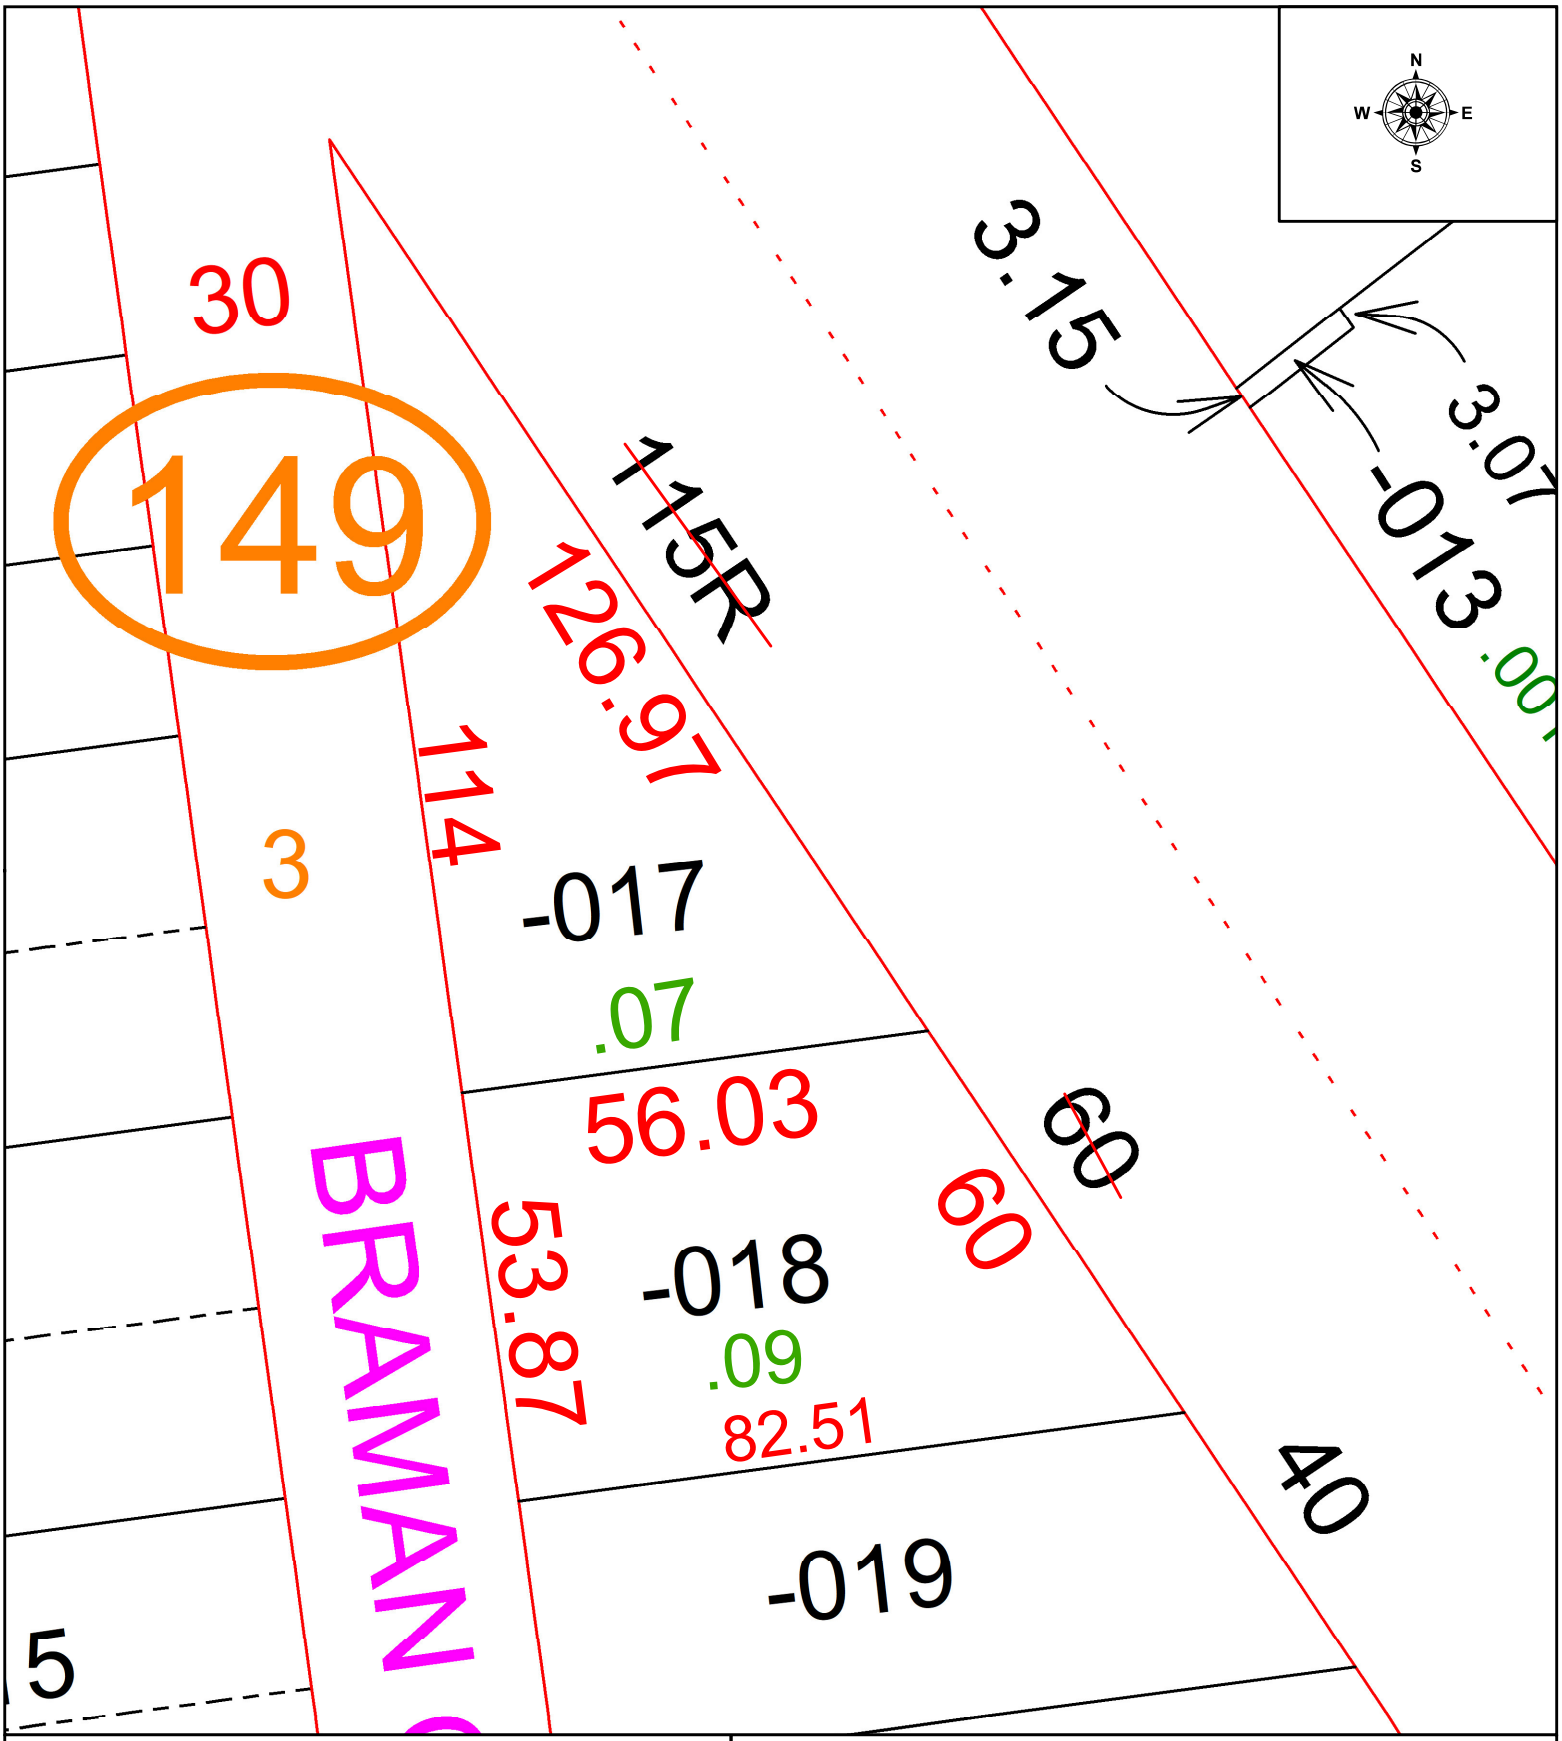

SPLITS/DEEDS PROCESSED

LORAIN COUNTY TAX MAP DEPARTMENT
226 MIDDLE AVE. ELYRIA, OH

SURVEYED BY: THOMAS SIMON SURVEY # 50930
CLOSURE: 1: 37574
MAP PAGE(S): 02-01-003
APPOVED BY: WRZ **DATE:** 6/29/2023
SCALE: 1" = 25 **PRIOR INSTRUMENT:** #2014-0526953