PARENT PARCEL: 18-00-021-112-062, -063, -074, -080, & -103
CHILD PARCEL: 18-00-021-112-112 & -113
STARTING POINT: FRONT, DEPTH, & AC CORR PER SURV BY THOMAS A. SIMON

25-05106

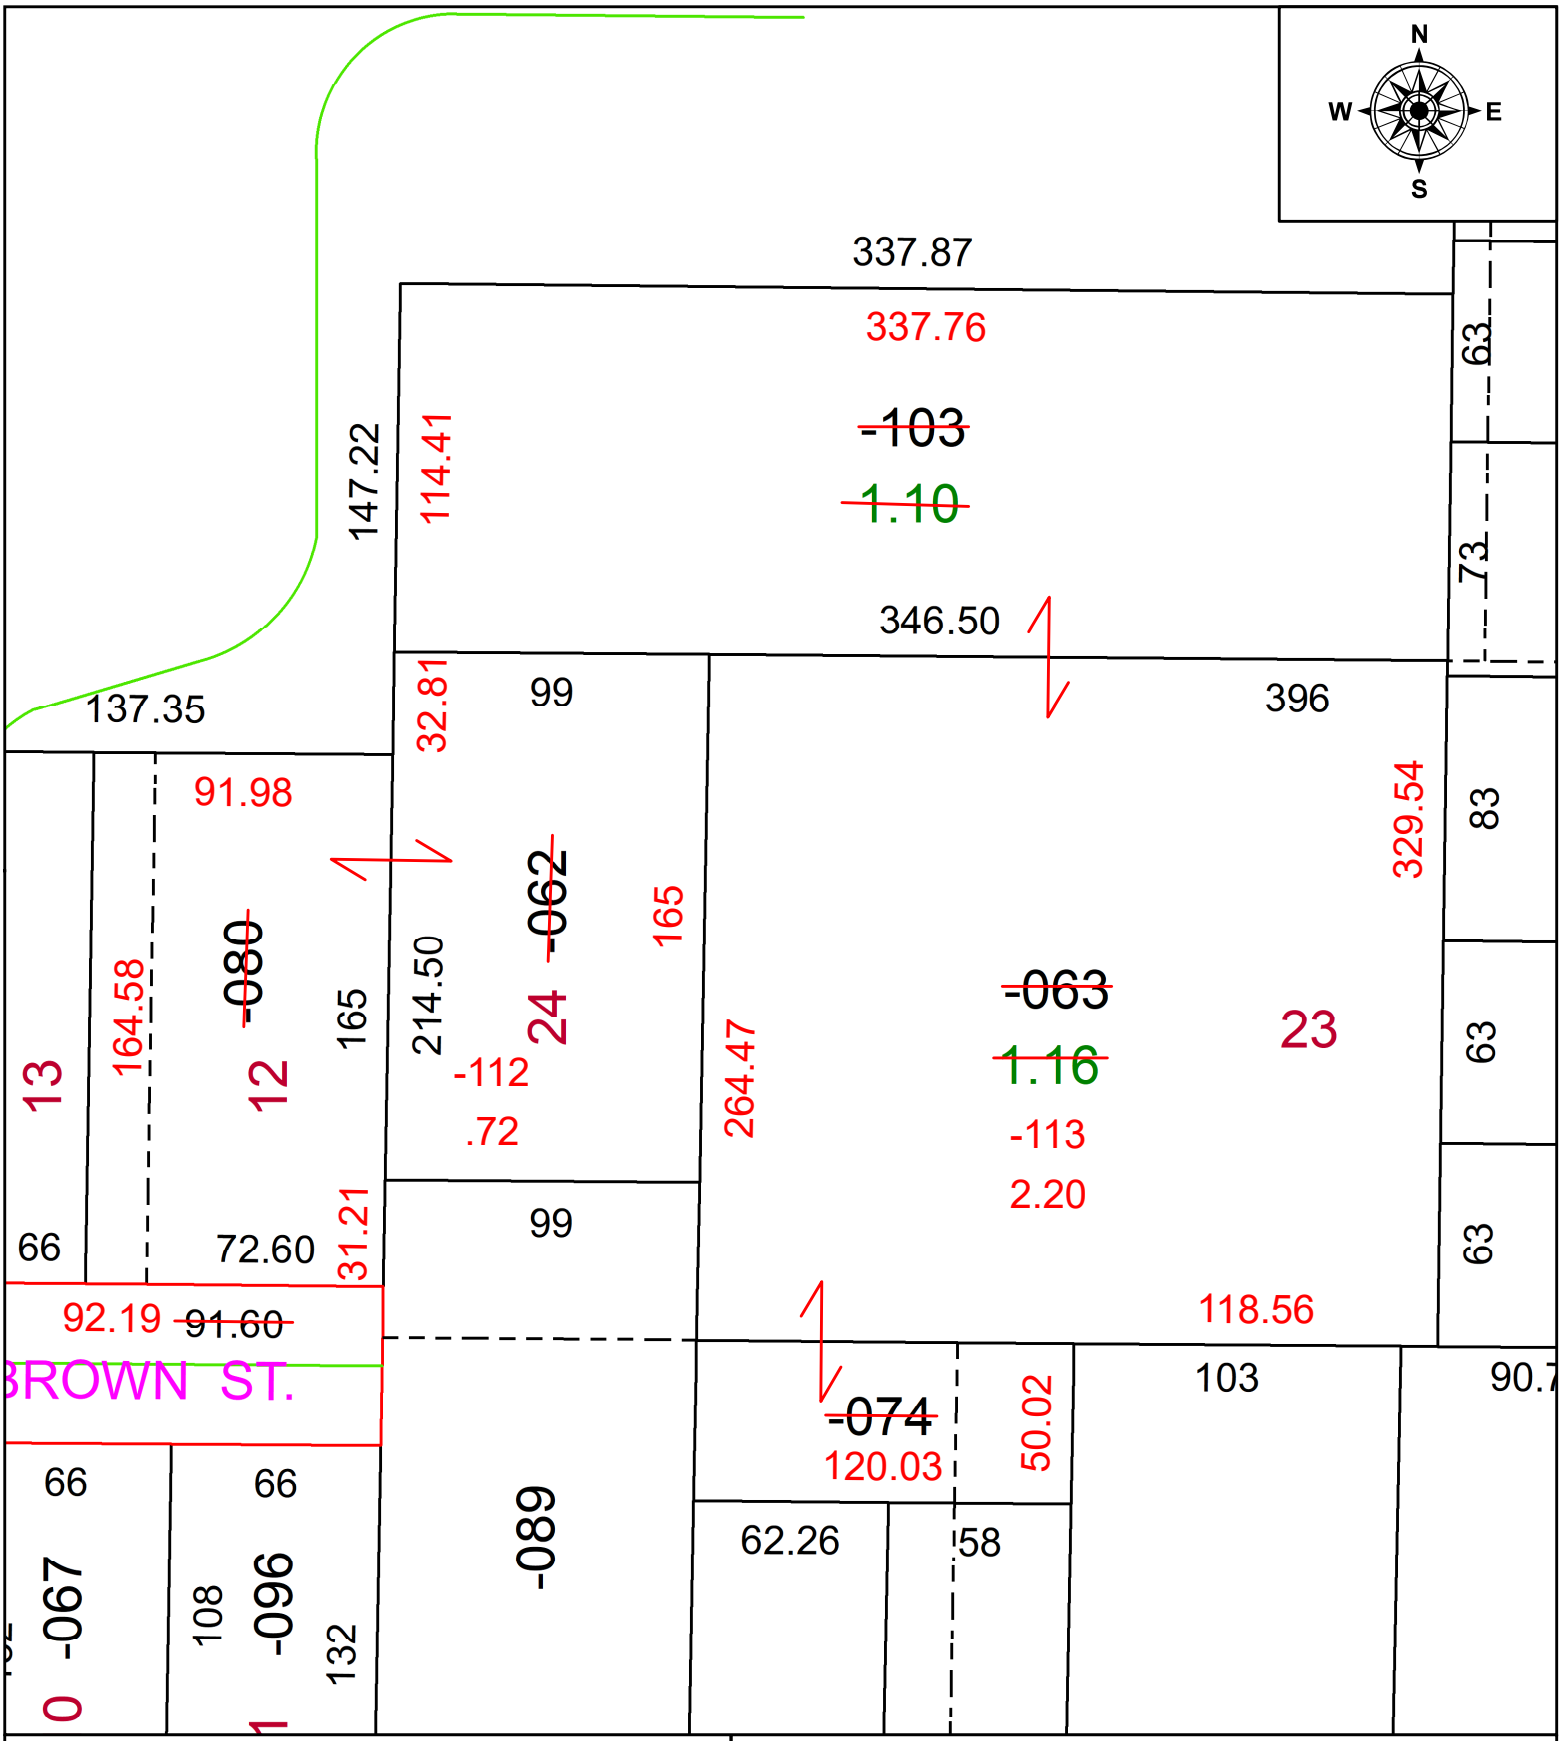

SPLITS/DEEDS PROCESSED
LORAIN COUNTY TAX MAP DEPARTMENT
226 MIDDLE AVE. ELYRIA, OH

SURVEYED BY: THOMAS A. SIMON **SURV # 51617**
CLOSURE: 1: 214764
MAP PAGE(S): 18-00-021
APPOVED BY: AC **DATE:** December 08, 2025
SCALE: 1 in = 60 ft **PRIOR INSTRUMENT:** 2010- 0350243