PARENT PARCEL: 04-00-014-107-268

CHILD PARCEL: 04-00-014-107-296 & -297

STARTING POINT: AC CORR PER SURV BY MICHAEL P. SPELLACY

26-05114

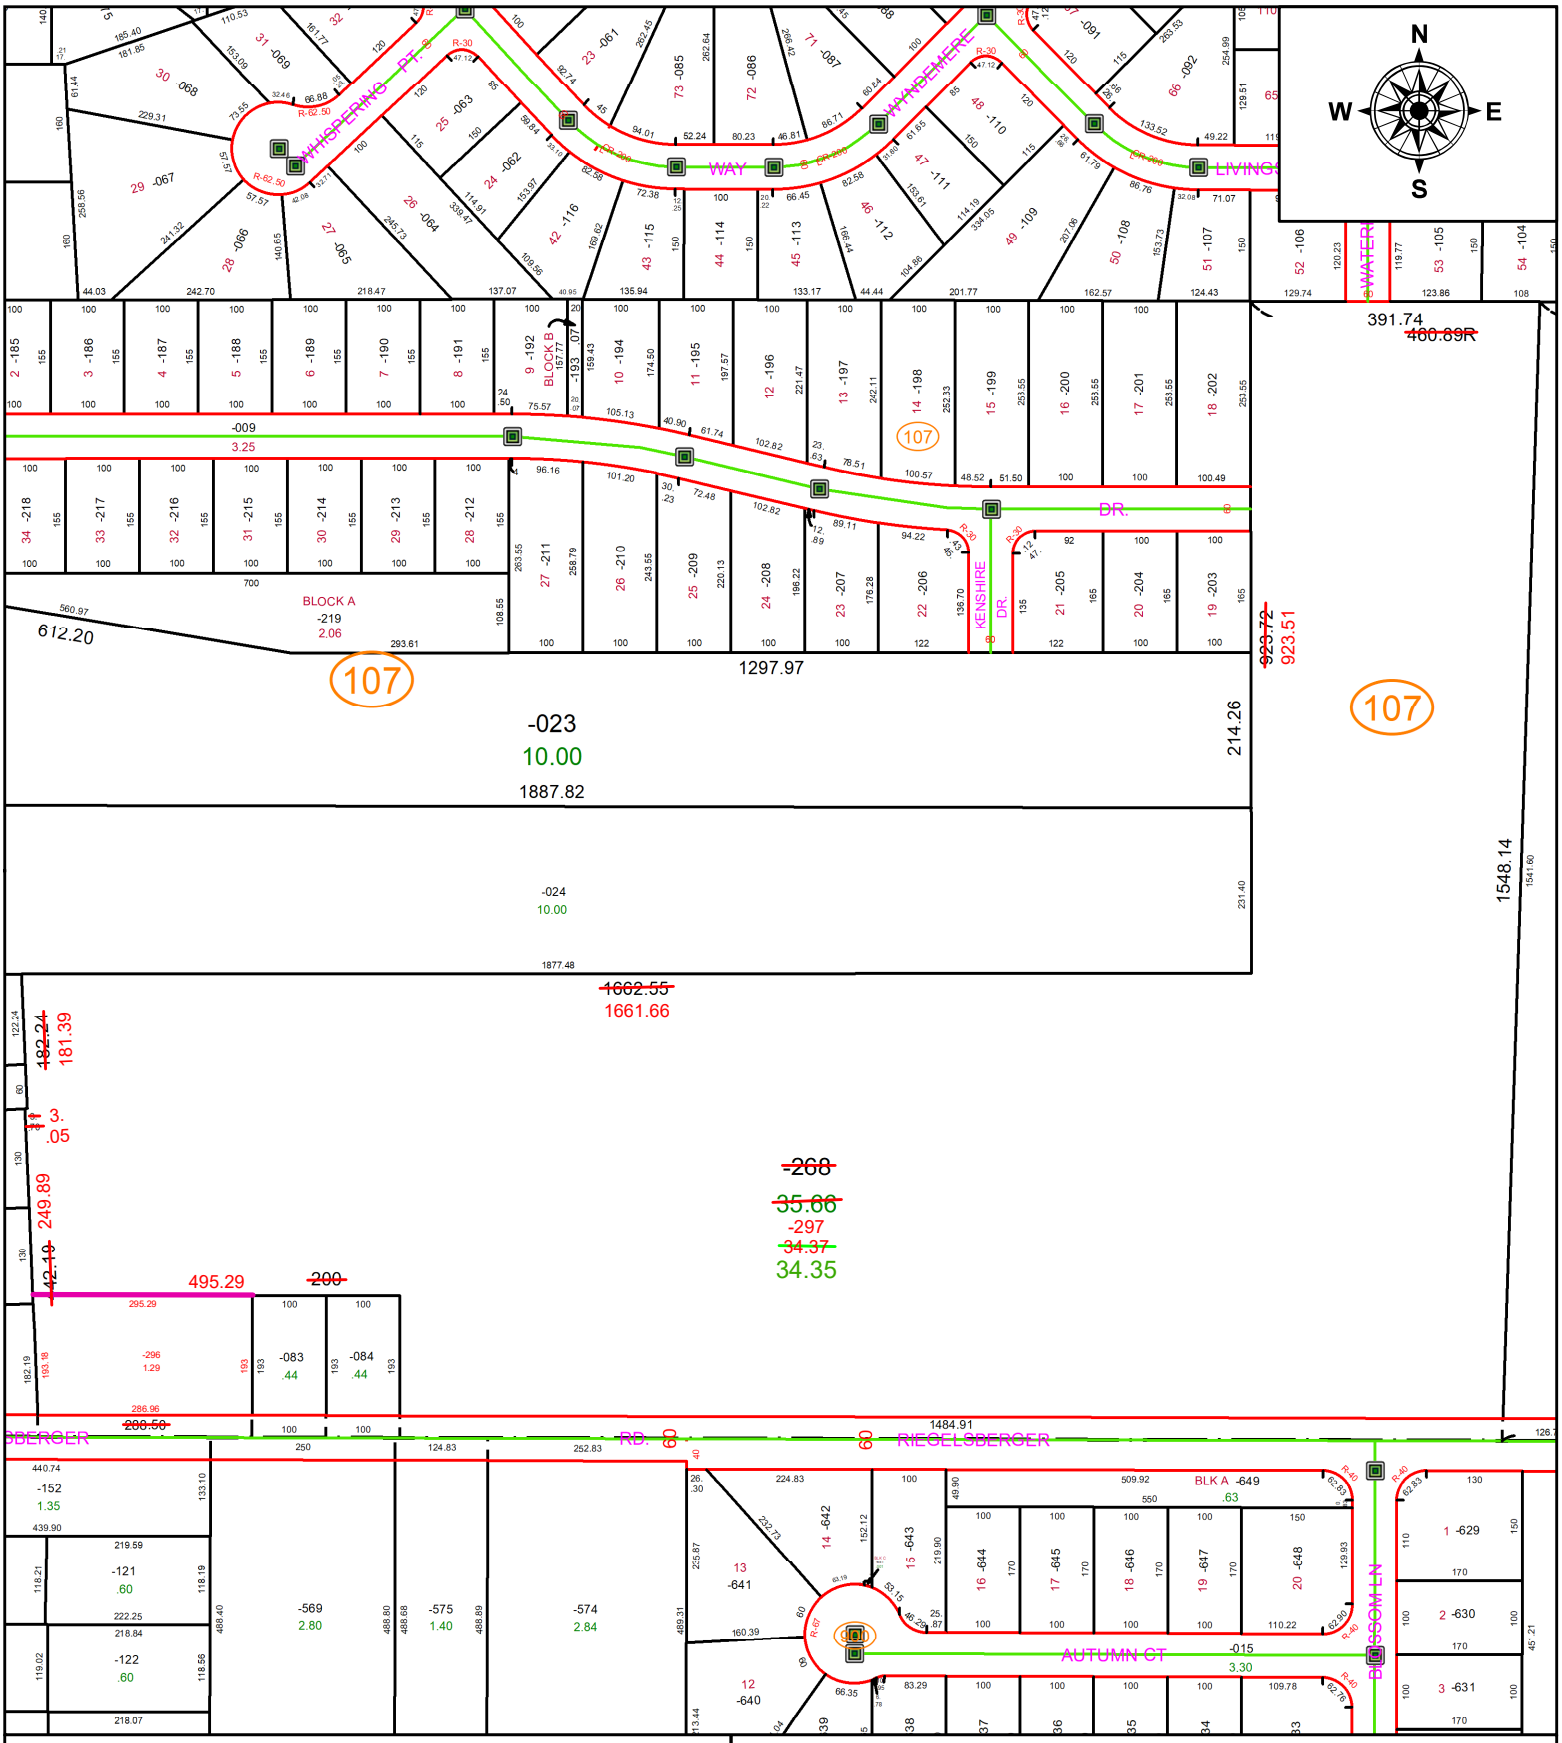

SPLITS/DEEDS PROCESSED

LORAIN COUNTY TAX MAP DEPARTMENT
226 MIDDLE AVE. ELYRIA, OH

SURVEYED BY: MICHAEL P. SPELLACY **SURV # 51639**

CLOSURE: 1: 172189

MAP PAGE(S): 04-00-014

APPOVED BY: AC **DATE:** January 16, 2026

SCALE: 1 in = 260 ft **PRIOR INSTRUMENT:** 2021- 0845718