PARENT PARCEL: 04-00-016-101-006 & -007

CHILD PARCEL: 04-00-016-101-228

STARTING POINT: C/L OF SCHNEIDER CT AND CENTER RD

26-05117

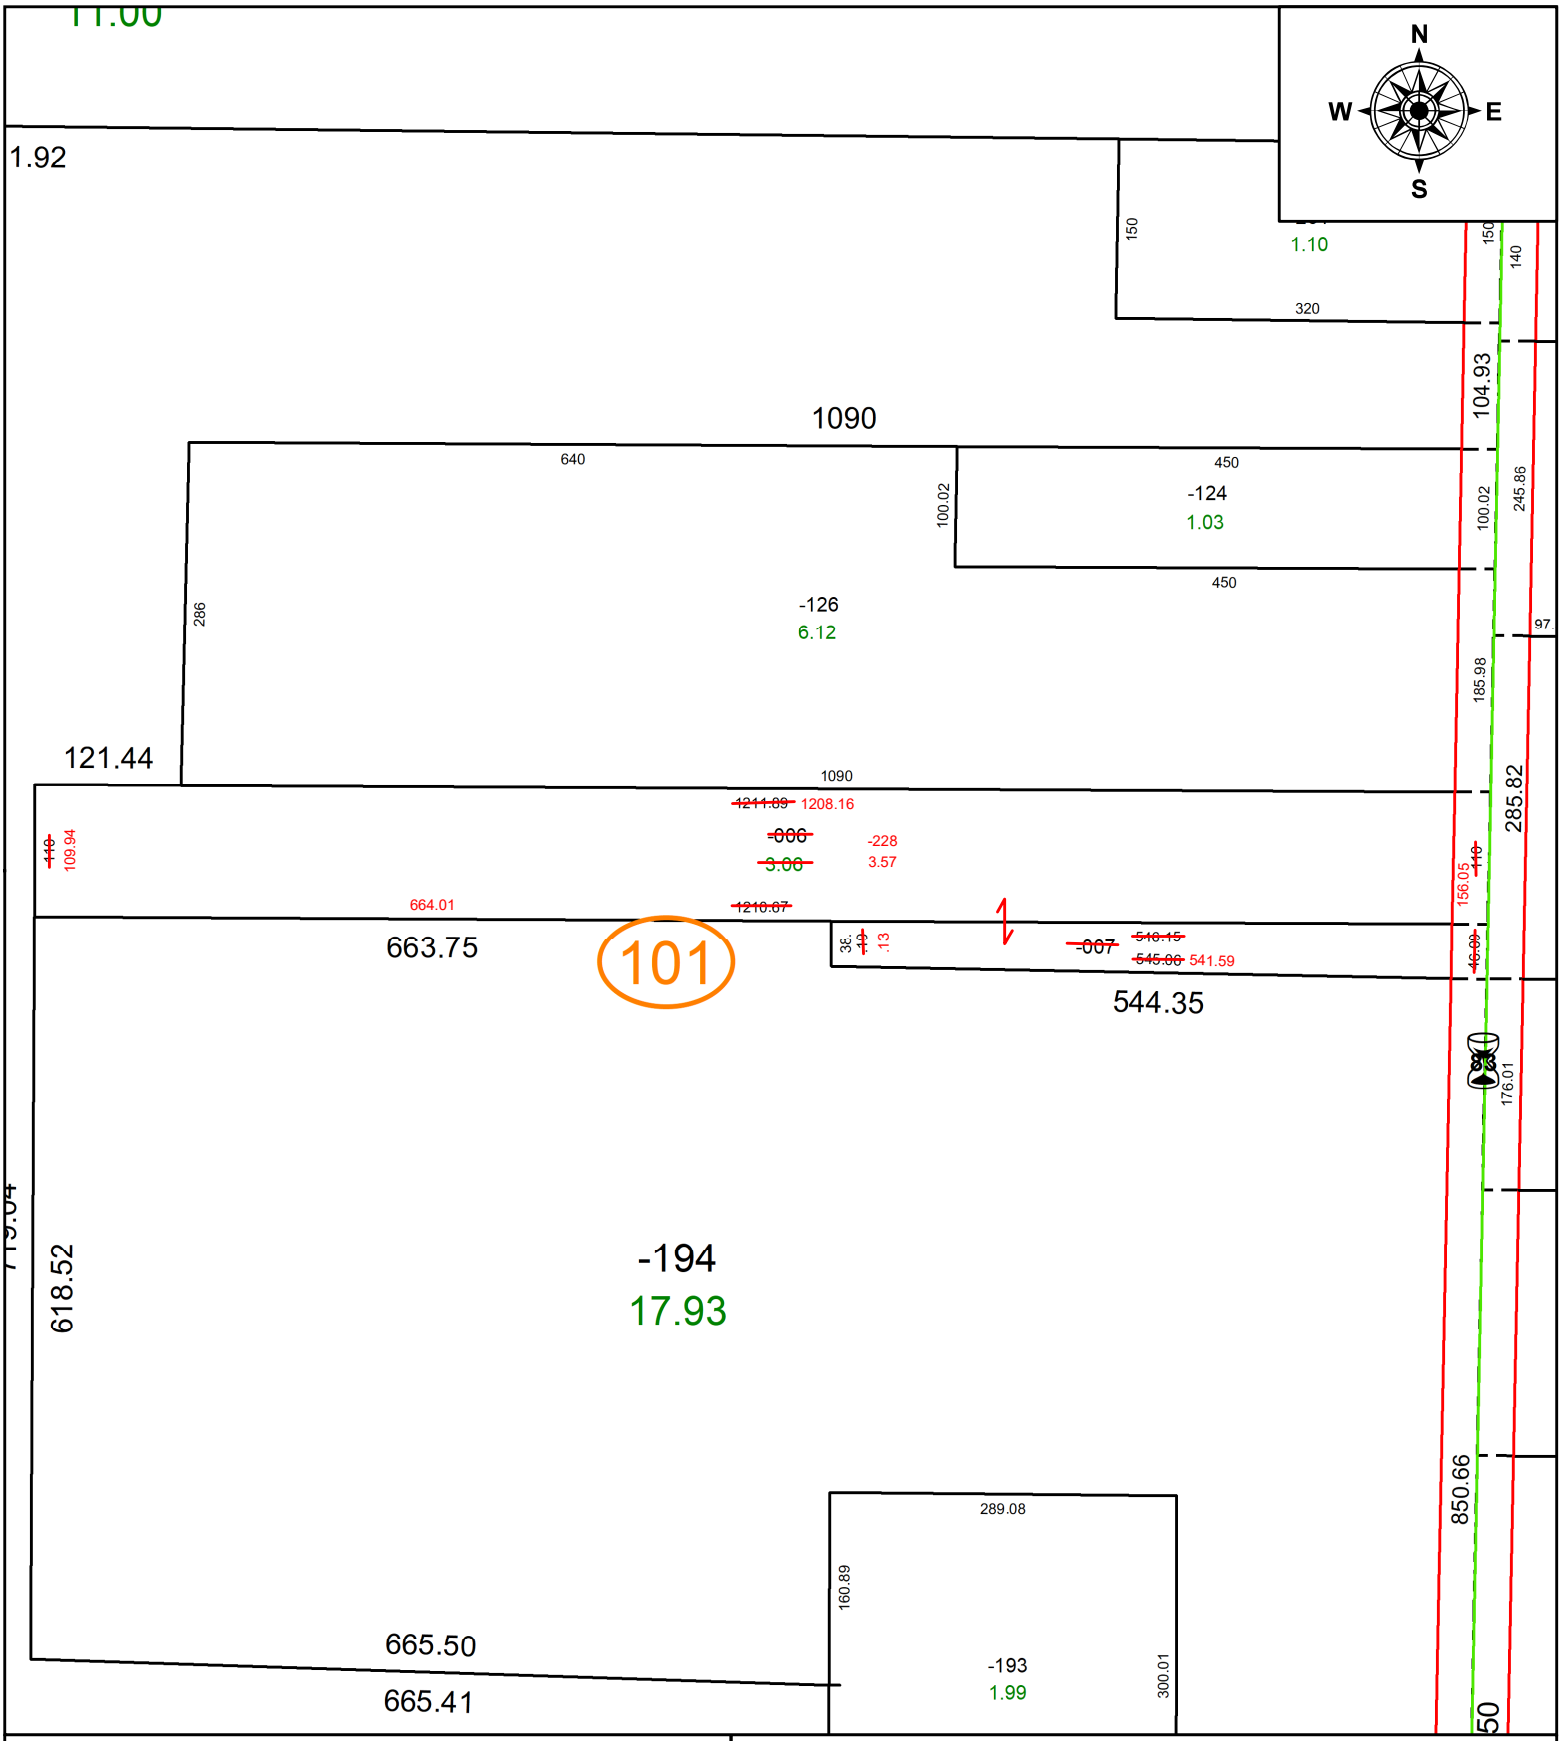

SPLITS/DEEDS PROCESSED

LORAIN COUNTY TAX MAP DEPARTMENT
226 MIDDLE AVE. ELYRIA, OH

SURVEYED BY: AMY M. KELLY **SURV # 51637**

CLOSURE: 1: 100000

MAP PAGE(S): 04-00-016

APPOVED BY: AC **DATE:** January 16, 2026

SCALE: 1 in = 160 ft **PRIOR INSTRUMENT:** 2026- 0080824