PARENT PARCEL: 05-00-032-000-106

CHILD PARCEL: 05-00-032-000-106 & 05-00-033-000-071

STARTING POINT: UNCOMBINATION AND AC CORR PER SURV BY WILFREDO BARBOSA

23-05120-A

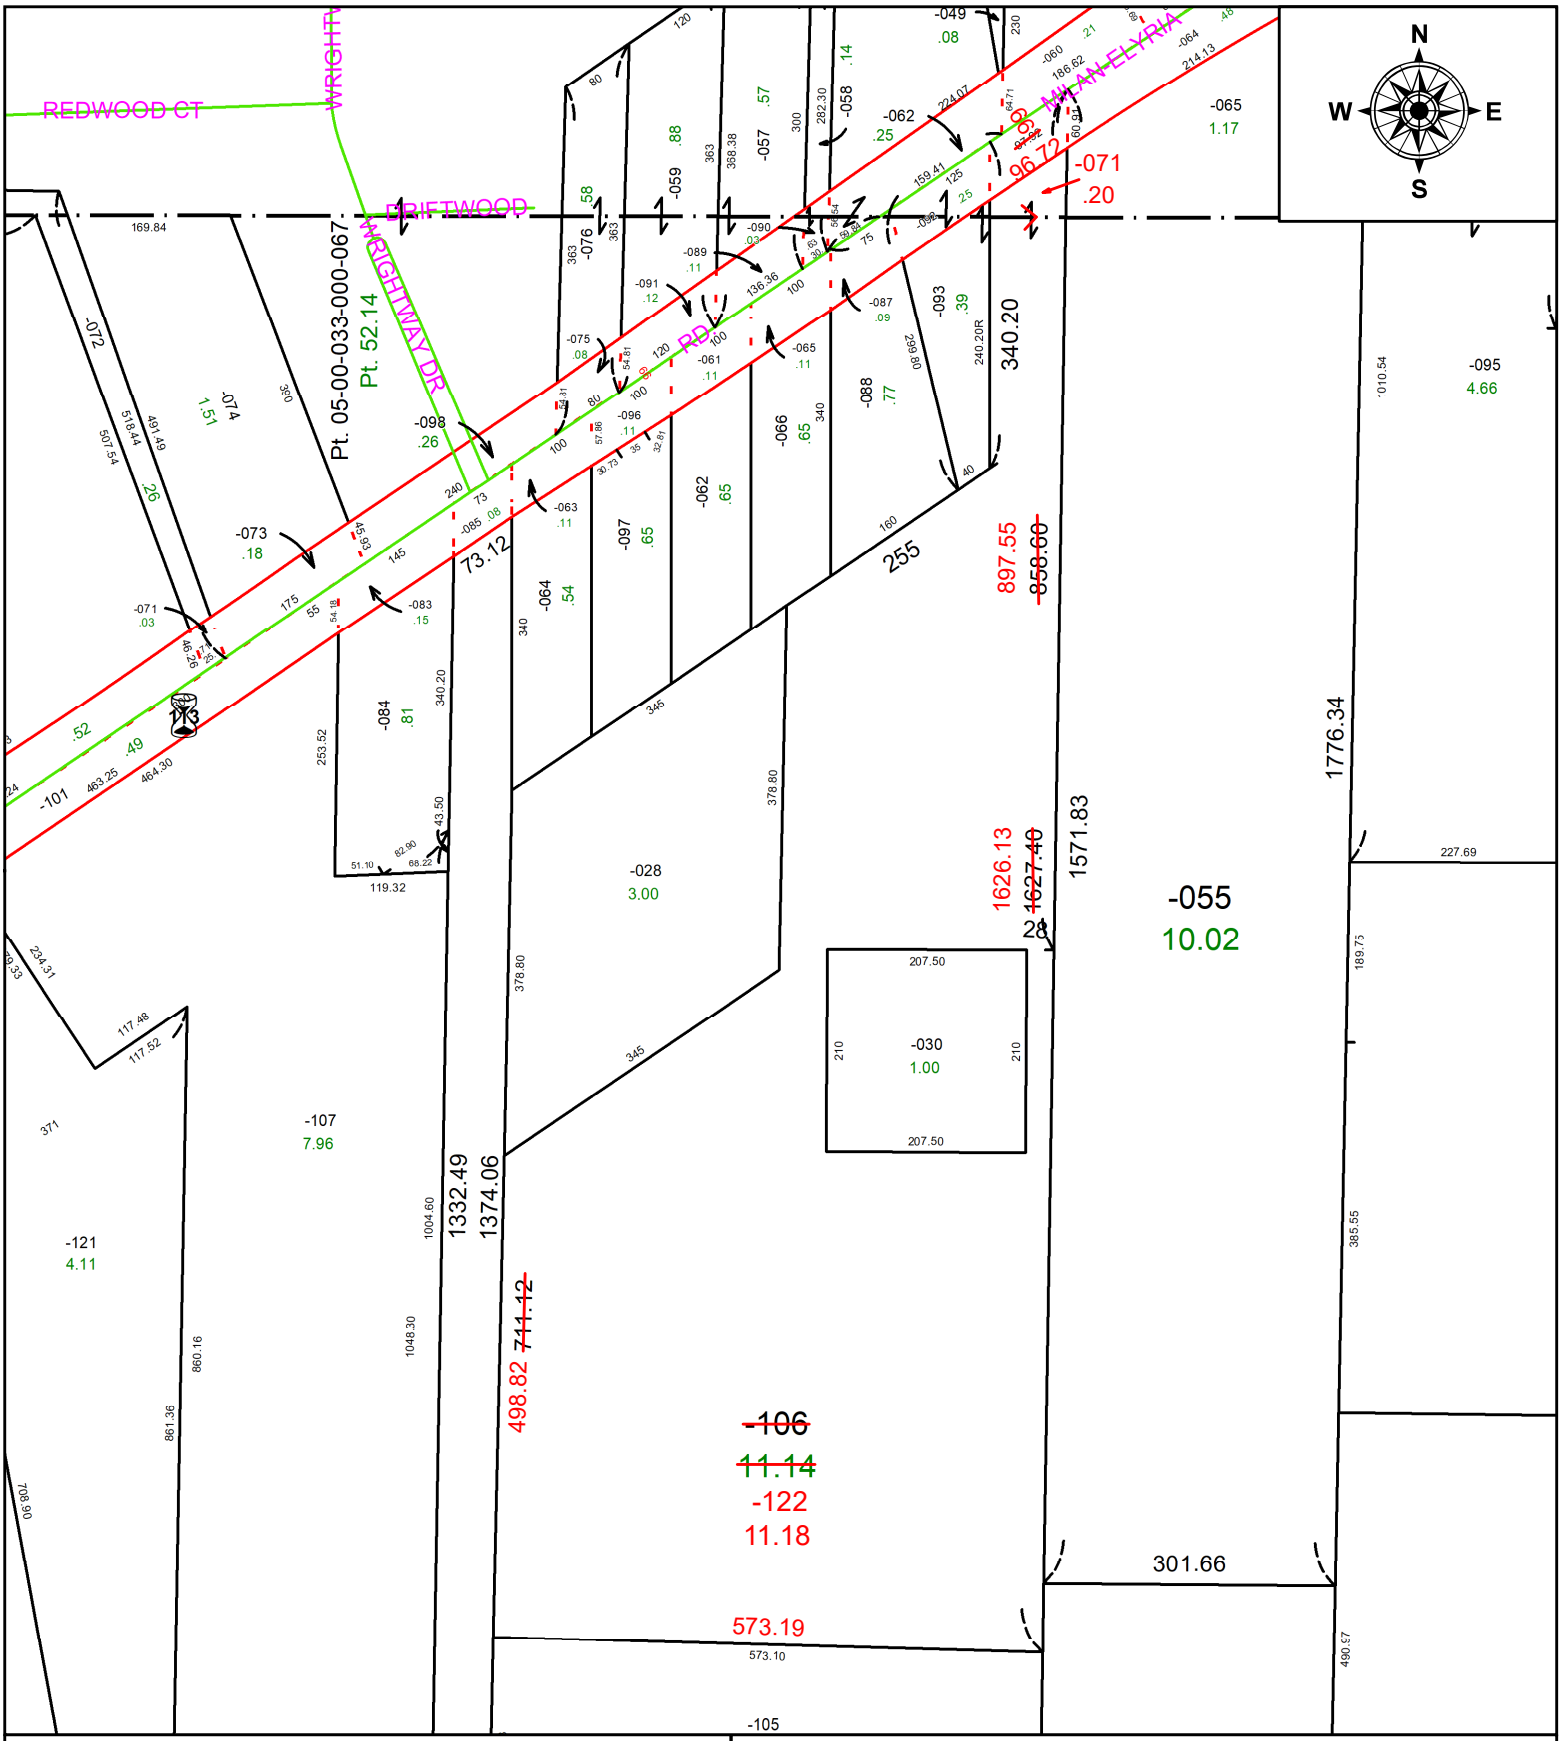

SPLITS/DEEDS PROCESSED

LORAIN COUNTY TAX MAP DEPARTMENT
226 MIDDLE AVE. ELYRIA, OH

SURVEYED BY: WILFREDO BARBOSA **SURV # 50948**

CLOSURE: 1: 19358

MAP PAGE(S): 05-00-032

APPOVED BY: AC **DATE:** July 20, 2023

SCALE: 1 in = 200 ft **PRIOR INSTRUMENT:** 2023- 0910130