PARENT PARCEL: 21-08-003-000-005 & -006 (S.T. 21-08-008-000-001)

CHILD PARCEL: 21-08-003-000-008

STARTING POINT: NW CORNER OF OL 3 AND INTSEC OF HAWLEY AND NEW LONDON RD

26-05121

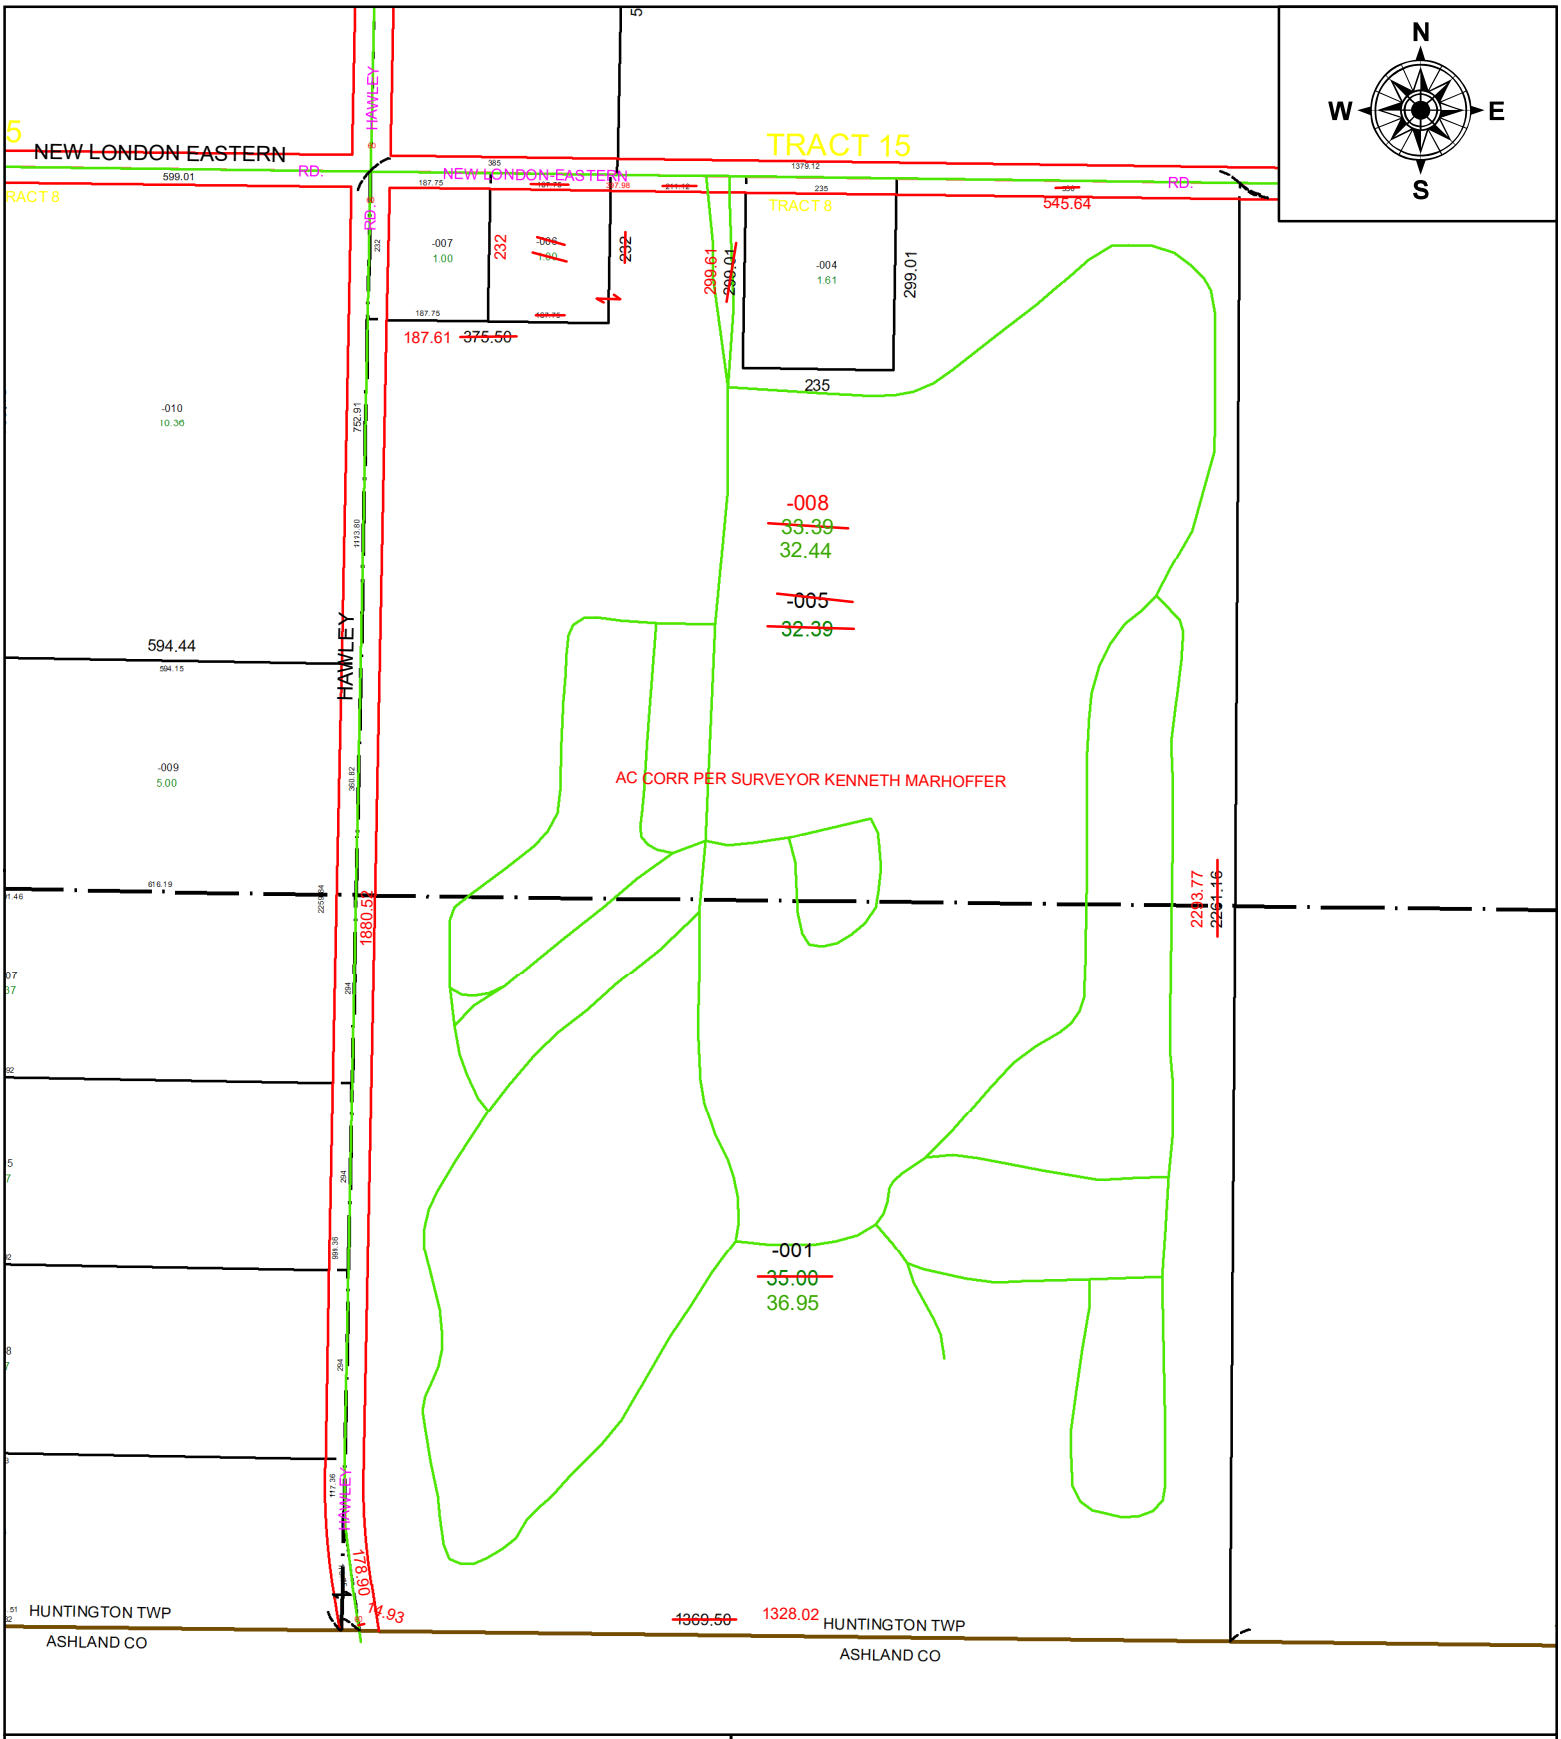

SPLITS/DEEDS PROCESSED

LORAIN COUNTY TAX MAP DEPARTMENT
226 MIDDLE AVE. ELYRIA, OH

SURVEYED BY: KENNETH MARHOFFER **SURVEY #:** 51649
CLOSURE: 1: 20060824
MAP PAGE(S): 06-25-077
APPOVED BY: BB **DATE:** 2/5/2026
SCALE: 1" = 300' **PRIOR INSTRUMENT:** #20250047611