PARENT PARCEL: 05-00-036-104-014
CHILD PARCEL: AC. CORR. PER CALC.
STARTING POINT: N/A

23-05123-A

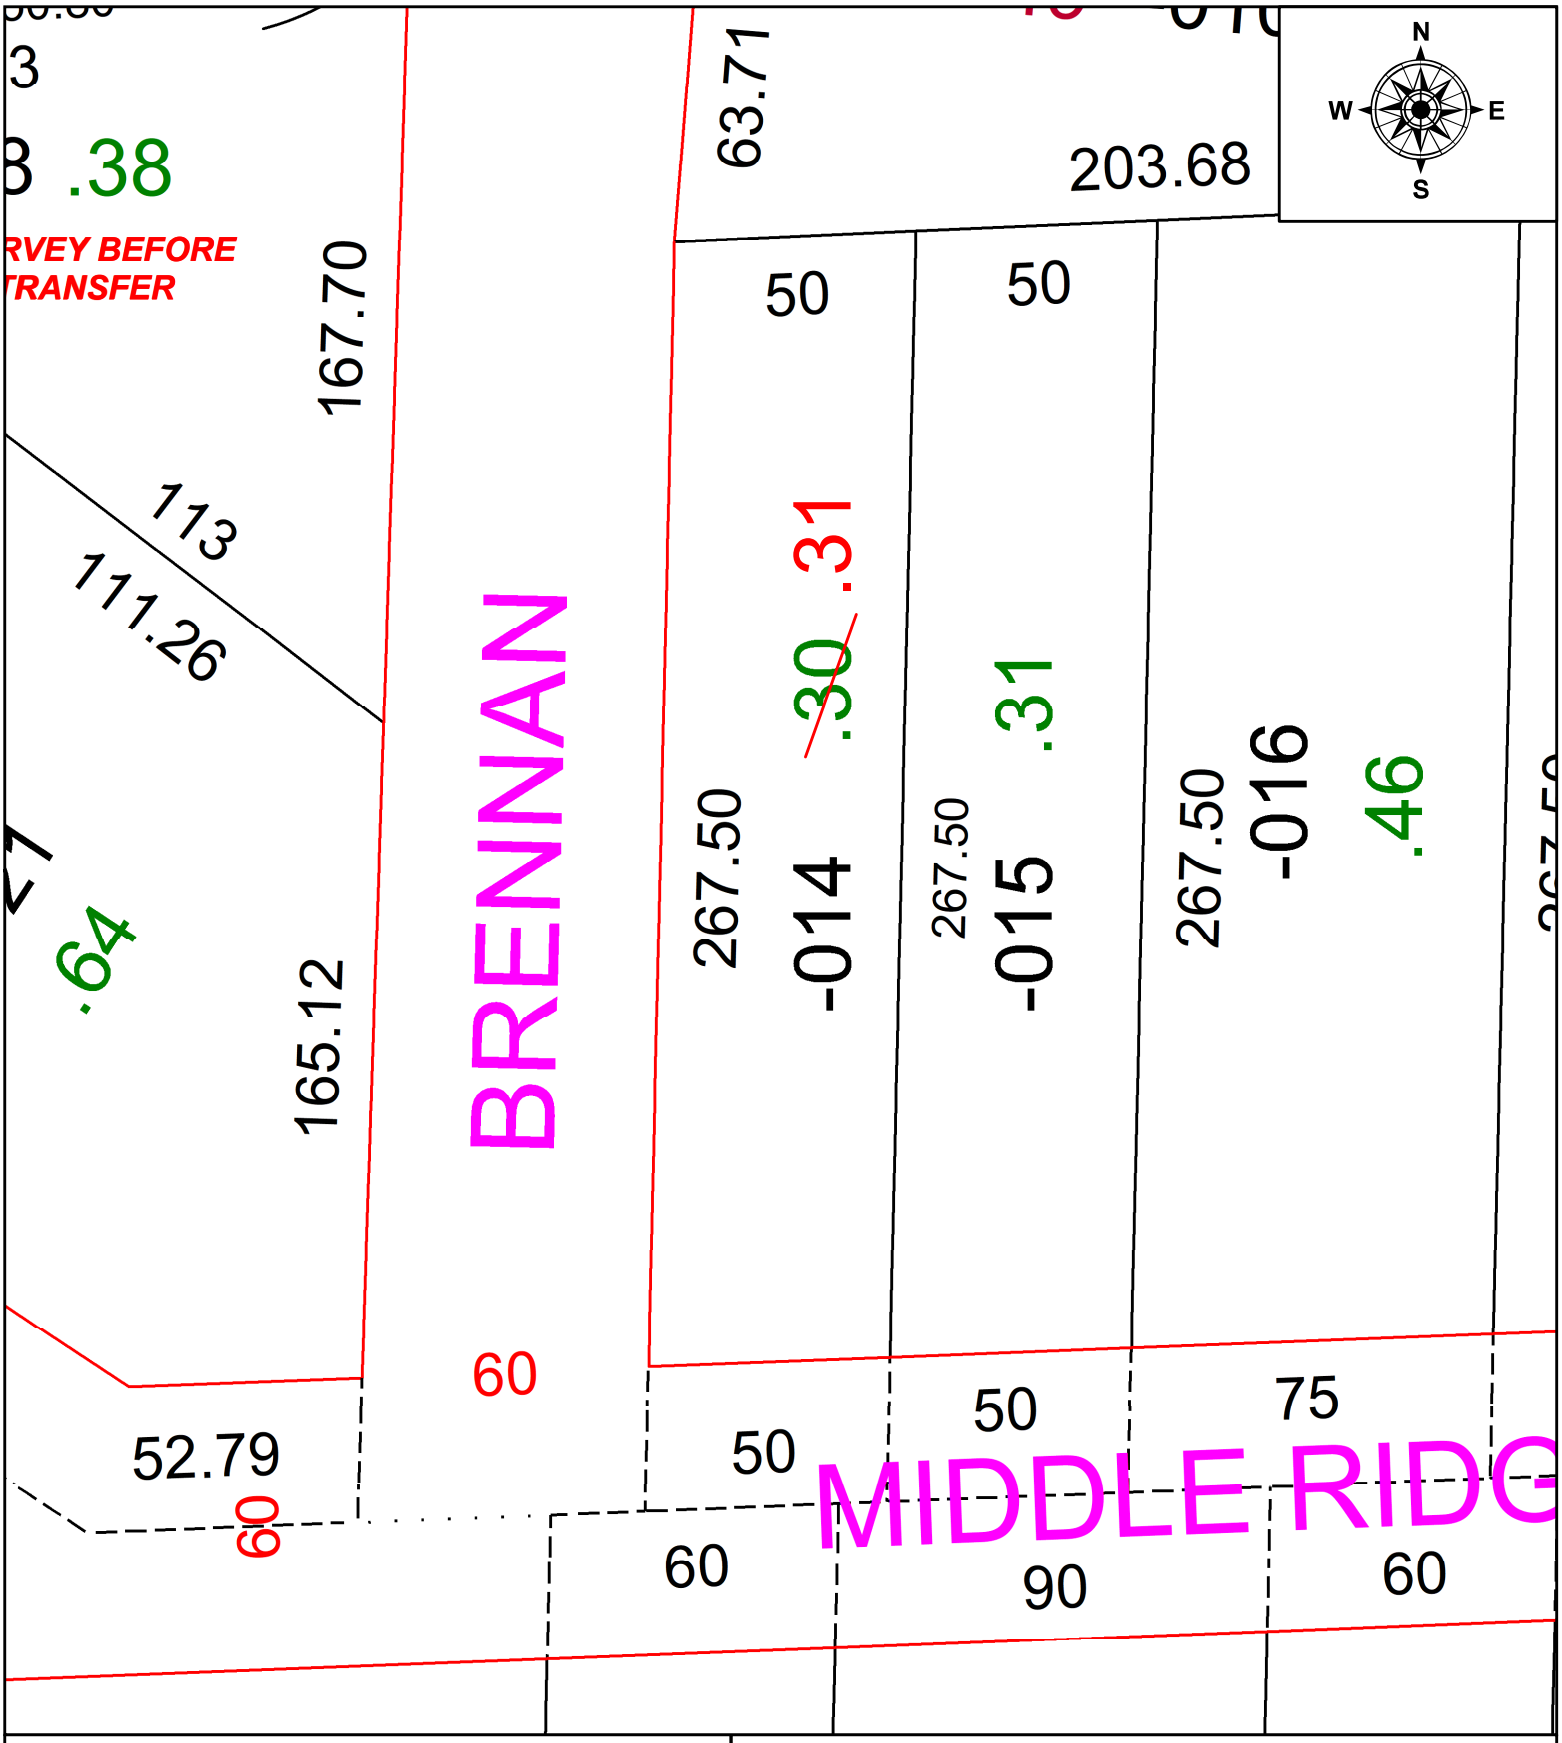

SPLITS/DEEDS PROCESSED
LORAIN COUNTY TAX MAP DEPARTMENT
226 MIDDLE AVE. ELYRIA, OH

SURVEYED BY: N/A **SURVEY #:** N/A
CLOSURE: N/A
MAP PAGE(S): 05-00-036
APPOVED BY: DMA **DATE:** 7/27/2023
SCALE: 1" = 40' **PRIOR INSTRUMENT:** D.V. 1407 PG. 631