PARENT PARCEL: 11-00-081-102-041

CHILD PARCEL: FRONT & DEPTH TO AC CORR PER SURV BY STEVEN J. METCALF

STARTING POINT: E LINE OF HURON ST AND N LINE OF CLEVELAND ST

23-05126-C

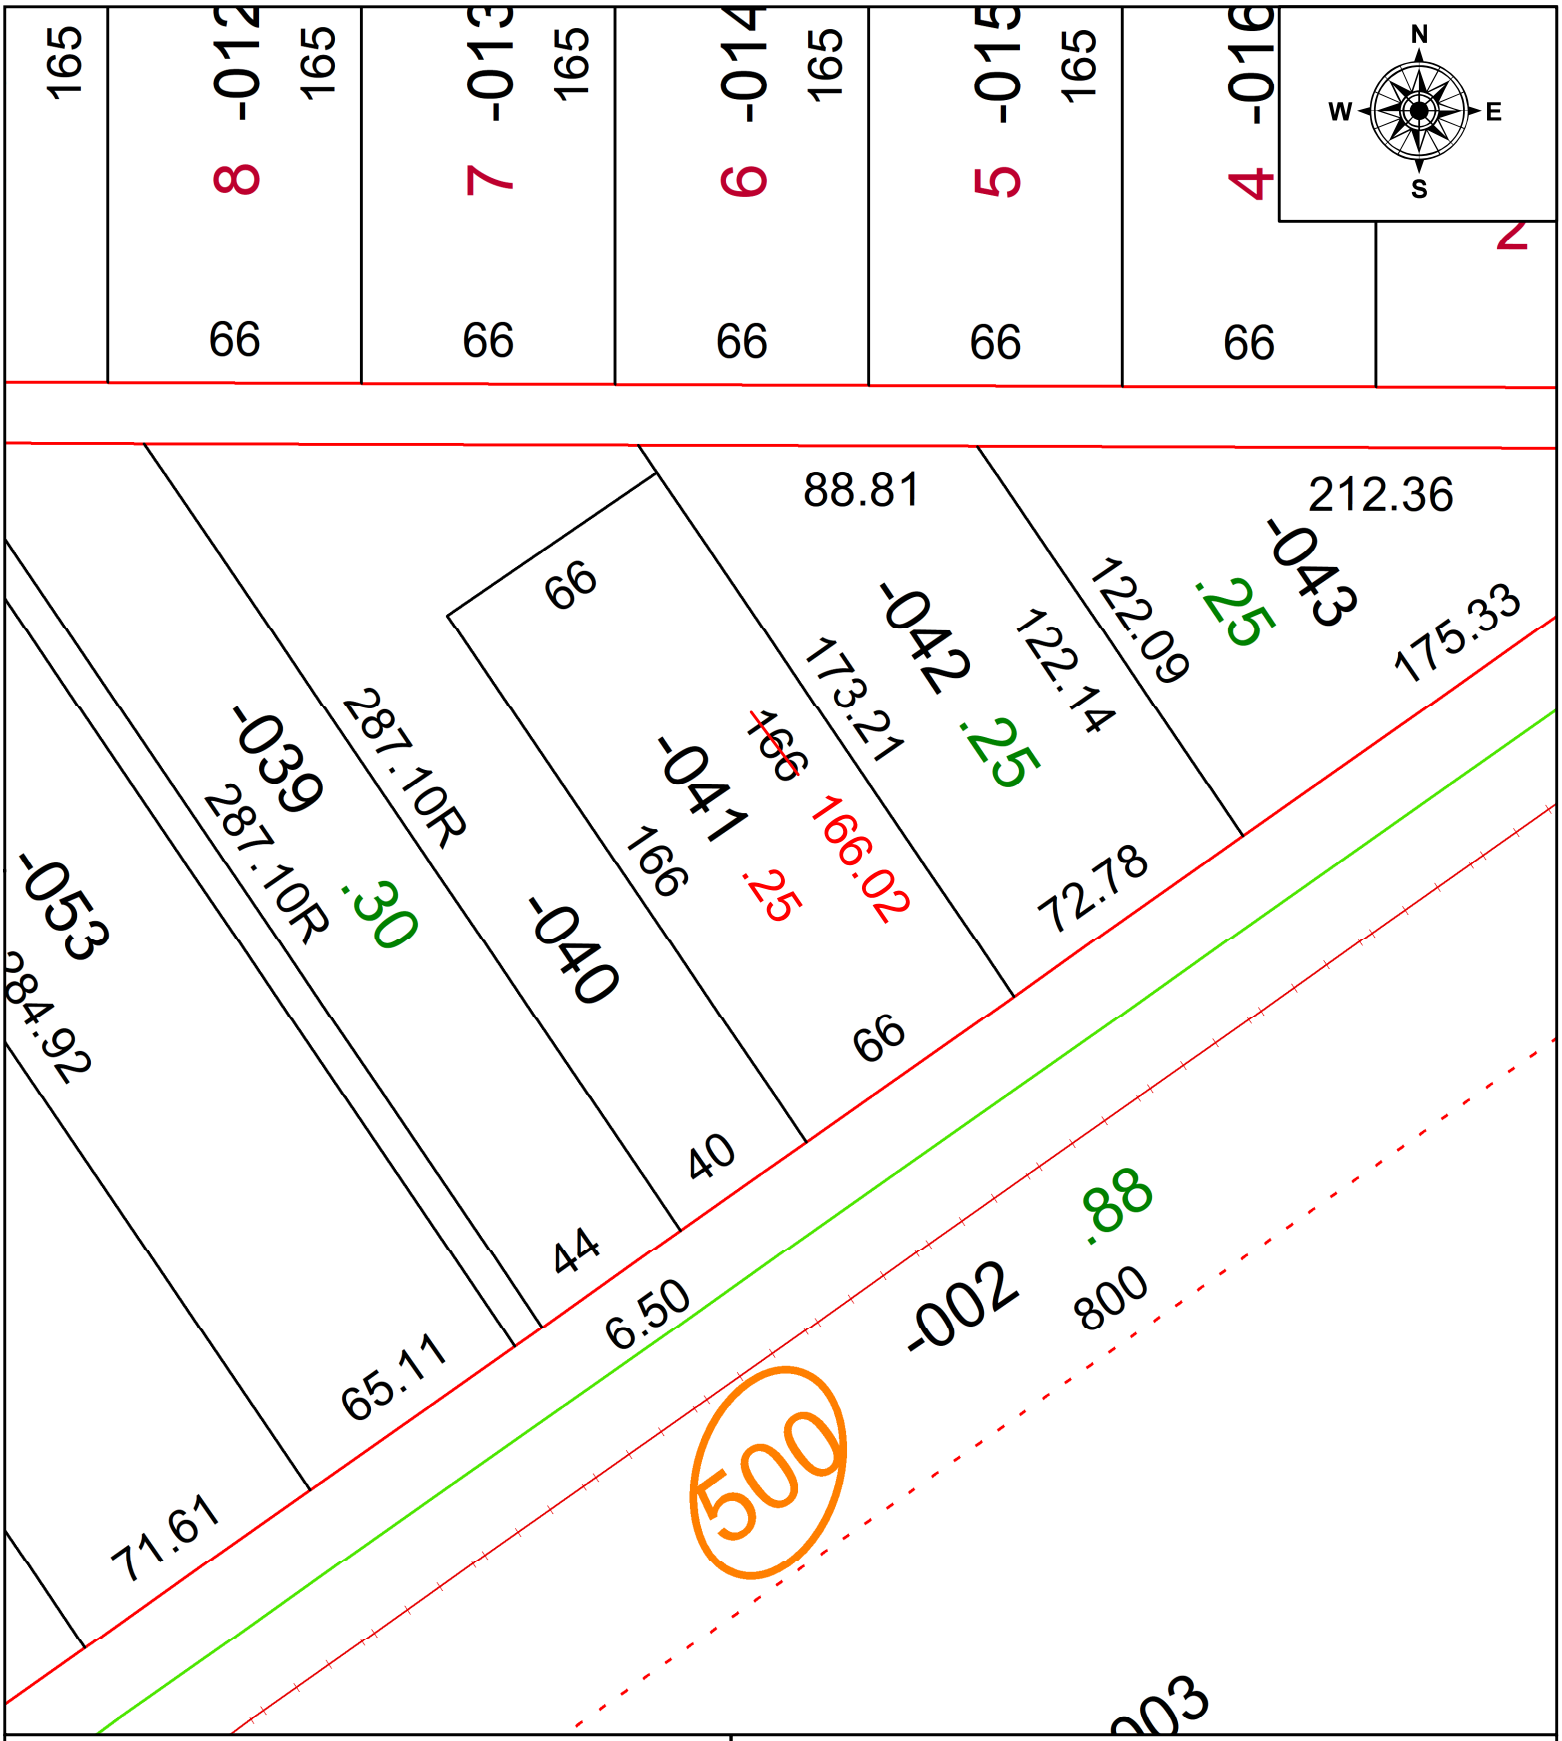

SPLITS/DEEDS PROCESSED

LORAIN COUNTY TAX MAP DEPARTMENT
226 MIDDLE AVE. ELYRIA, OH

SURVEYED BY: STEVEN J. METCALF **SURV # 50956**

CLOSURE: 1: 23200

MAP PAGE(S): 11-00-081

APPOVED BY: AC **DATE:** August 03, 2023

SCALE: 1 in = 50 ft **PRIOR INSTRUMENT:** 2008- 0254606