PARENT PARCEL:
CHILD PARCEL:
STARTING POINT: STREET NAME CHANGE PER ORD. #2023-20 FROM CLAY ST.

23-05133-C

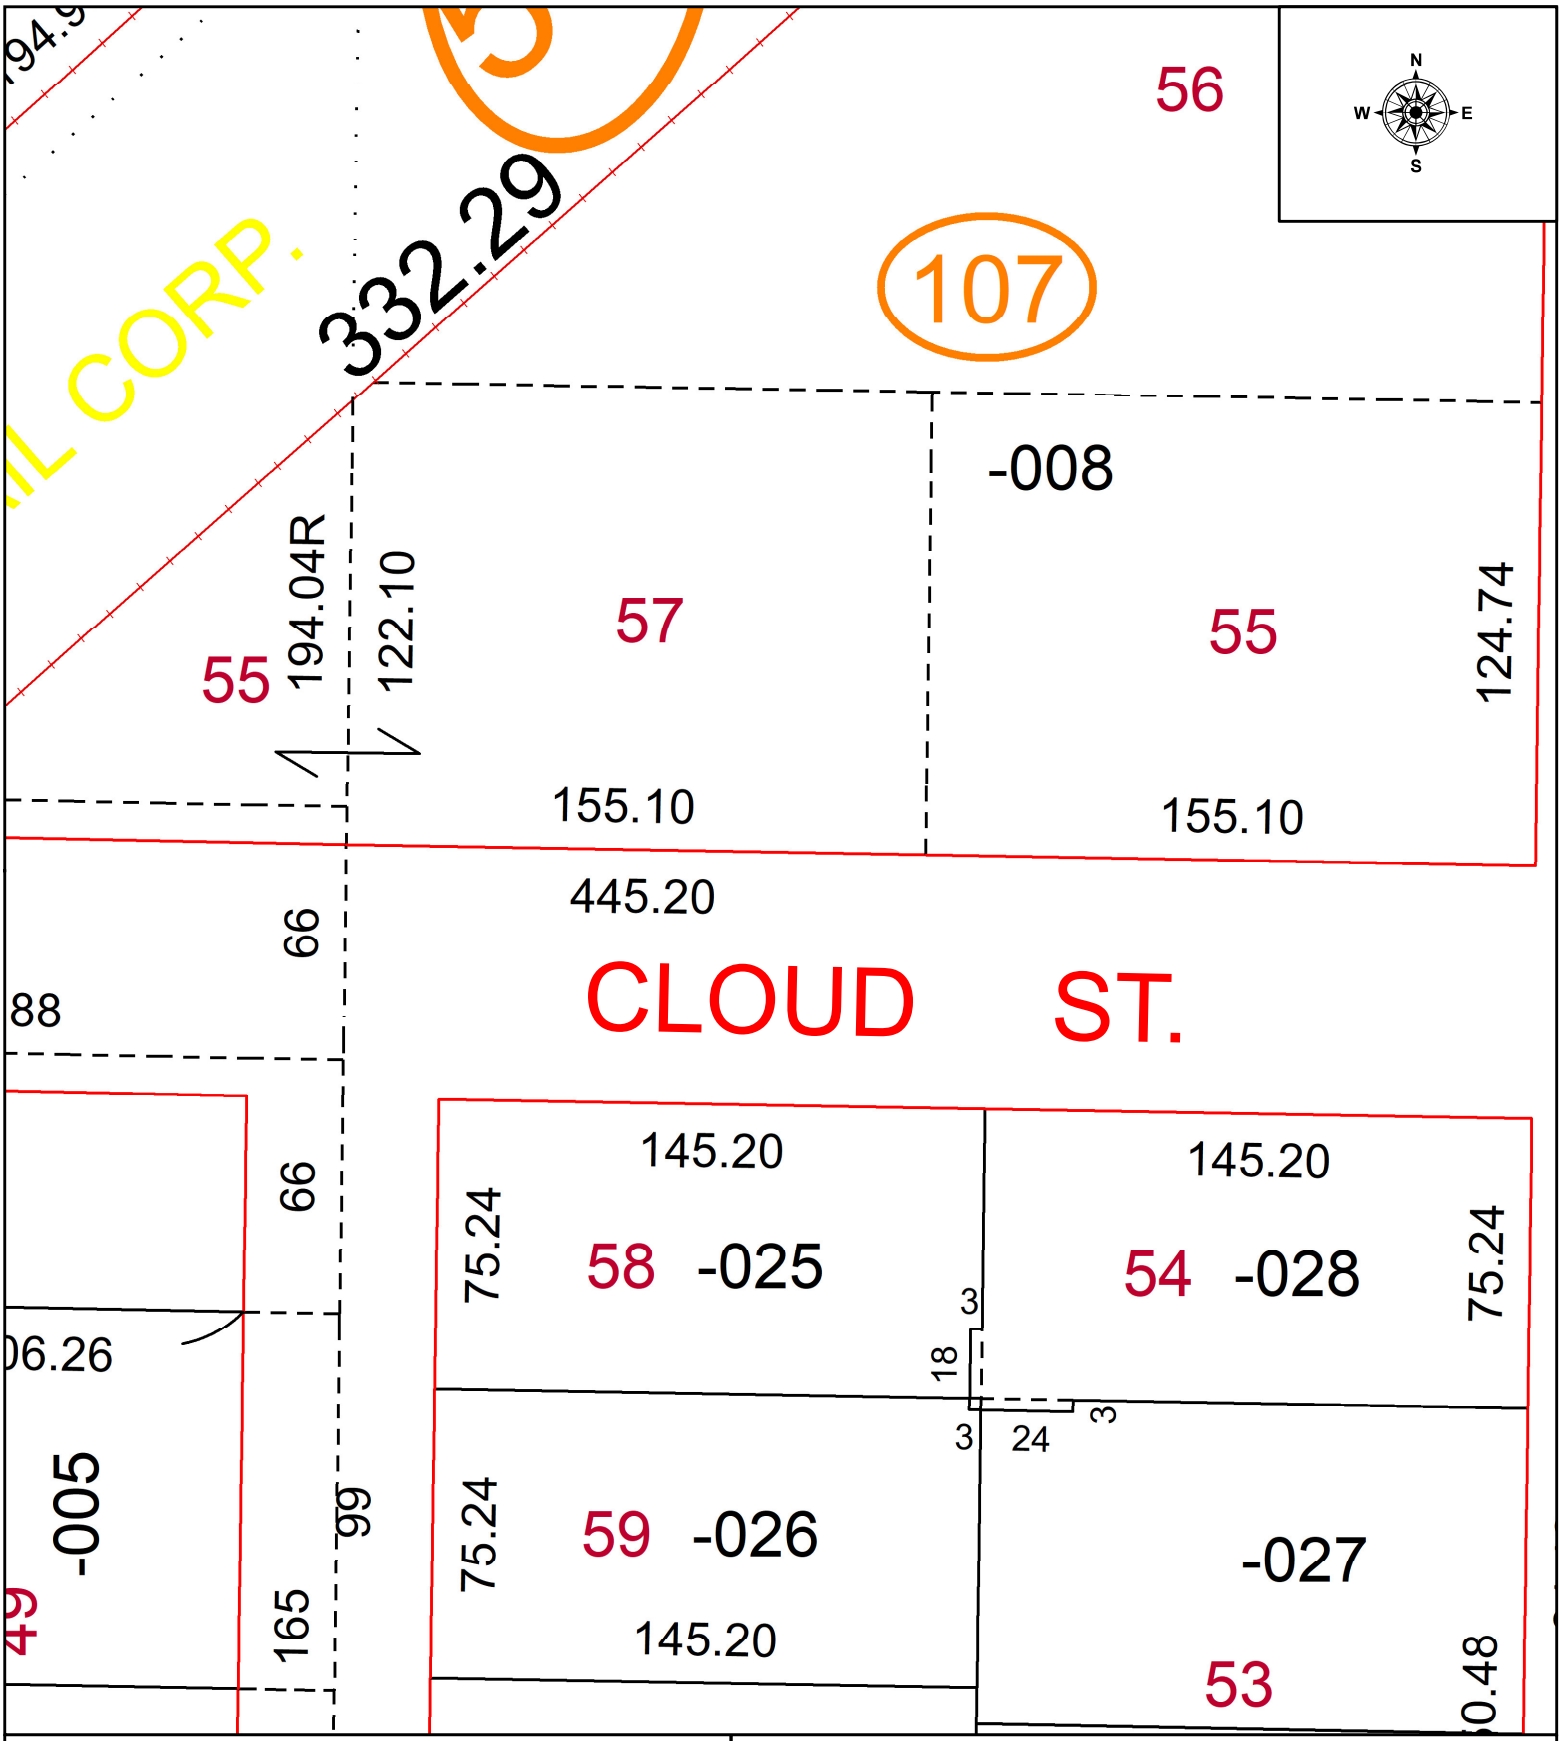

SPLITS/DEEDS PROCESSED
LORAIN COUNTY TAX MAP DEPARTMENT
226 MIDDLE AVE. ELYRIA, OH

SURVEYED BY: N/A SURVEY # N/A
CLOSURE: 1:
MAP PAGE(S): 18-00-021
APPOVED BY: WRZ **DATE:** 8/10/2023
SCALE: 1" = 50 **PRIOR INSTRUMENT:**