PARENT PARCEL: 04-00-018-115-012, -045

CHILD PARCEL: 04-00-018-115-061 COMBO PER PRIOR INSTRUMENT NUMBER 2020-01070338

STARTING POINT: C/L INTERSECT OF AVON CENTER RD & SOUTH LINE OF ELECTRIC BLVD

23-05146-C

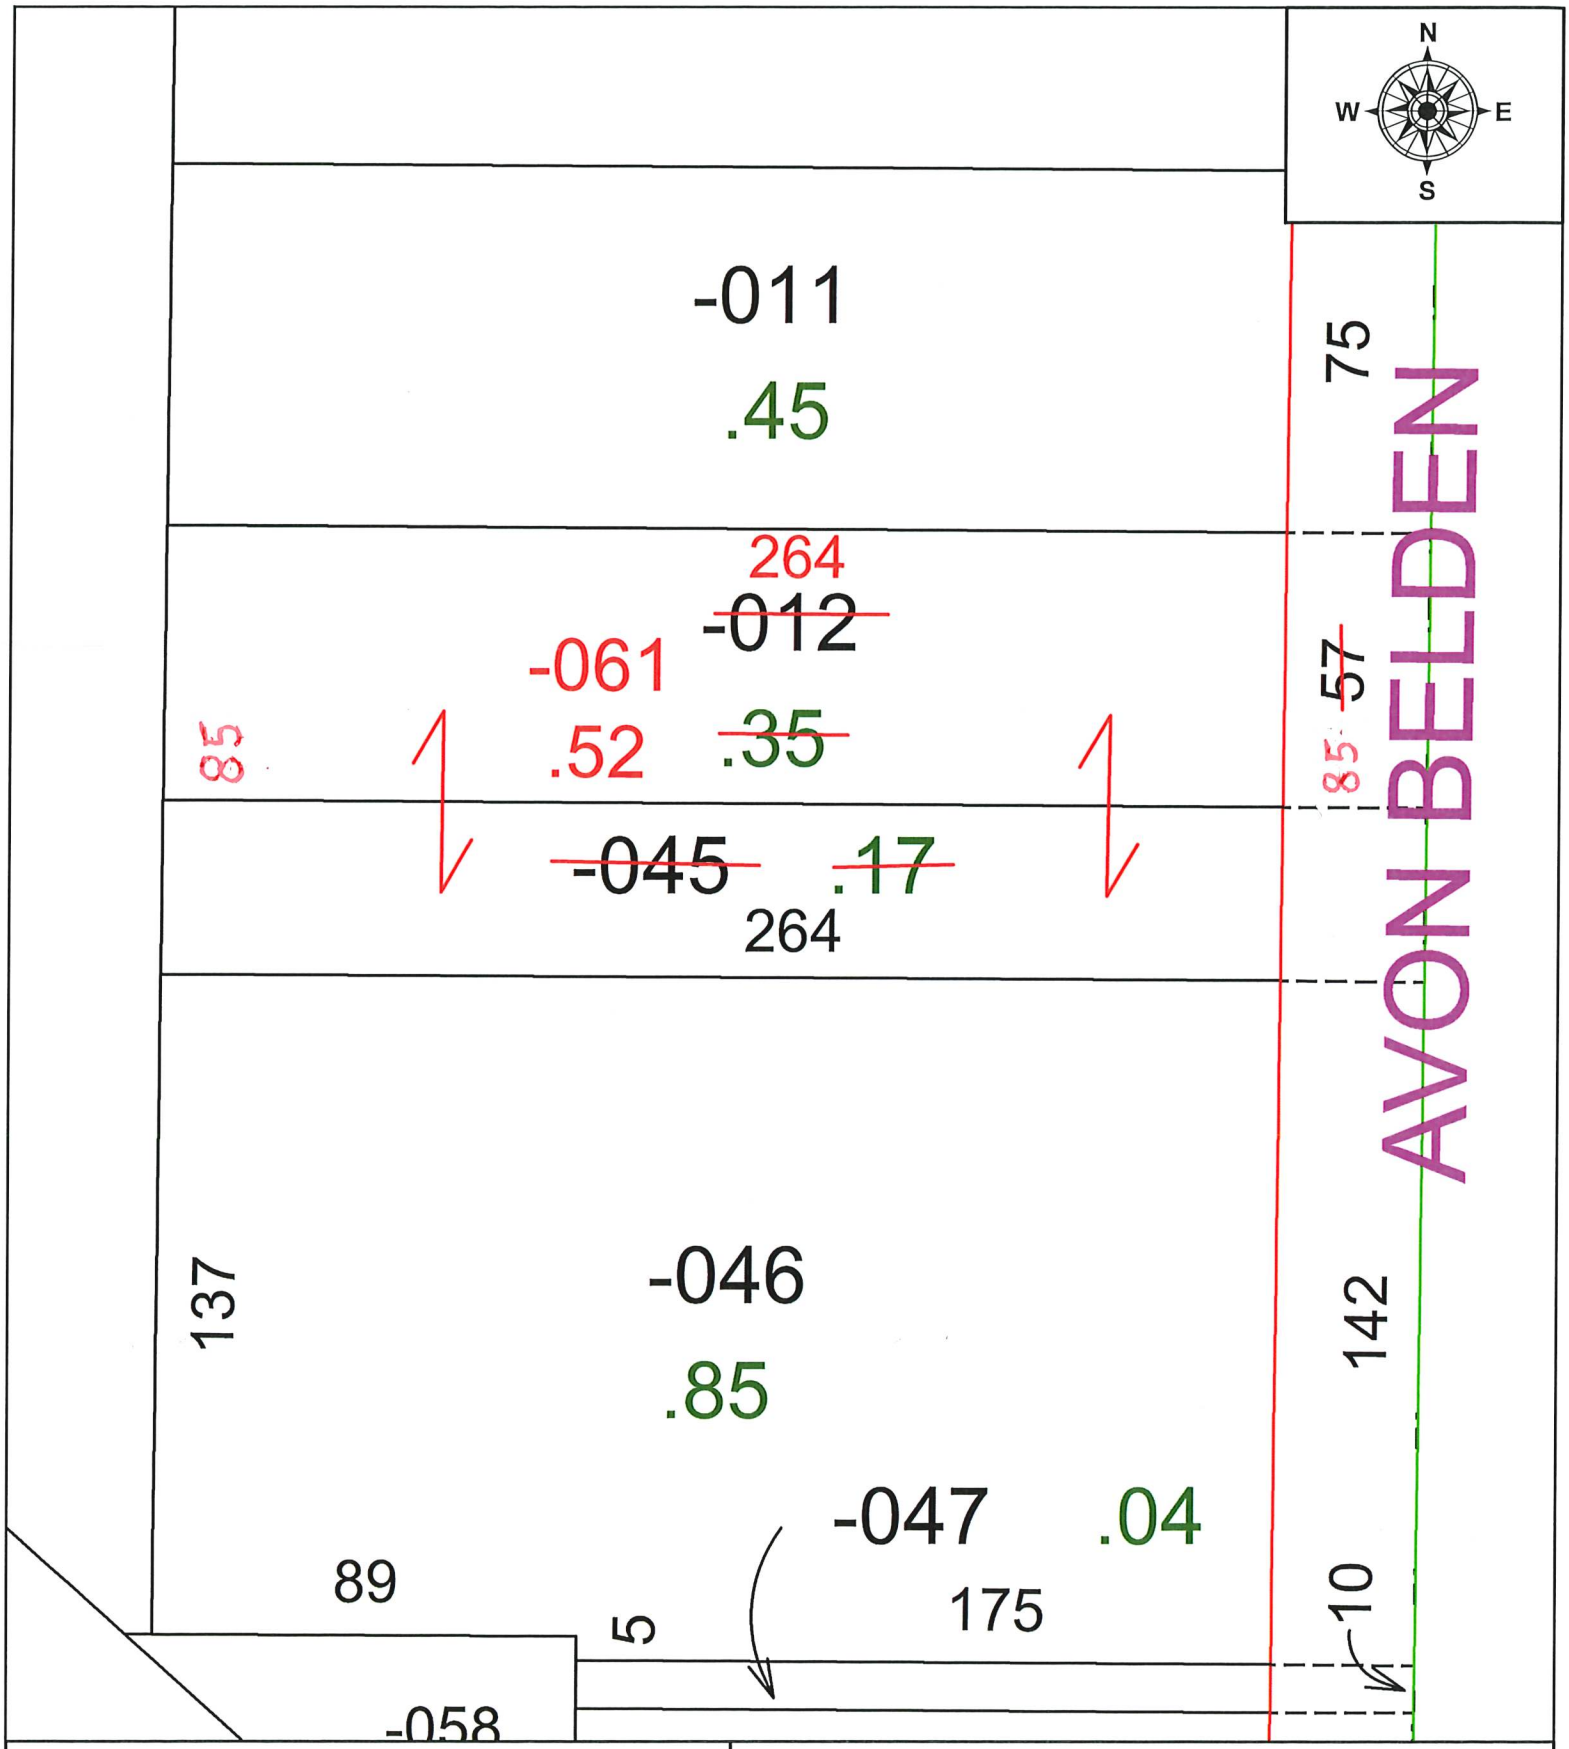

SPLITS/DEEDS PROCESSED

LORAIN COUNTY TAX MAP DEPARTMENT
226 MIDDLE AVE. ELYRIA, OH

SURVEYED BY: N/A SURVEY #: N/A

CLOSURE: N/A

MAP PAGE(S): 04-00-018

APPOVED BY: SP DATE: 9/1/2023

SCALE: 1" = 40' PRIOR INSTRUMENT: 2020-01070338