PARENT PARCEL: 16-00-019-105-006, 16-00-020-000-015

CHILD PARCEL: N/A AC CORR PER SURVEY BY LOUIS J. GIFFELS

STARTING POINT: C/L INTERSECTIPN OF CROOK & CHAMBERLAIN

23-05149-C

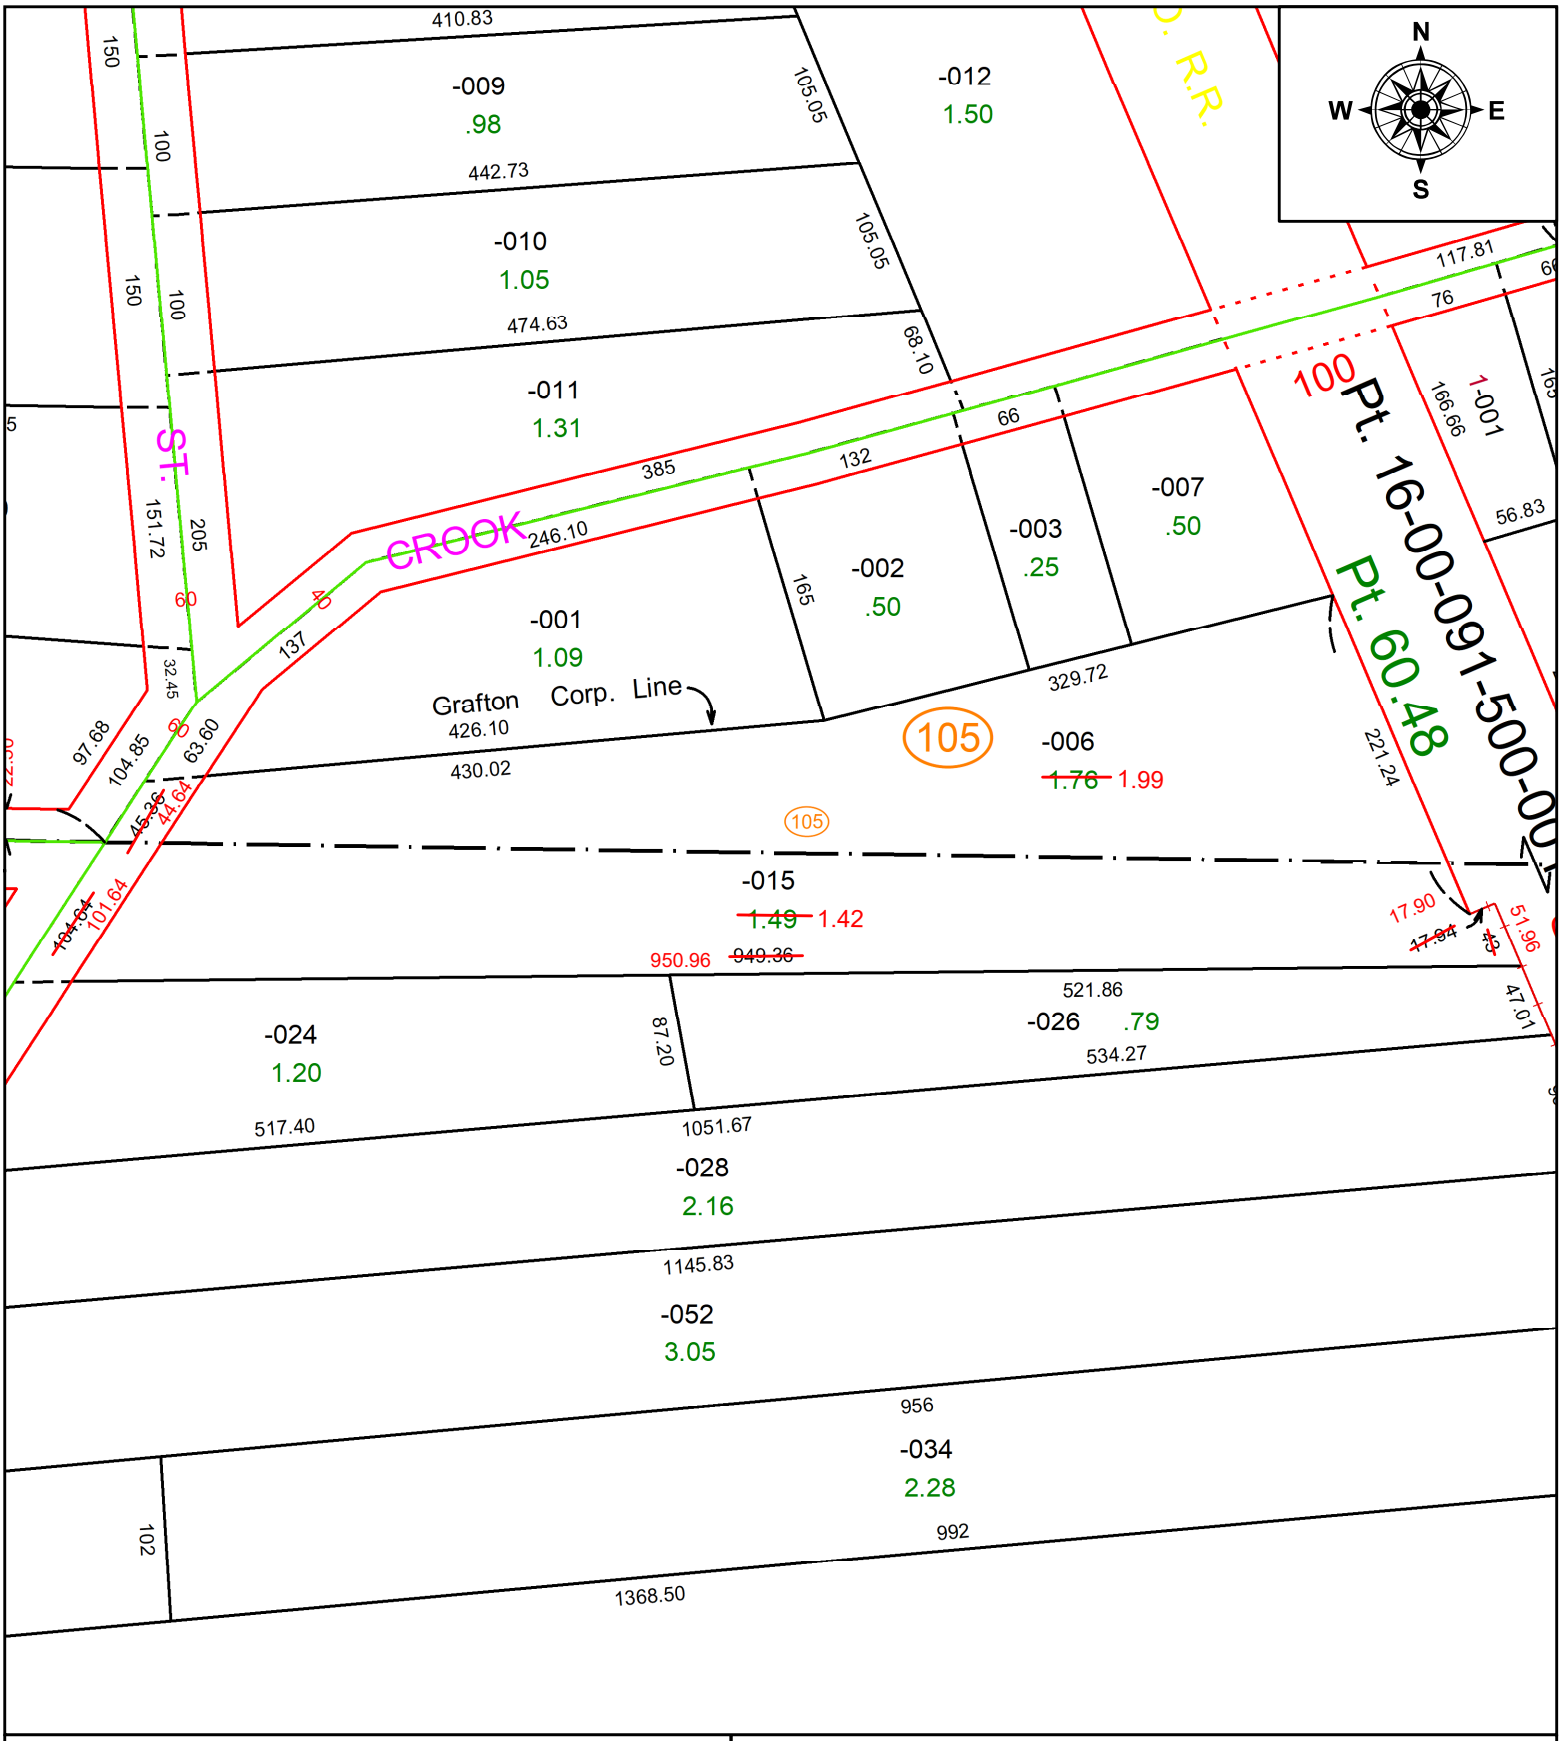

SPLITS/DEEDS PROCESSED

LORAIN COUNTY TAX MAP DEPARTMENT
226 MIDDLE AVE. ELYRIA, OH

SURVEYED BY: LOUIS J. GIFFELS **SURVEY #:** 51005

CLOSURE: 1:755,974

MAP PAGE(S): 16-00-019 & 16-00-020

APPOVED BY: SP **DATE:** 9/7/2023

SCALE: 1" = 120' **PRIOR INSTRUMENT:** 2015-0546384