PARENT PARCEL: 10-00-021-000-066 & 10-00-022-000-118

CHILD PARCEL: N/A AC. CORR. PER SURVEY BY THOMAS M. SNEZEK

STARTING POINT: INTERSECTION OF C/L OF DIAGONAL RD & EASTERLY LINE OF O/L 21

23-05156-C

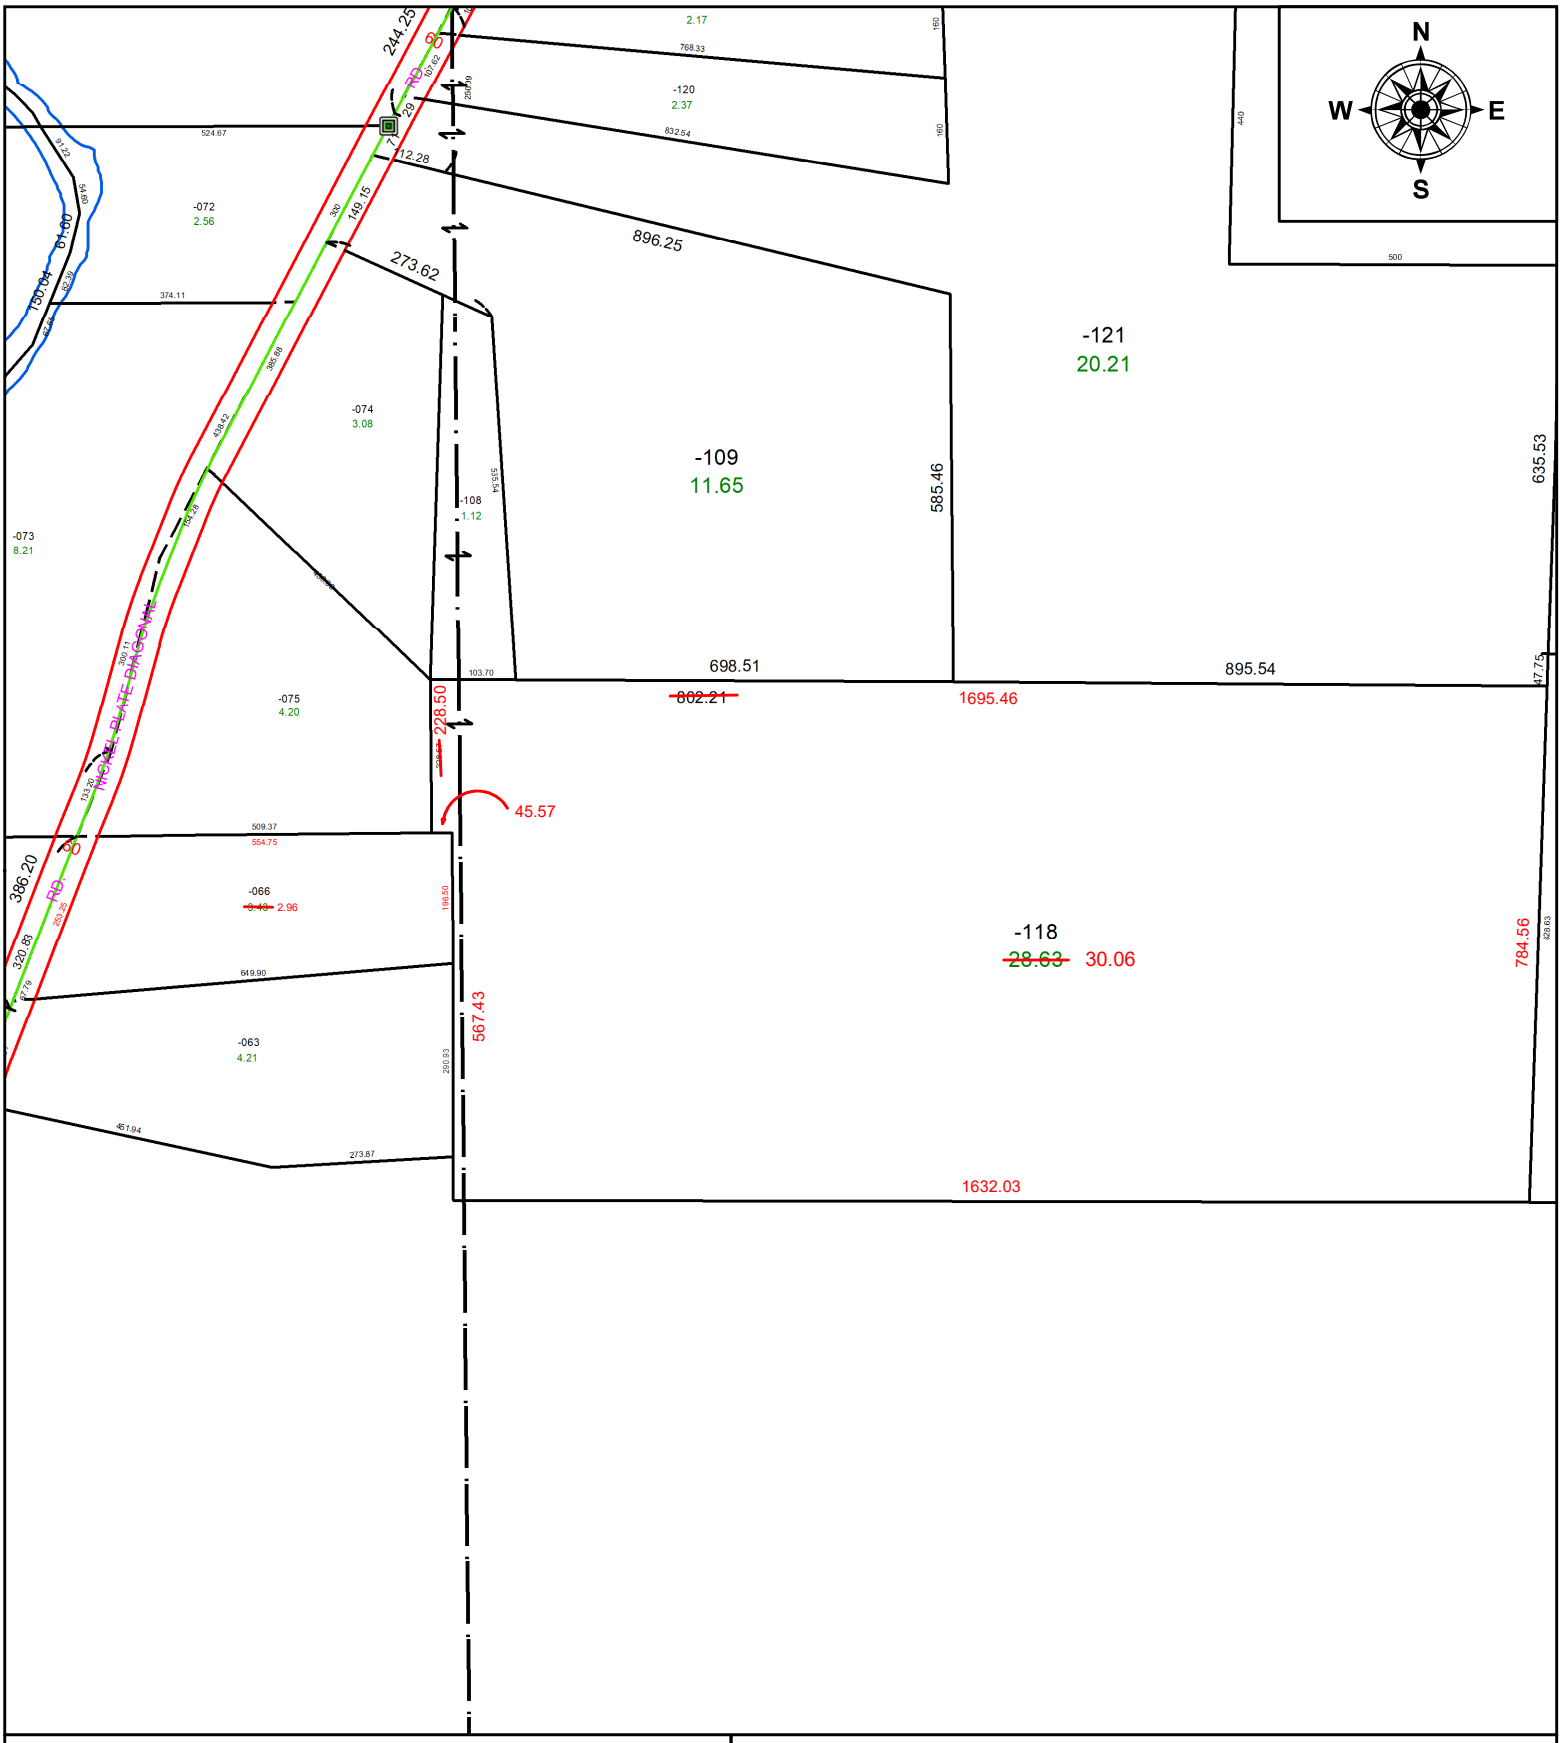

SPLITS/DEEDS PROCESSED

LORAIN COUNTY TAX MAP DEPARTMENT
226 MIDDLE AVE. ELYRIA, OH

SURVEYED BY: THOMAS M. SNEZEK **SURVEY #:** 51014

CLOSURE: N/A

MAP PAGE(S): 10-00-021/022

APPOVED BY: SP **DATE:** 9/15/2023

SCALE: 1" = 290' **PRIOR INSTRUMENT:** 1993-0220185