PARENT PARCEL: 04-00-020-104-008
CHILD PARCEL: AC. CORR. PER D.V. 929 PG. 390
STARTING POINT: N/A

23-05157-A

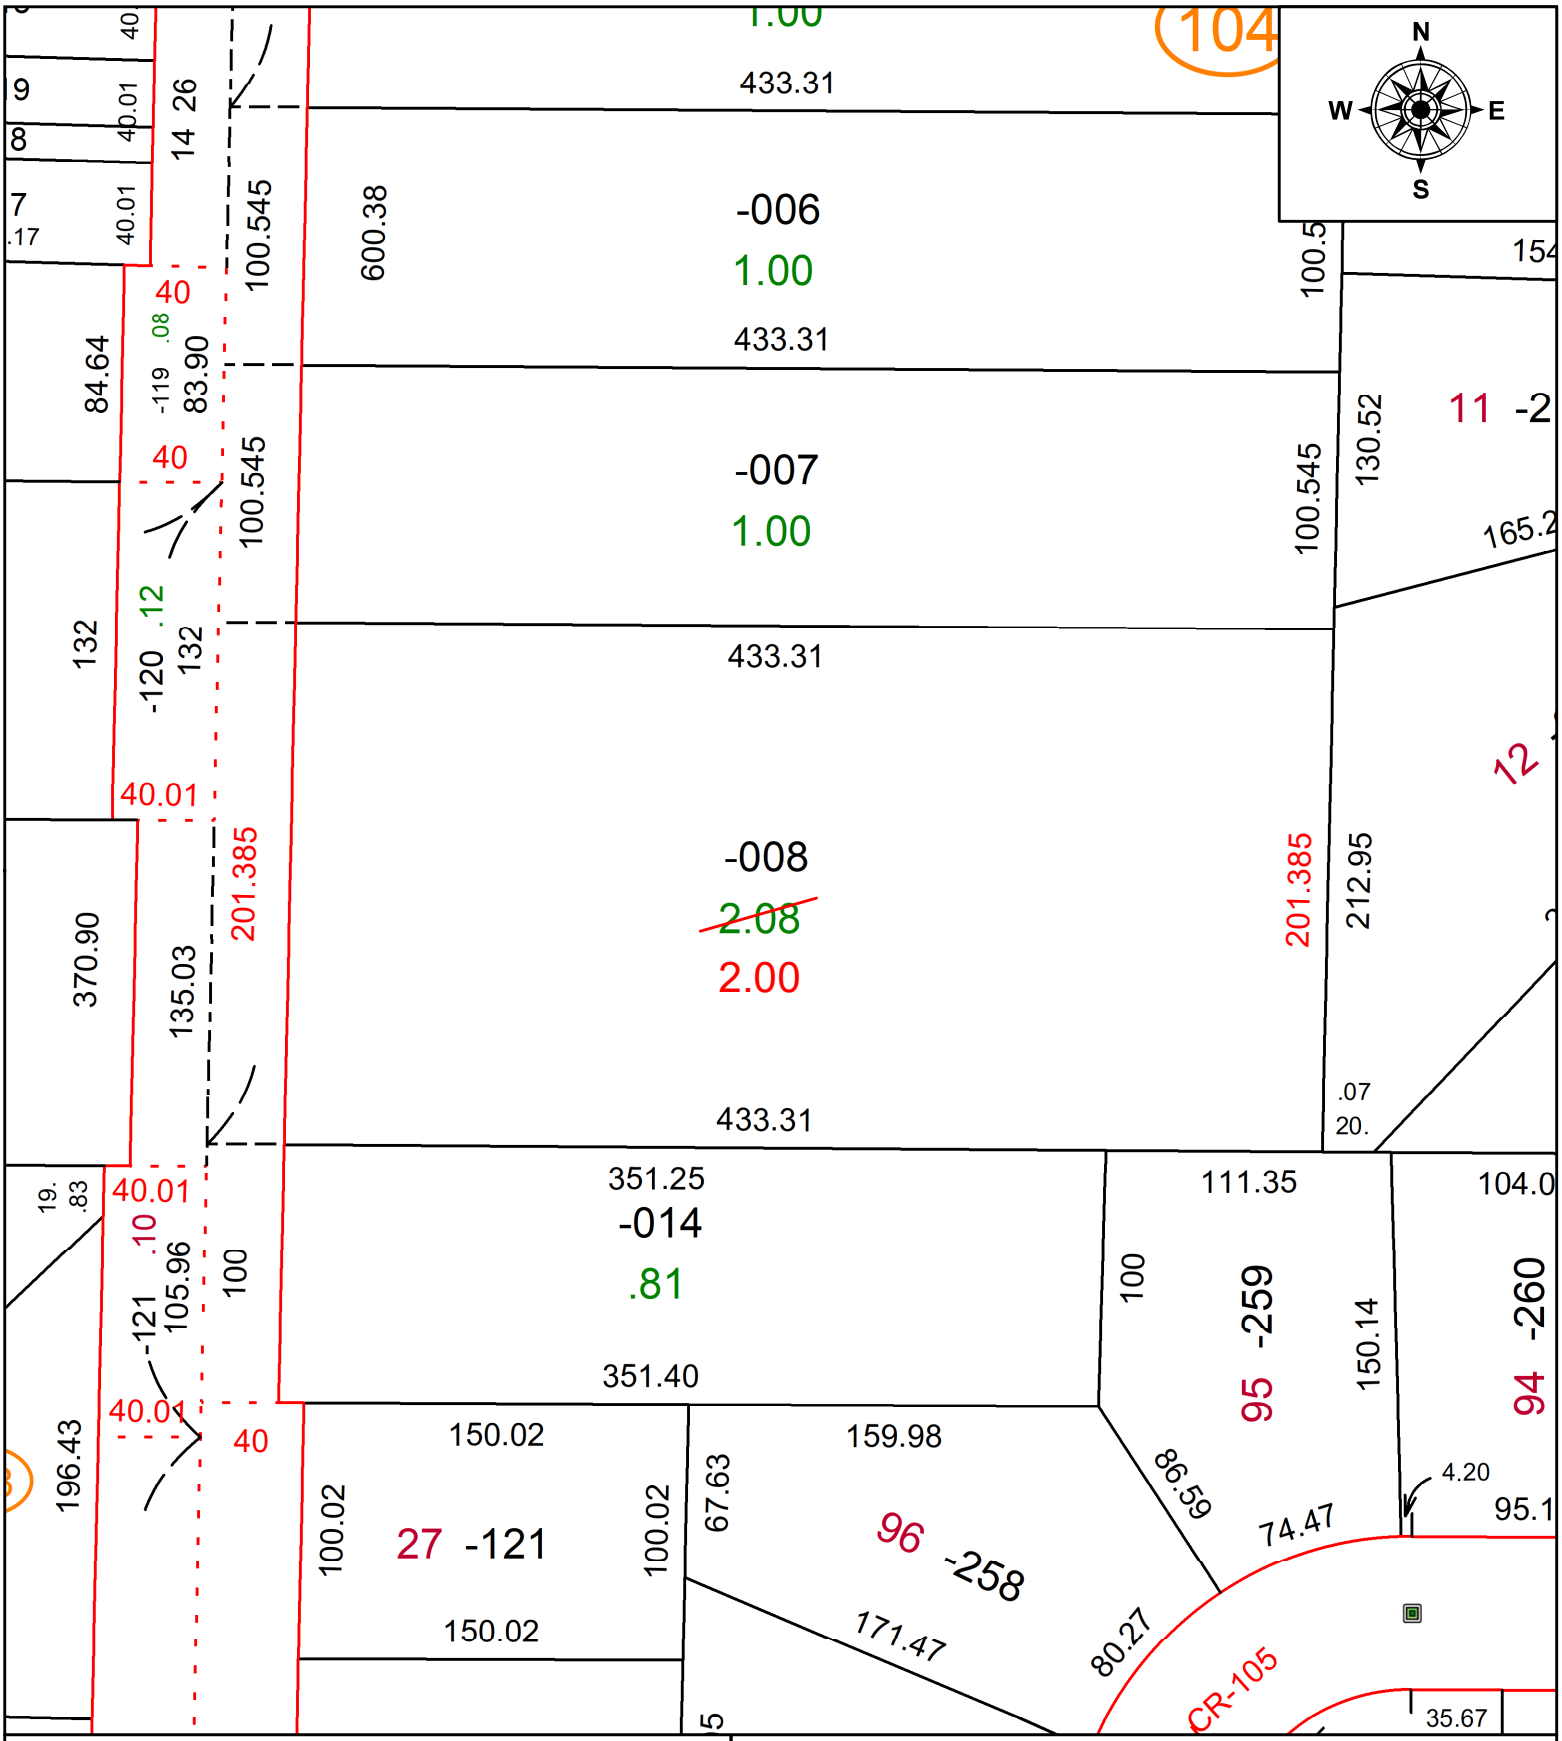

SPLITS/DEEDS PROCESSED
LORAIN COUNTY TAX MAP DEPARTMENT
226 MIDDLE AVE. ELYRIA, OH

SURVEYED BY: N/A **SURVEY #:** N/A
CLOSURE: N/A
MAP PAGE(S): 04-00-020
APPOVED BY: DMA **DATE:** 9/18/2023
SCALE: 1" = 75' **PRIOR INSTRUMENT:** D.V. 929 PG. 390