PARENT PARCEL: 12-00-003-000-053

CHILD PARCEL: AC CORR PER SURVEYOR PETE GAURILOFF

STARTING POINT: MONUMENT BOX @ C/L OF CLARKE RD & SOUTH LINE OF O.L. 3

23-05164-A

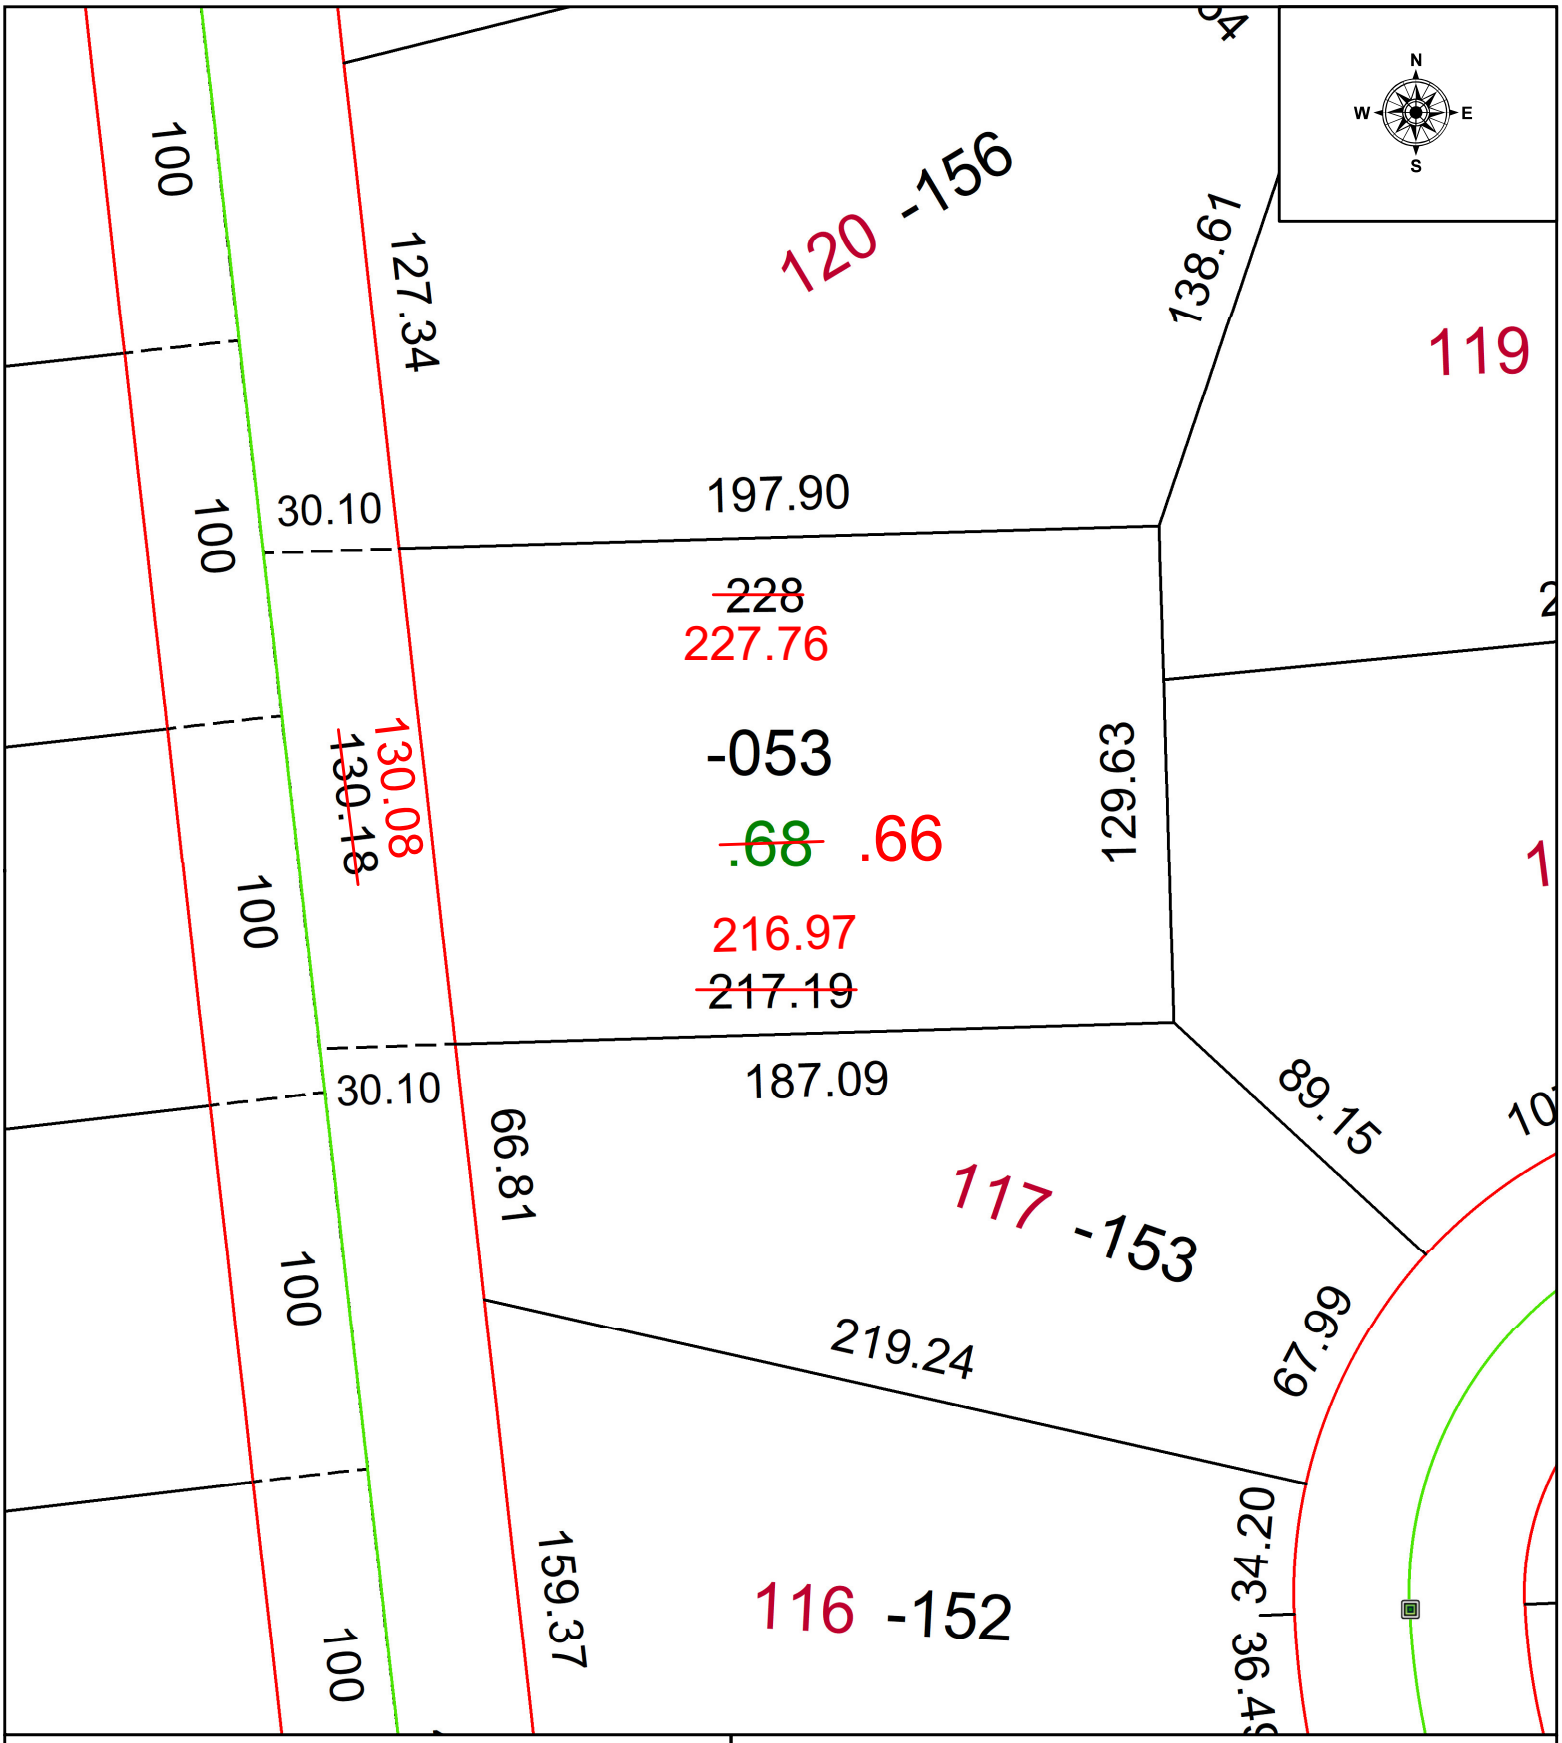

SPLITS/DEEDS PROCESSED

LORAIN COUNTY TAX MAP DEPARTMENT
226 MIDDLE AVE. ELYRIA, OH

SURVEYED BY: PETE GAURILOFF SURVEY # 51020

CLOSURE: 1: 178387

MAP PAGE(S): 12-00-003

APPOVED BY: WRZ **DATE:** 10/3/2023

SCALE: 1" = 50 **PRIOR INSTRUMENT:** #2023-0908703