PARENT PARCEL: 05-00-016-102-014

CHILD PARCEL: AC. CORR. PER INTRUMENT # 1997-0462927

STARTING POINT: N/A

23-05175-A

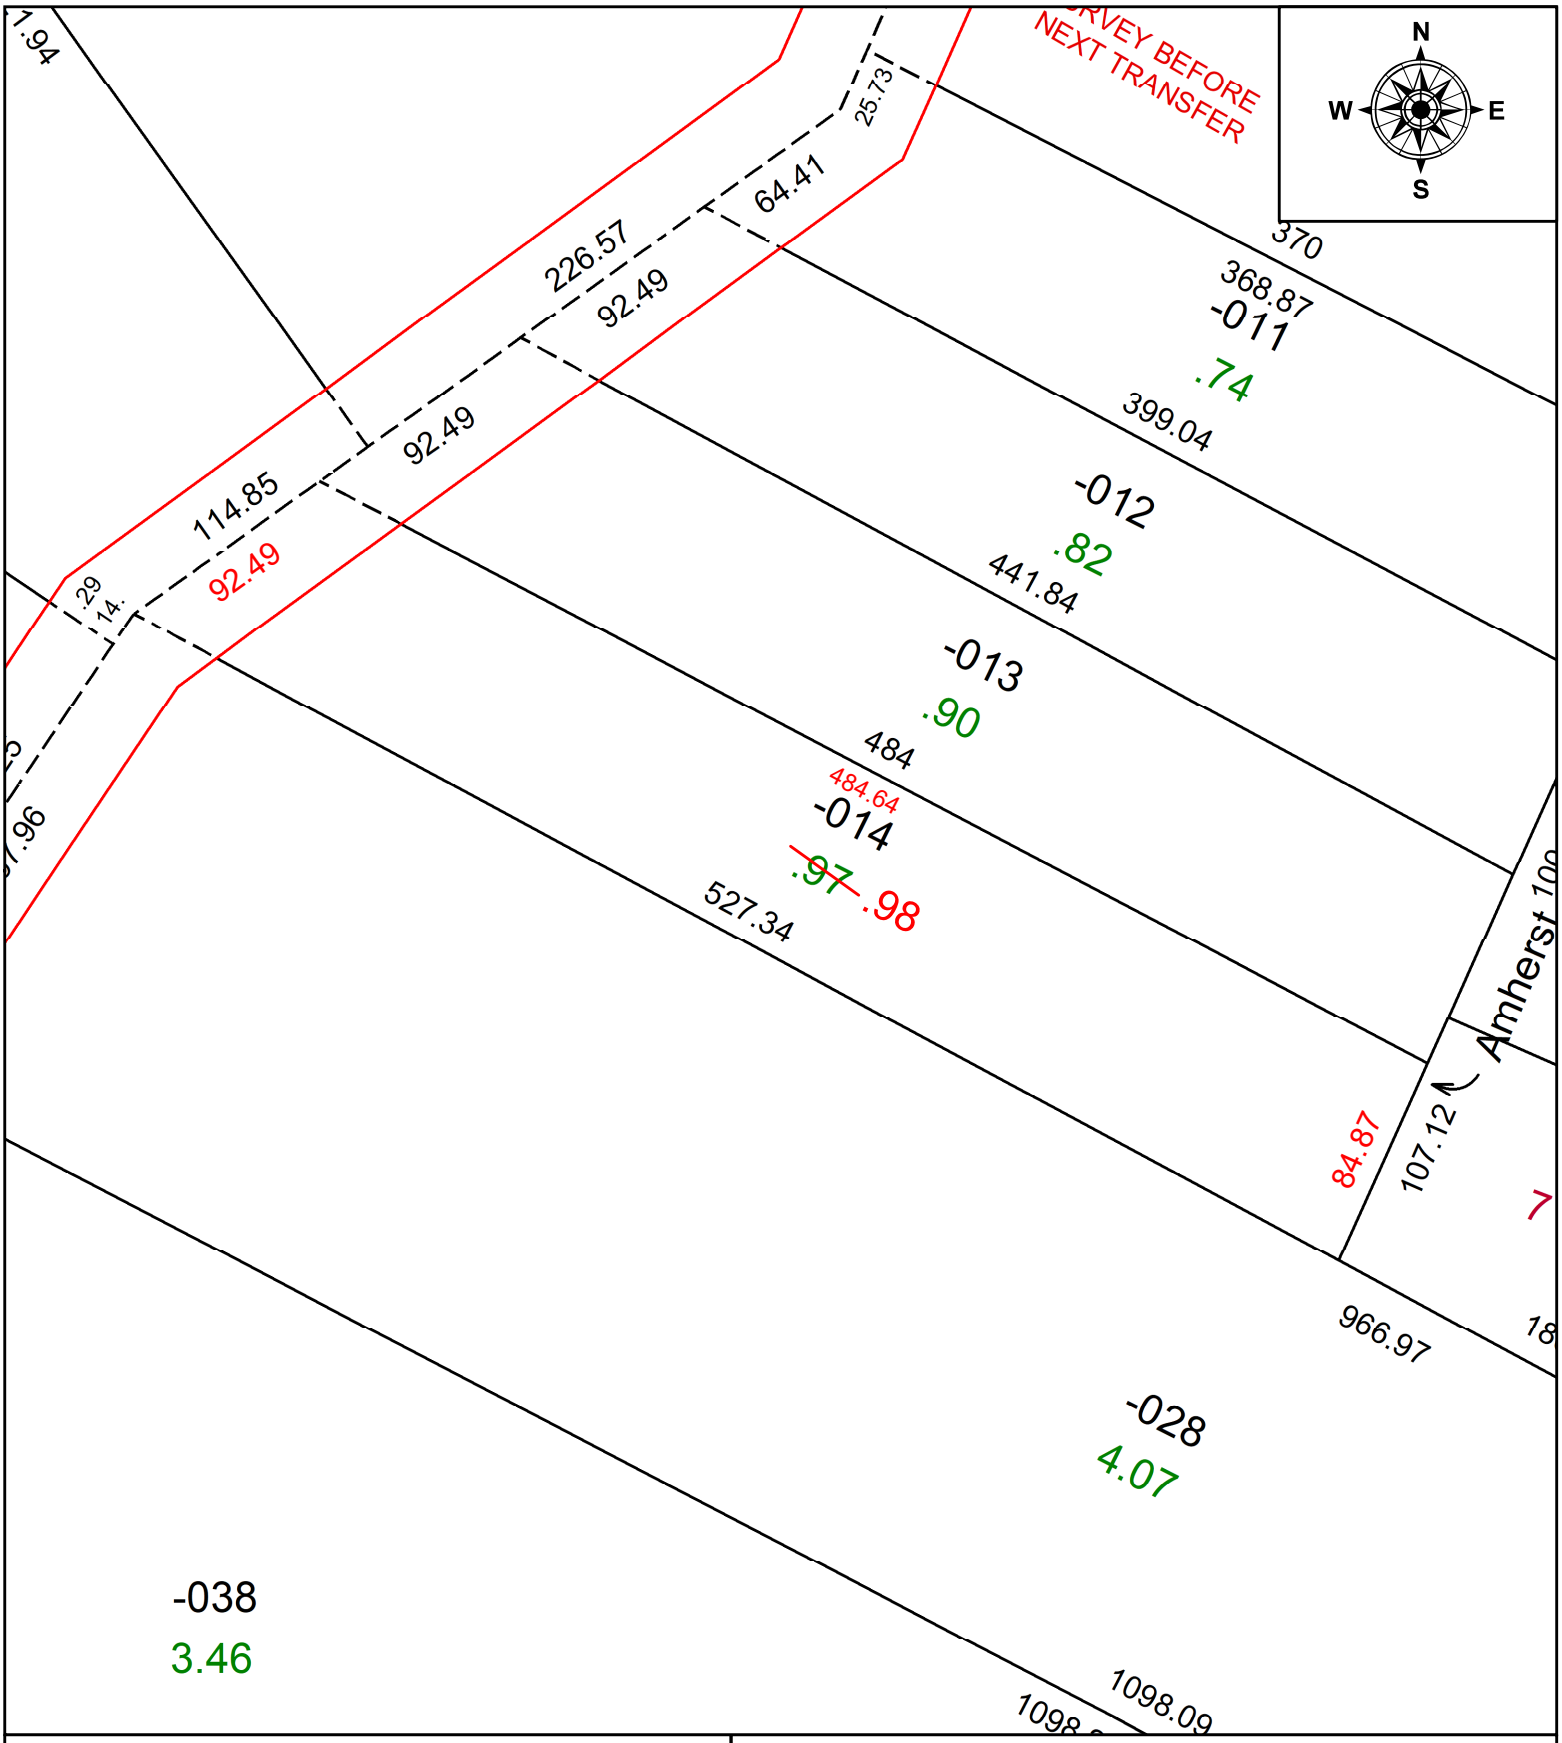

SPLITS/DEEDS PROCESSED

LORAIN COUNTY TAX MAP DEPARTMENT
226 MIDDLE AVE. ELYRIA, OH

SURVEYED BY: N/A **SURVEY #:** N/A

CLOSURE: N/A

MAP PAGE(S): 05-00-016

APPOVED BY: DMA **DATE:** 10/19/2023

SCALE: 1" = 75' **PRIOR INSTRUMENT:** 1997-0462927