PARENT PARCEL: 05-00-016-102-010 & -020
CHILD PARCEL: 05-00-016-102-039
STARTING POINT: AC CORR PER SURV BY THOMAS A. SIMON

23-05181-C

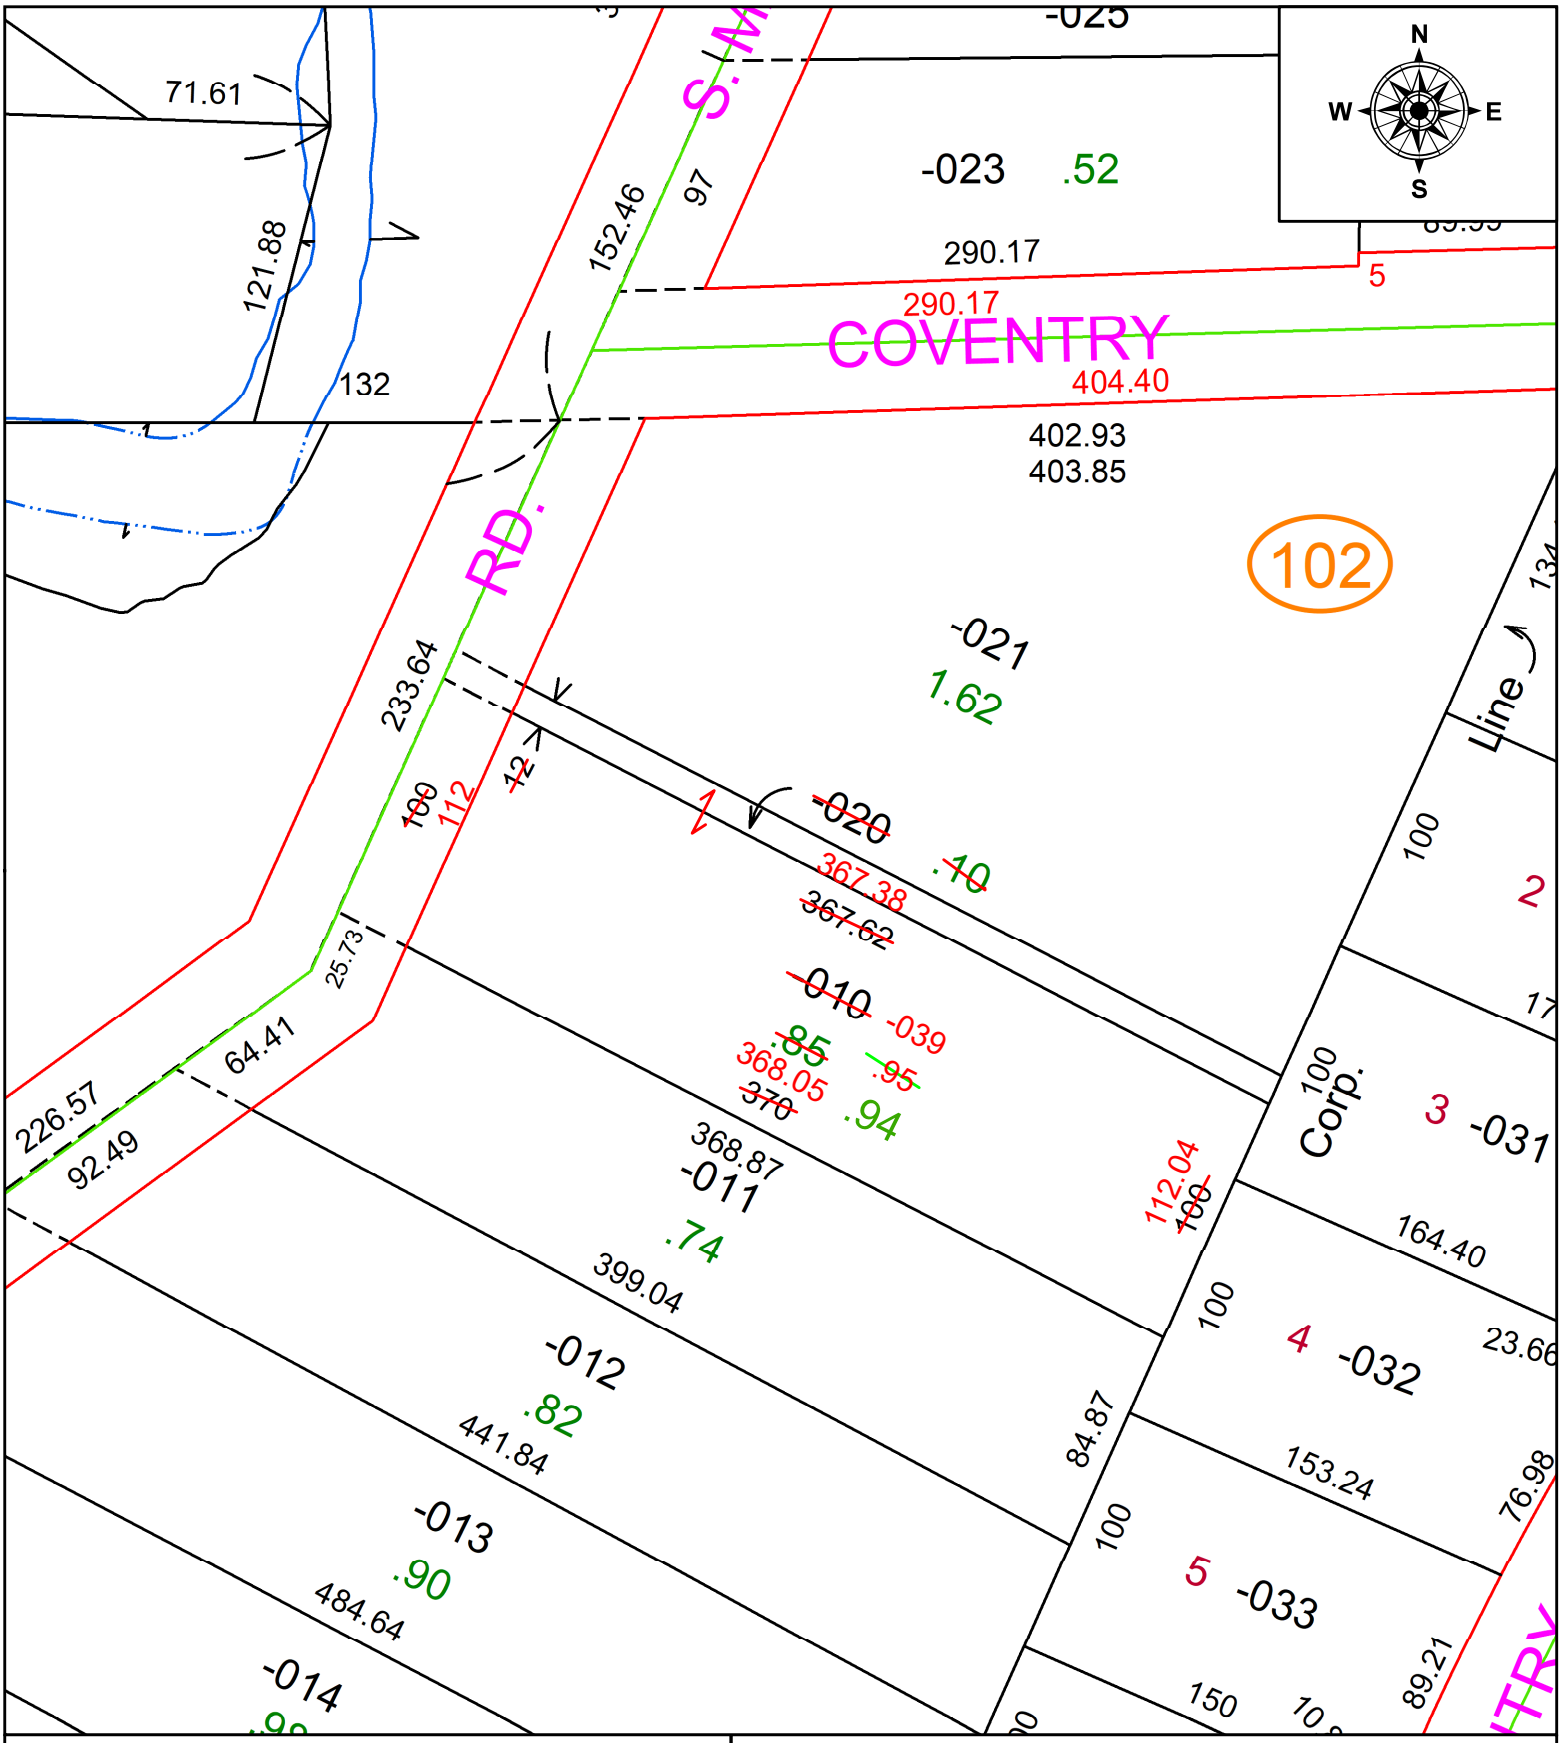

SPLITS/DEEDS PROCESSED
LORAIN COUNTY TAX MAP DEPARTMENT
226 MIDDLE AVE. ELYRIA, OH

SURVEYED BY: THOMAS A. SIMON **SURV # 51040**
CLOSURE: 1: 332450
MAP PAGE(S): 05-00-016
APPOVED BY: AC **DATE:** October 27, 2023
SCALE: 1 in = 75 ft **PRIOR INSTRUMENT:** 2023- 0913778