PARENT PARCEL: 05-00-044-000-007

CHILD PARCEL: AC. CORR. PER SURVEY BRYANT ABT

STARTING POINT: C/L OF LEAVITT RD. & RICE INDUSTRIAL PKWY

23-05195-A

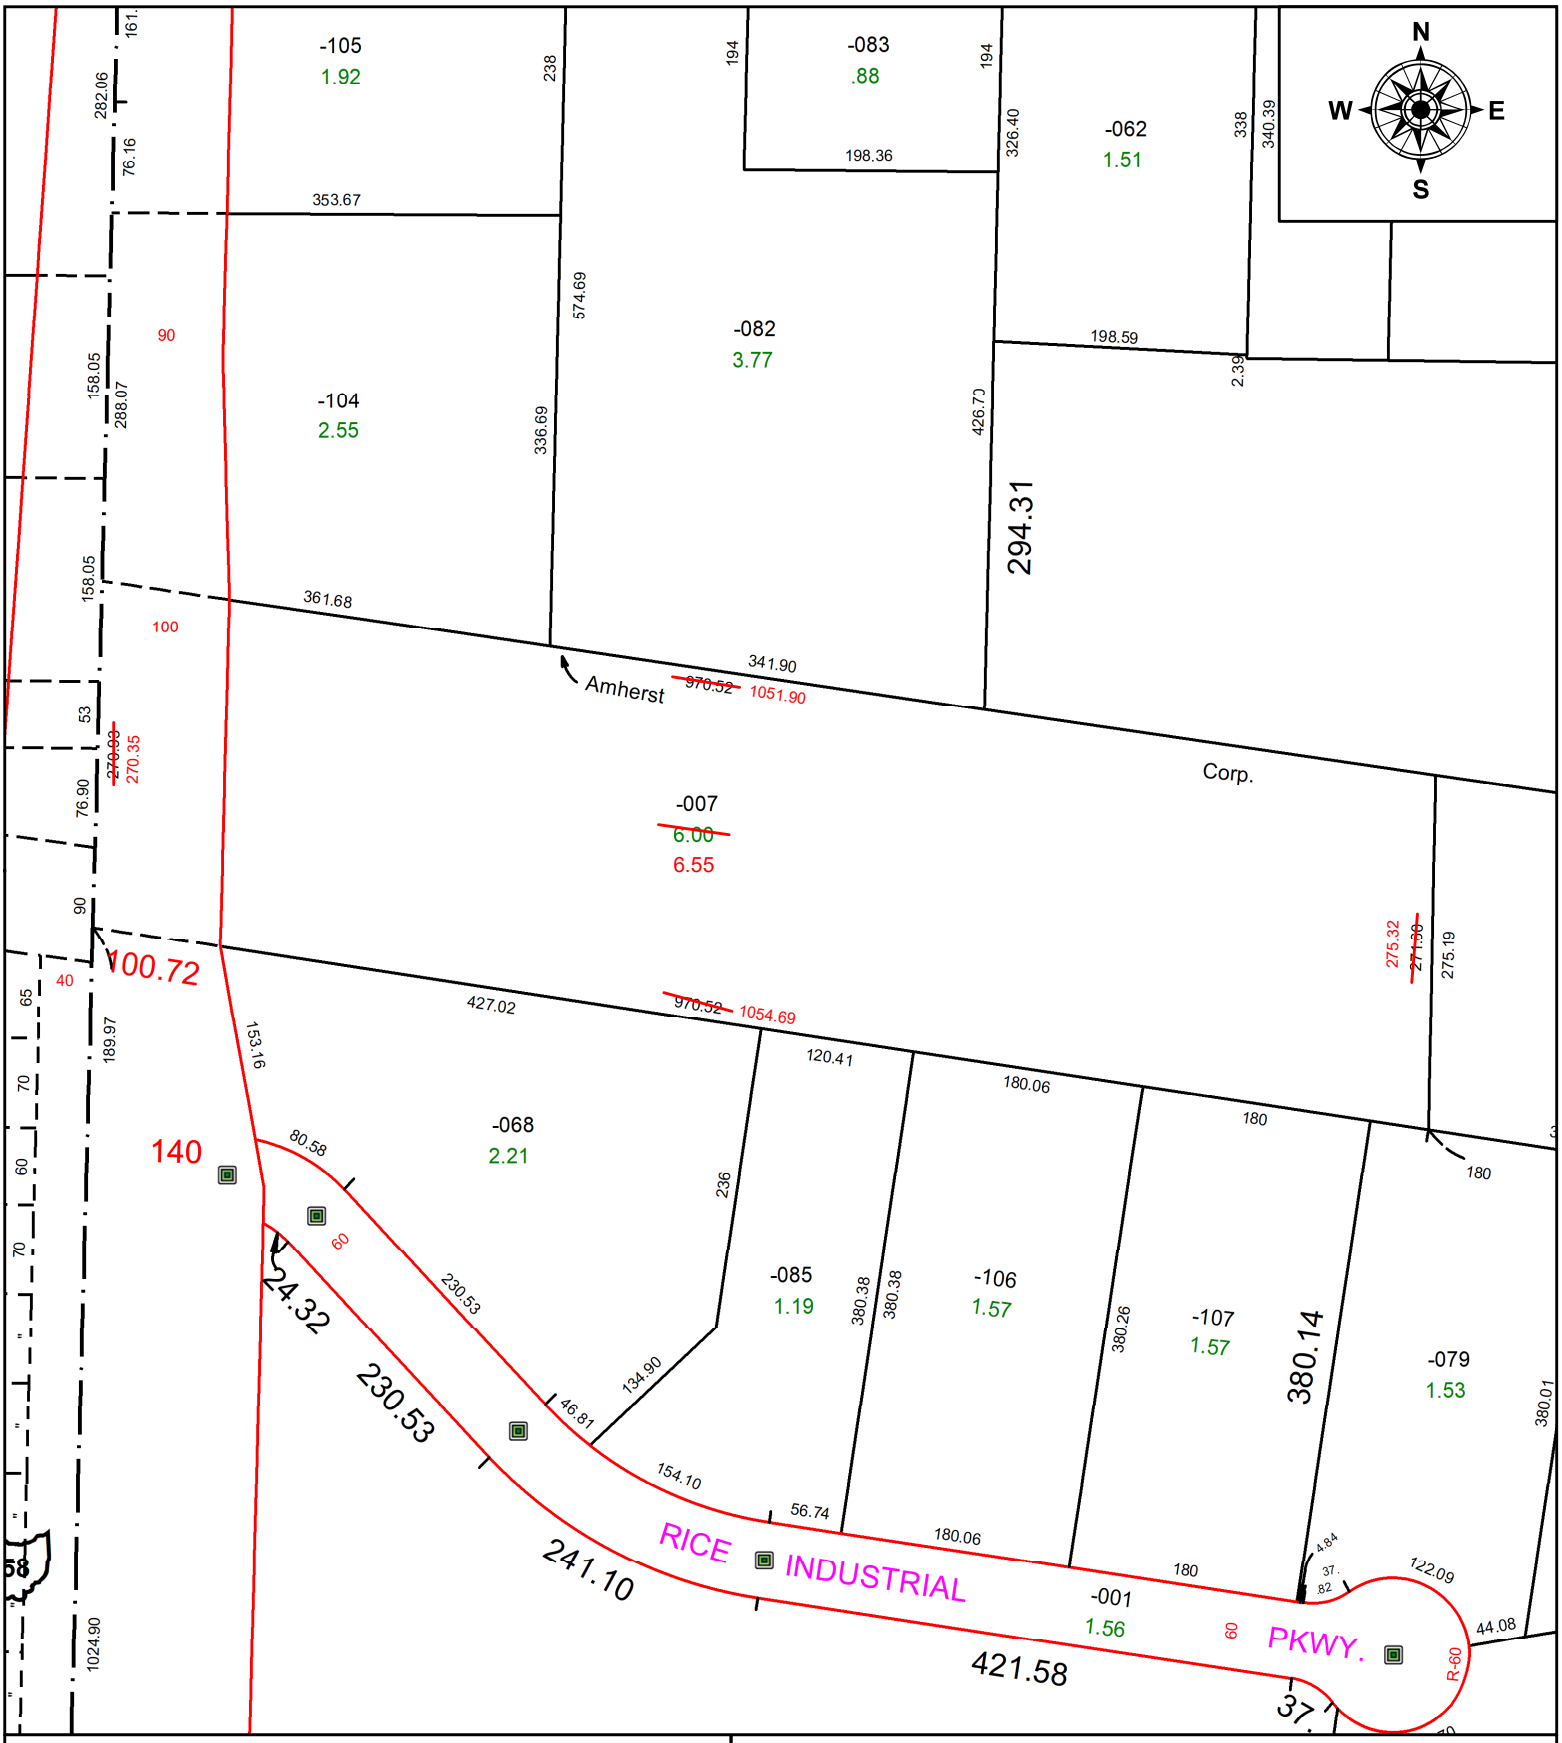

SPLITS/DEEDS PROCESSED

LORAIN COUNTY TAX MAP DEPARTMENT
226 MIDDLE AVE. ELYRIA, OH

SURVEYED BY: BRYANT ABT **SURVEY #:** 51062

CLOSURE: 1:715665

MAP PAGE(S): 05-00-044

APPOVED BY: DMA **DATE:** 11/20/2023

SCALE: 1" = 150' **PRIOR INSTRUMENT:** 2007-0219658