PARENT PARCEL: 09-00-084-107-007 & -037

CHILD PARCEL: FRONT & DEPTH TO AC CORR PER SURV BY RICHARD A. FREDRICKSON

STARTING POINT: C/L OF W COLLEGE ST AND PROSPECT ST

23-05197-C

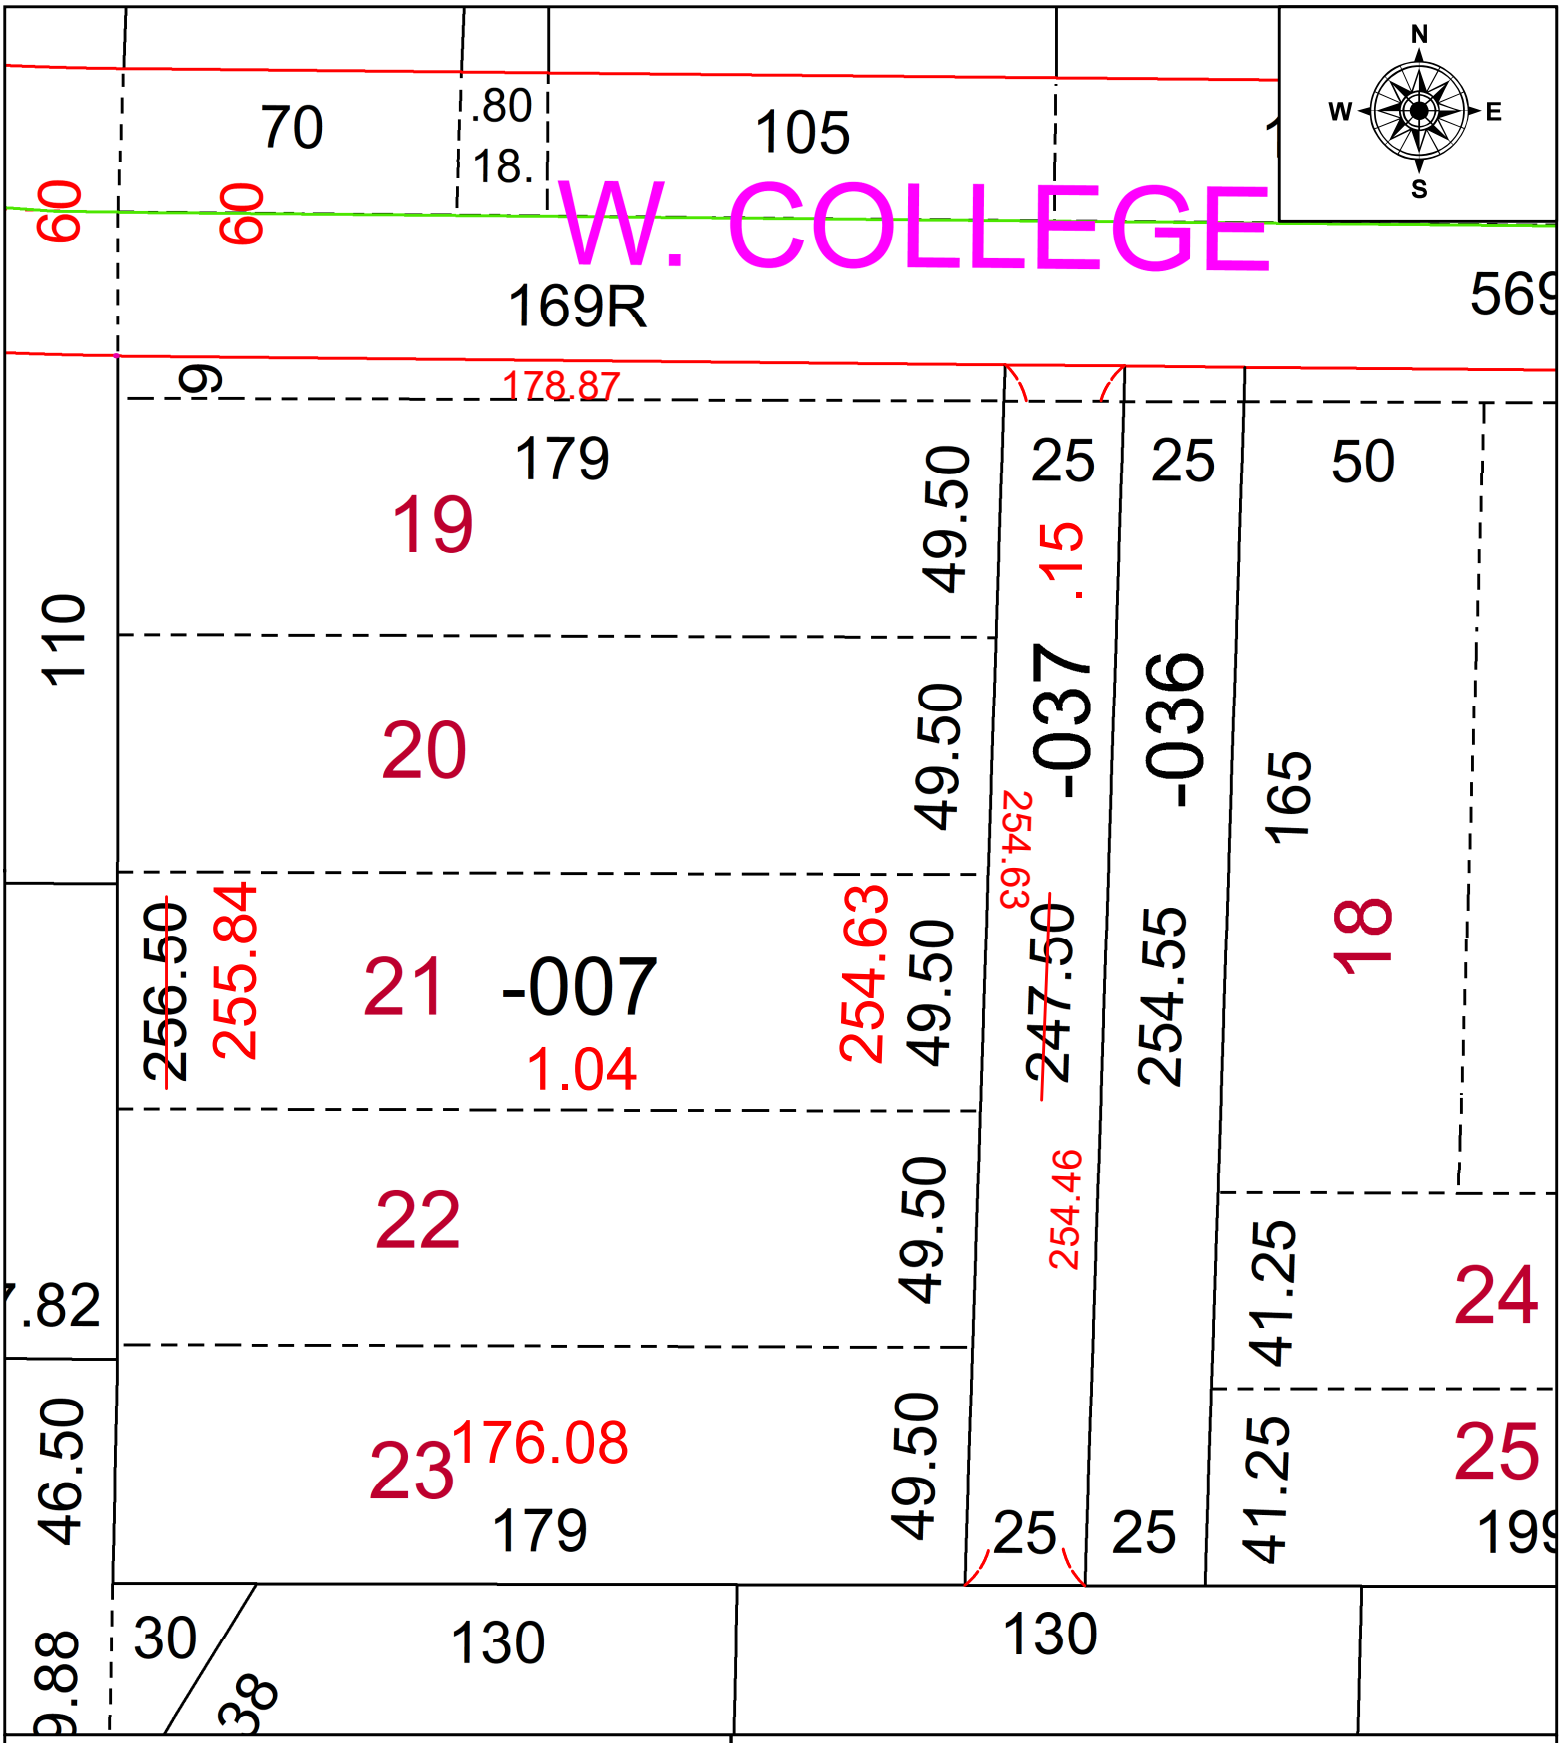

SPLITS/DEEDS PROCESSED

LORAIN COUNTY TAX MAP DEPARTMENT
226 MIDDLE AVE. ELYRIA, OH

SURVEYED BY: RICHARD A. FREDRICKSON **SURV # 51058**

CLOSURE: 1: 100789

MAP PAGE(S): 09-00-084

APPOVED BY: AC **DATE:** November 21, 2023

SCALE: 1 in = 40 ft **PRIOR INSTRUMENT:** 2023- 0934388