**PARENT PARCEL:** 18-00-033-000-010

**CHILD PARCEL:** AC CORR PER SURVEYOR THOMAS SNEZEK

**STARTING POINT:** MAG NAIL @ INTERSECTION OF C/L OF MEDINA-NORWALK RD & SOUTHEASTERLY CORNER OF O.L. 33

# 23-05209-A

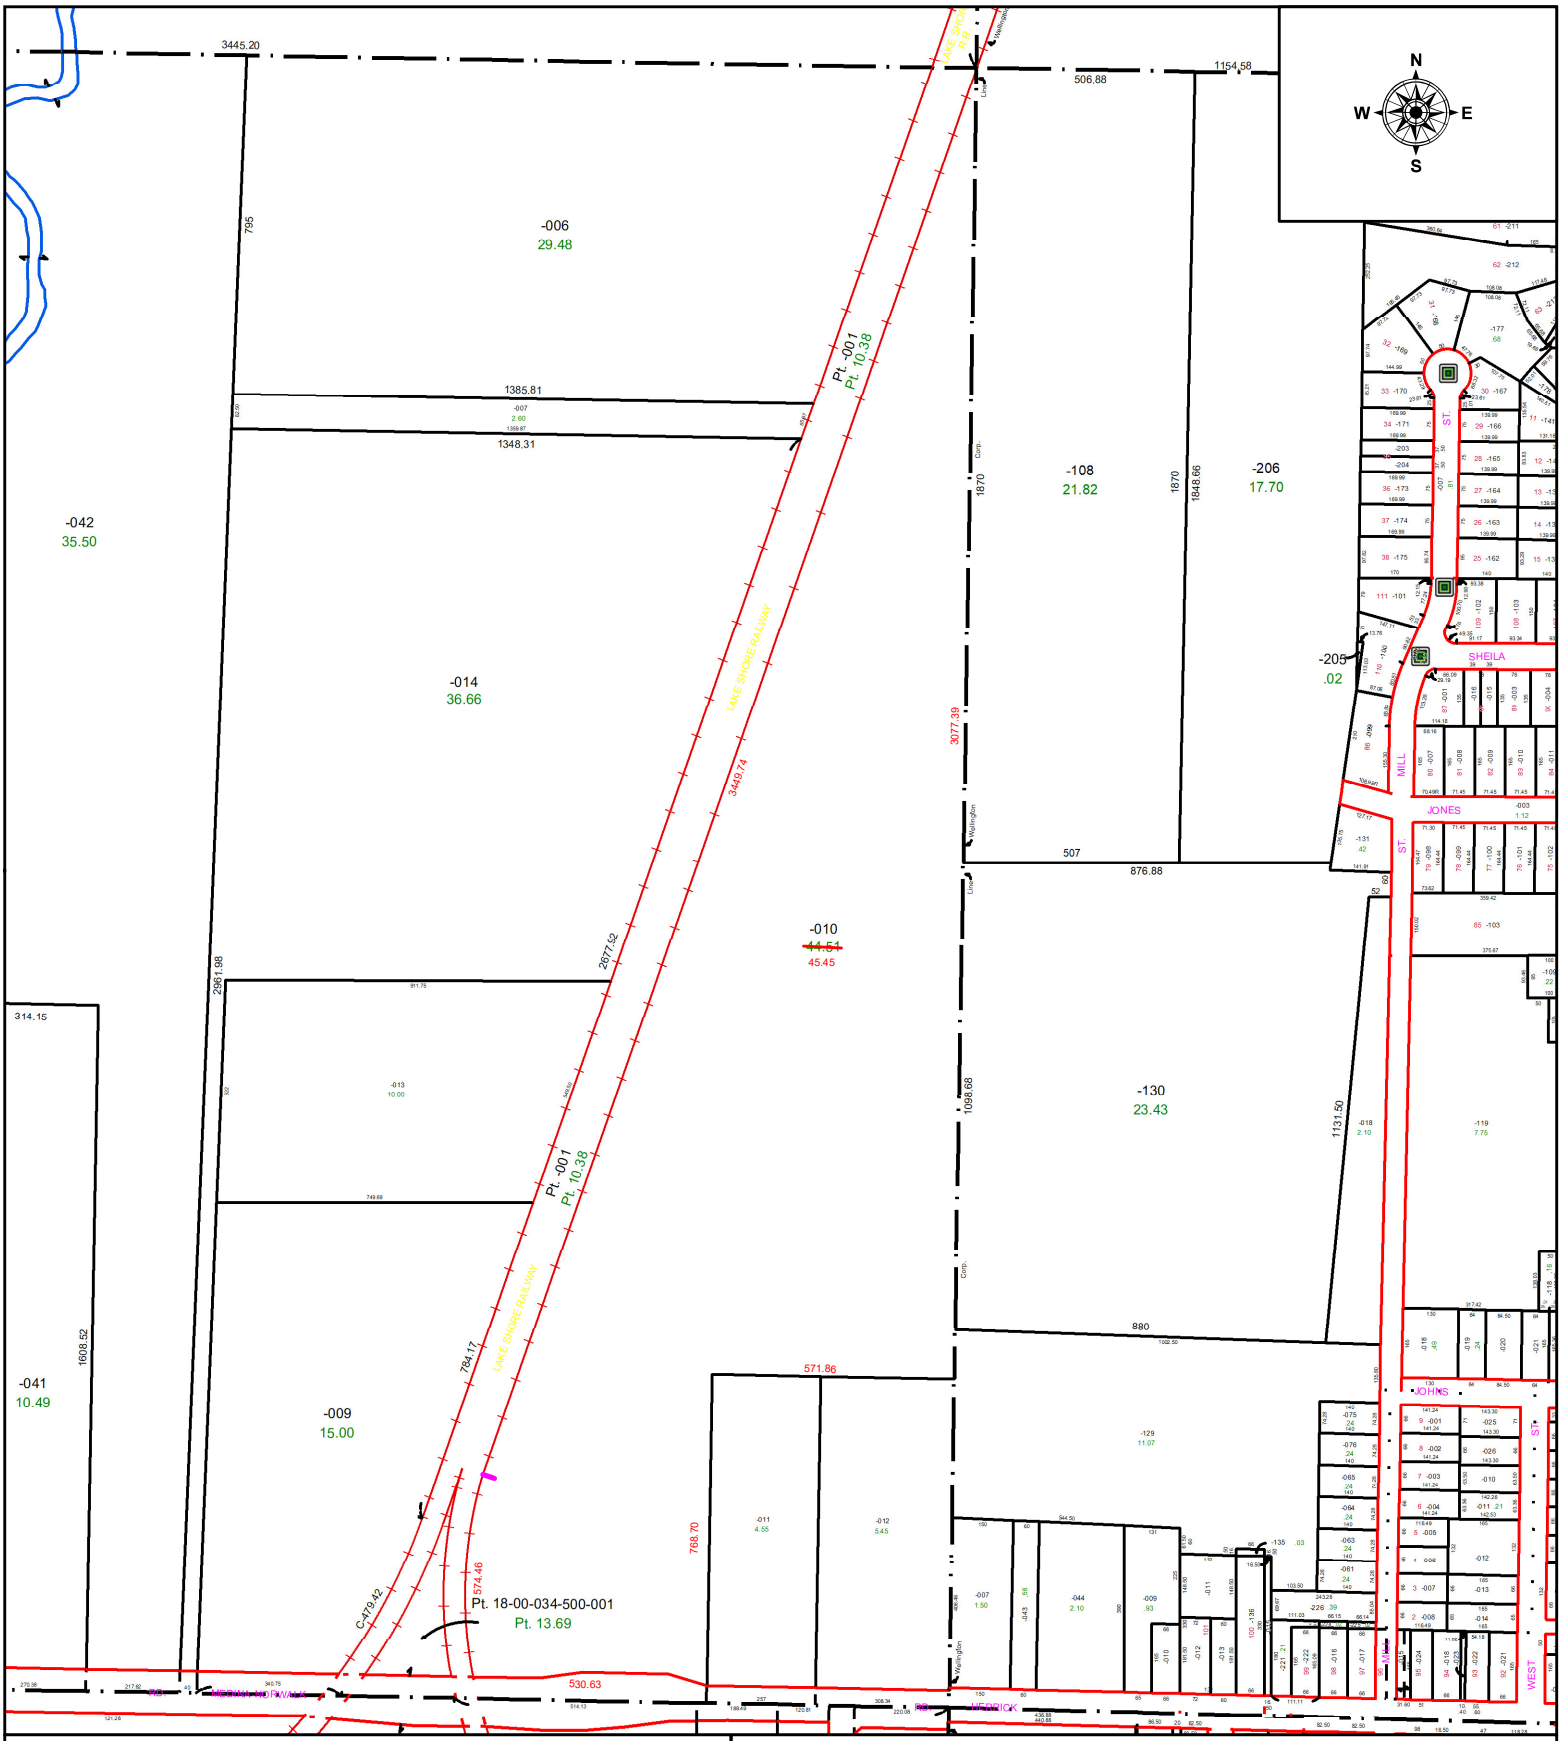


**SPLITS/DEEDS PROCESSED**

LORAIN COUNTY TAX MAP DEPARTMENT
226 MIDDLE AVE. ELYRIA, OH

**SURVEYED BY:** THOMAS SNEZEK SURVEY # 51091

**CLOSURE:** 1: 1300556

**MAP PAGE(S):** 18-00-033

**APPOVED BY:** WRZ **DATE:** 12/19/2023

**SCALE:** 1" = 450 **PRIOR INSTRUMENT:** #2014-0521979