PARENT PARCEL: 12-00-043-000-019
CHILD PARCEL: MAP CORRECTION ONLY
STARTING POINT: SW CORNER OF SUBLOT 1 AND N LINE OF NICHOLS RD

23-05210-C

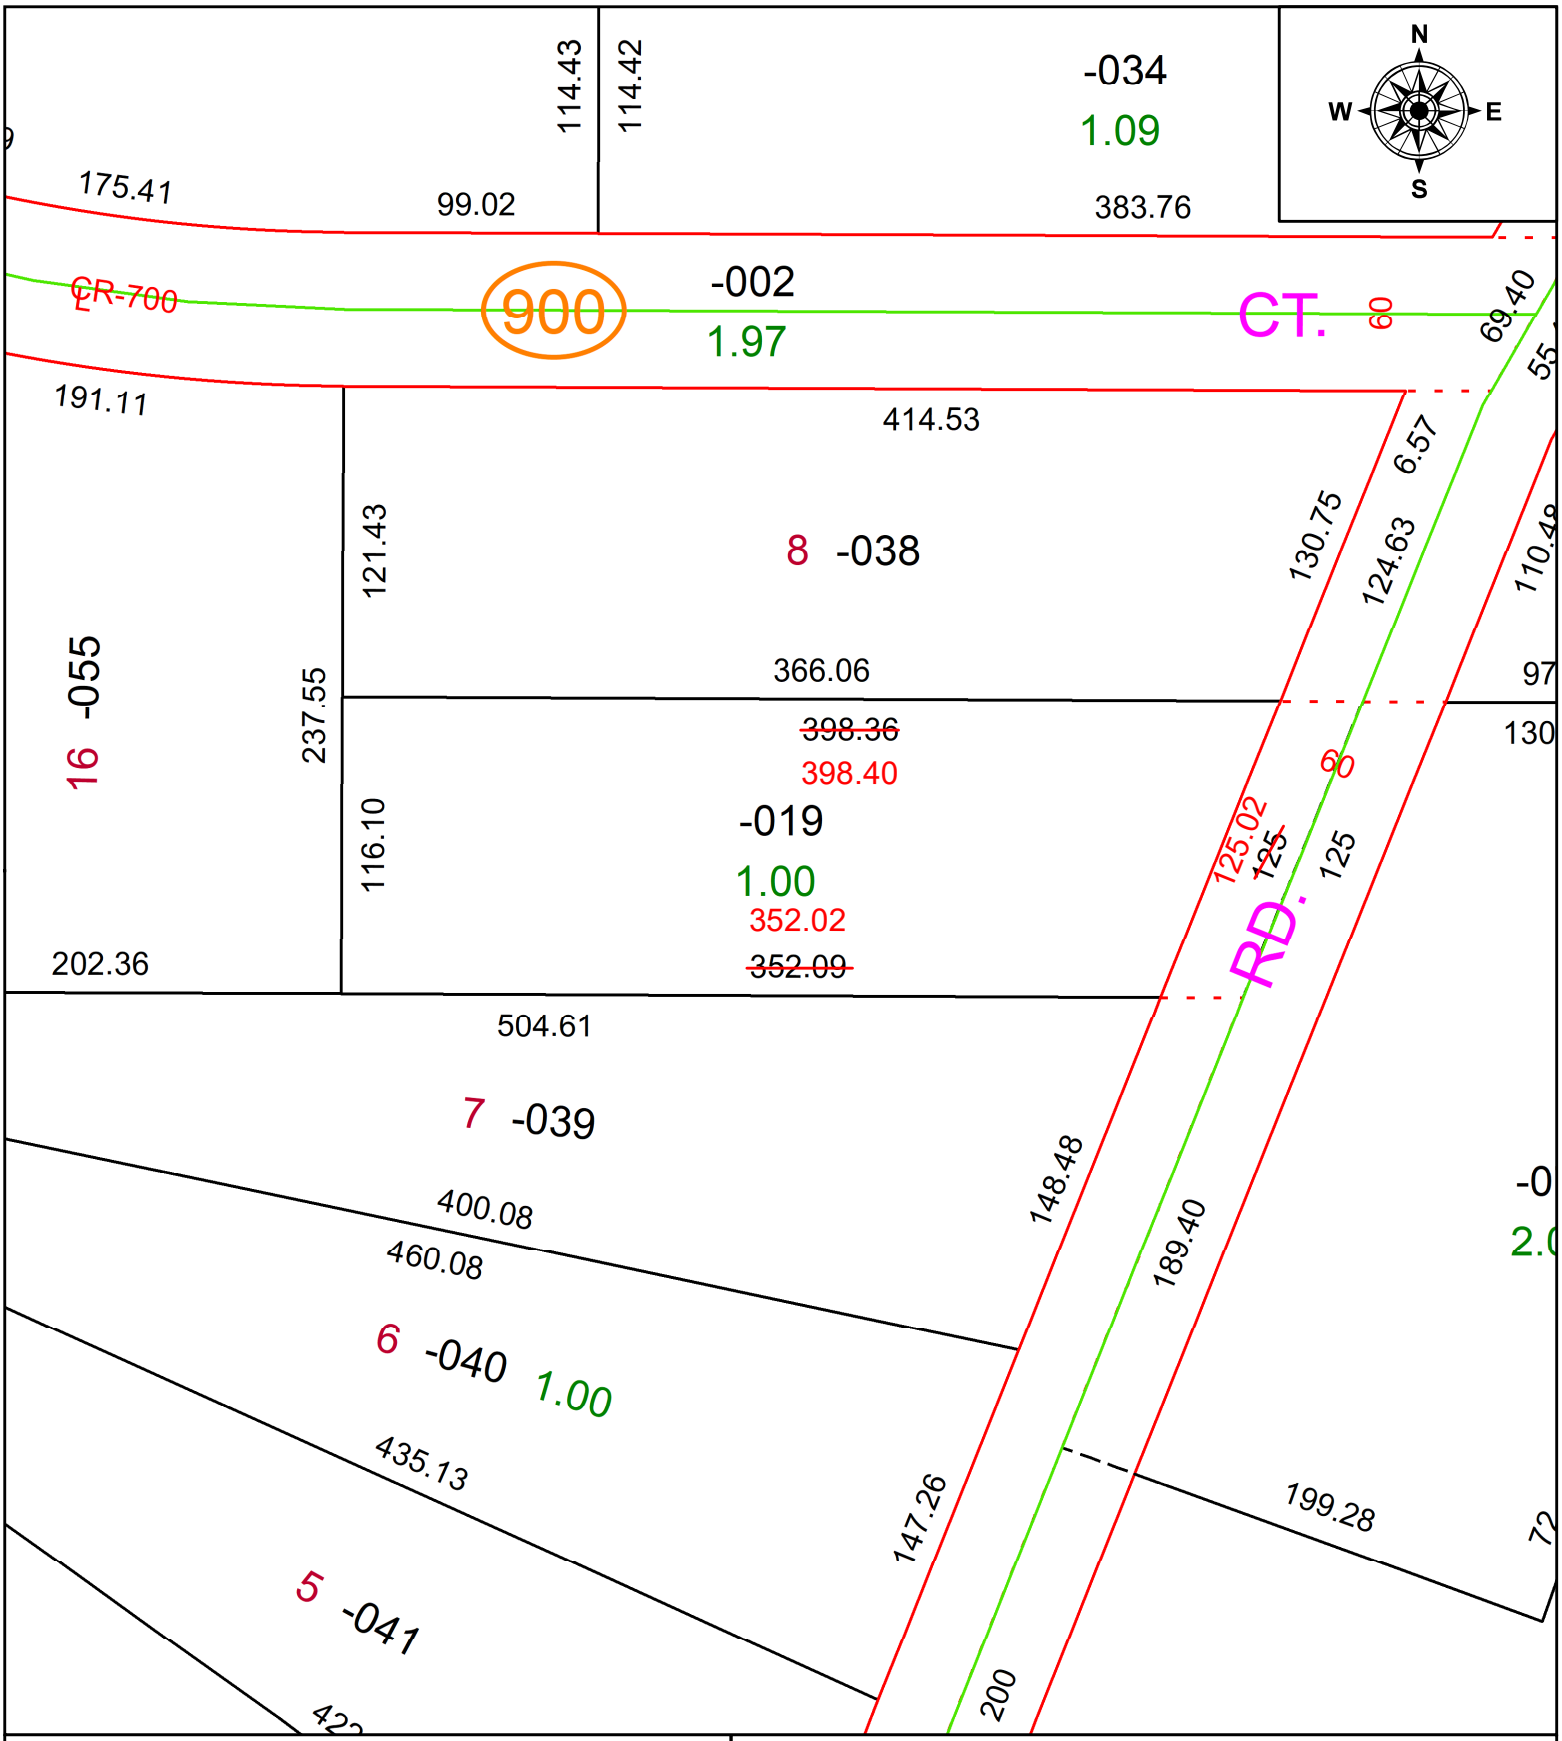

SPLITS/DEEDS PROCESSED
LORAIN COUNTY TAX MAP DEPARTMENT
226 MIDDLE AVE. ELYRIA, OH

SURVEYED BY: SCOTT J. CASEY **SURV # 51082**
CLOSURE: 1: 546041
MAP PAGE(S): 12-00-043
APPOVED BY: AC **DATE:** December 12, 2023
SCALE: 1 in = 75 ft **PRIOR INSTRUMENT:** 2008- 0246269