PARENT PARCEL: 07-00-043-101-008

CHILD PARCEL: AC CORR PER SURVEYOR JOSHUA RIEDY

STARTING POINT: MONUMENT BOX @ INTERSECTION OF C/L OF CASE RD & NORTH LINE OF O.L. 43

23-05215-C

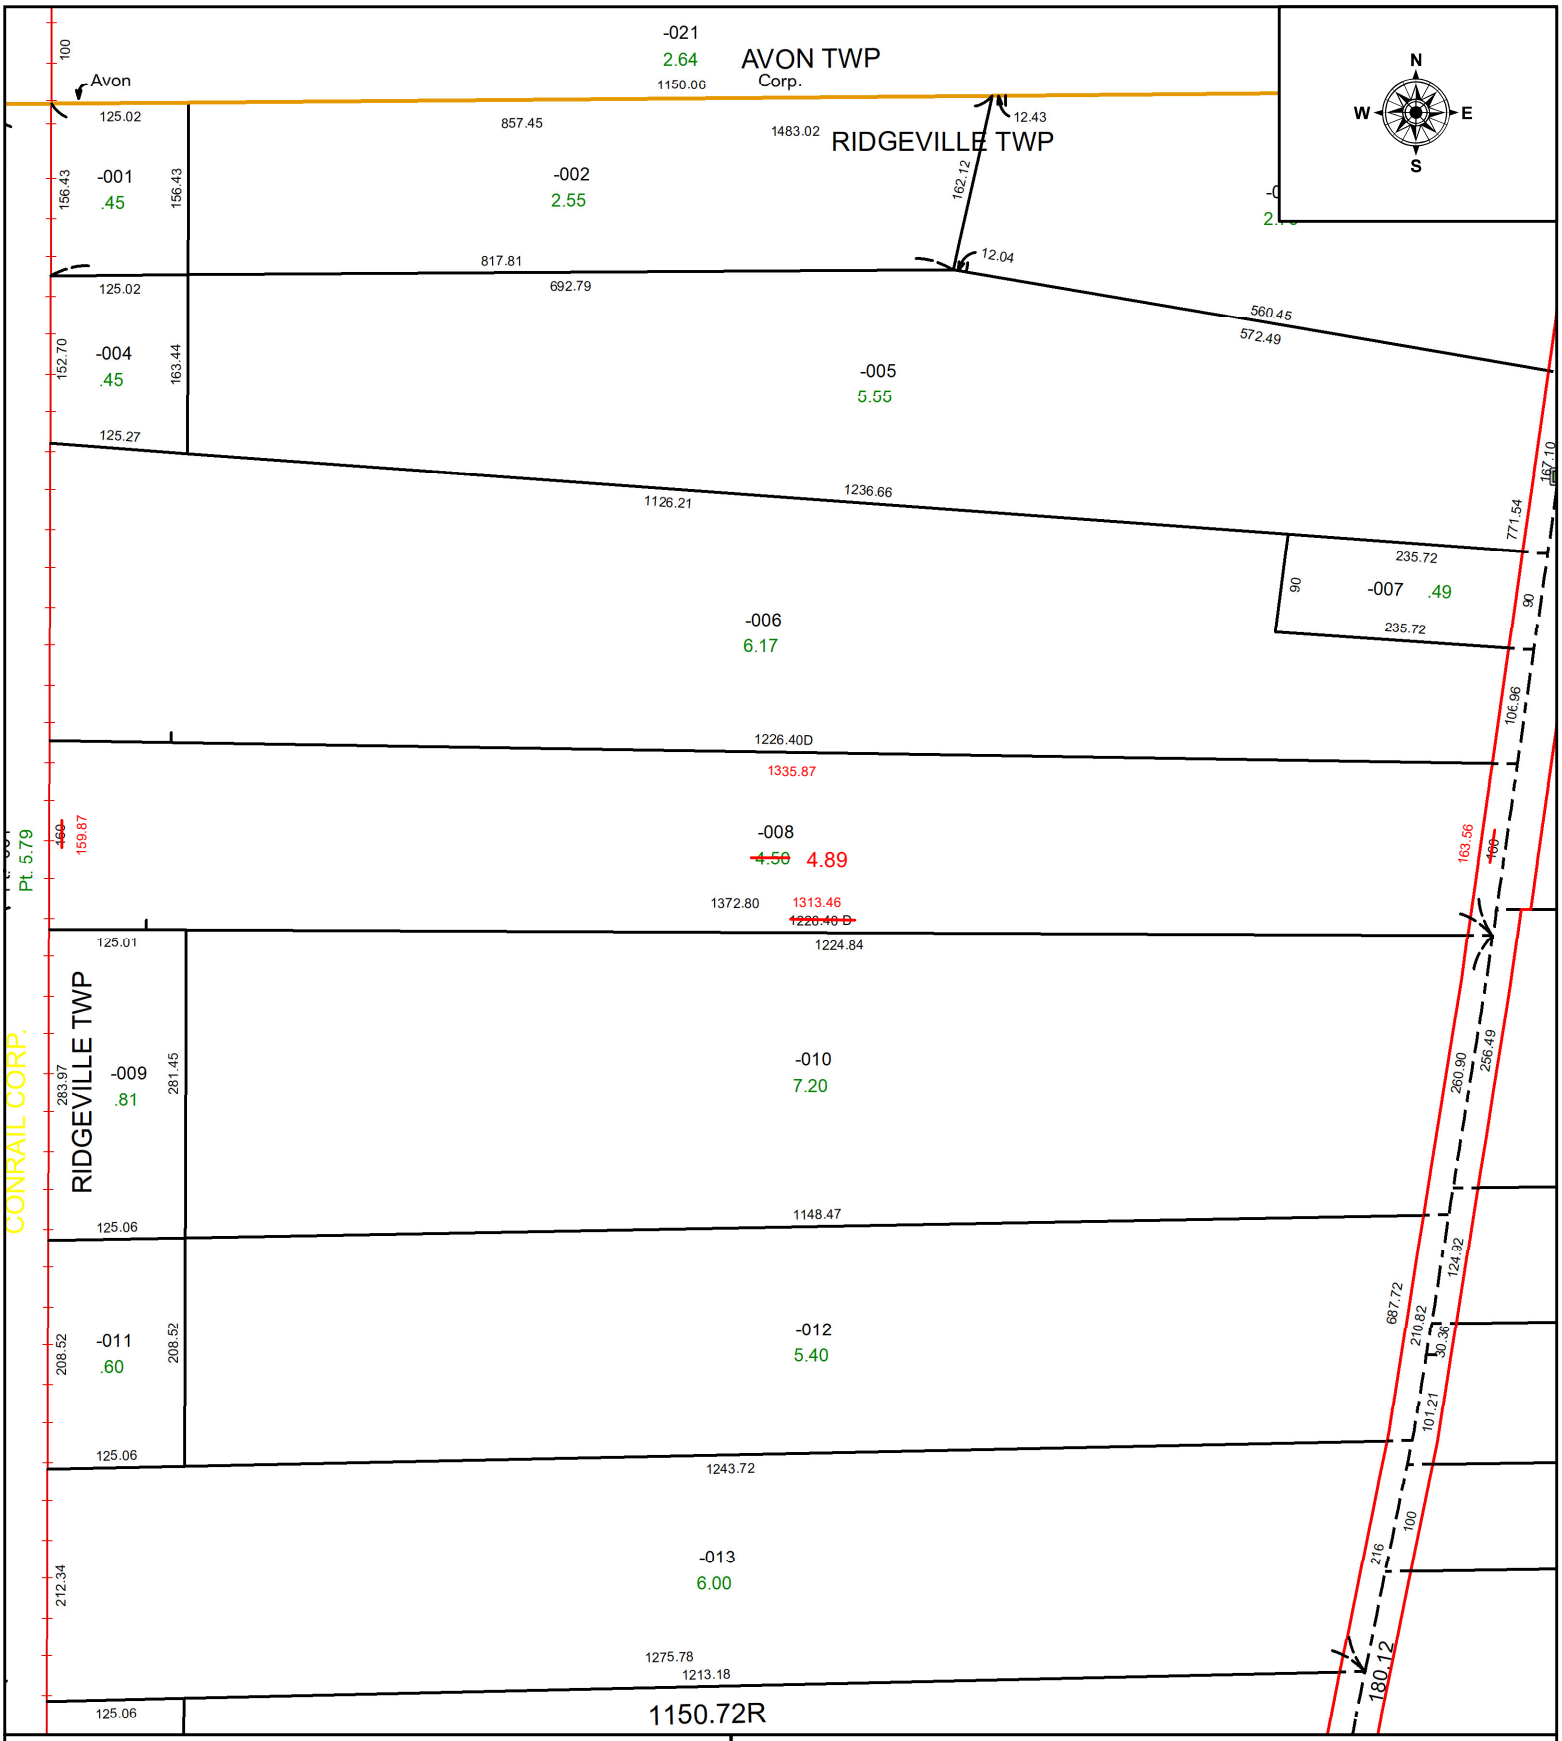

SPLITS/DEEDS PROCESSED

LORAIN COUNTY TAX MAP DEPARTMENT
226 MIDDLE AVE. ELYRIA, OH

SURVEYED BY: JOSHUA RIEDY SURVEY # 51090

CLOSURE: 1: 394109

MAP PAGE(S): 07-00-043

APPOVED BY: WRZ **DATE:** 12/18/2023

SCALE: 1" = 175 **PRIOR INSTRUMENT:** #2022-0863069