PARENT PARCEL: 06-24-030-000-101

CHILD PARCEL: AC CORR PER SURV BY THOMAS A. SIMON

STARTING POINT: NE CORNER OF VILLAGE GREEN CONDO PH. 1

24-05232-A

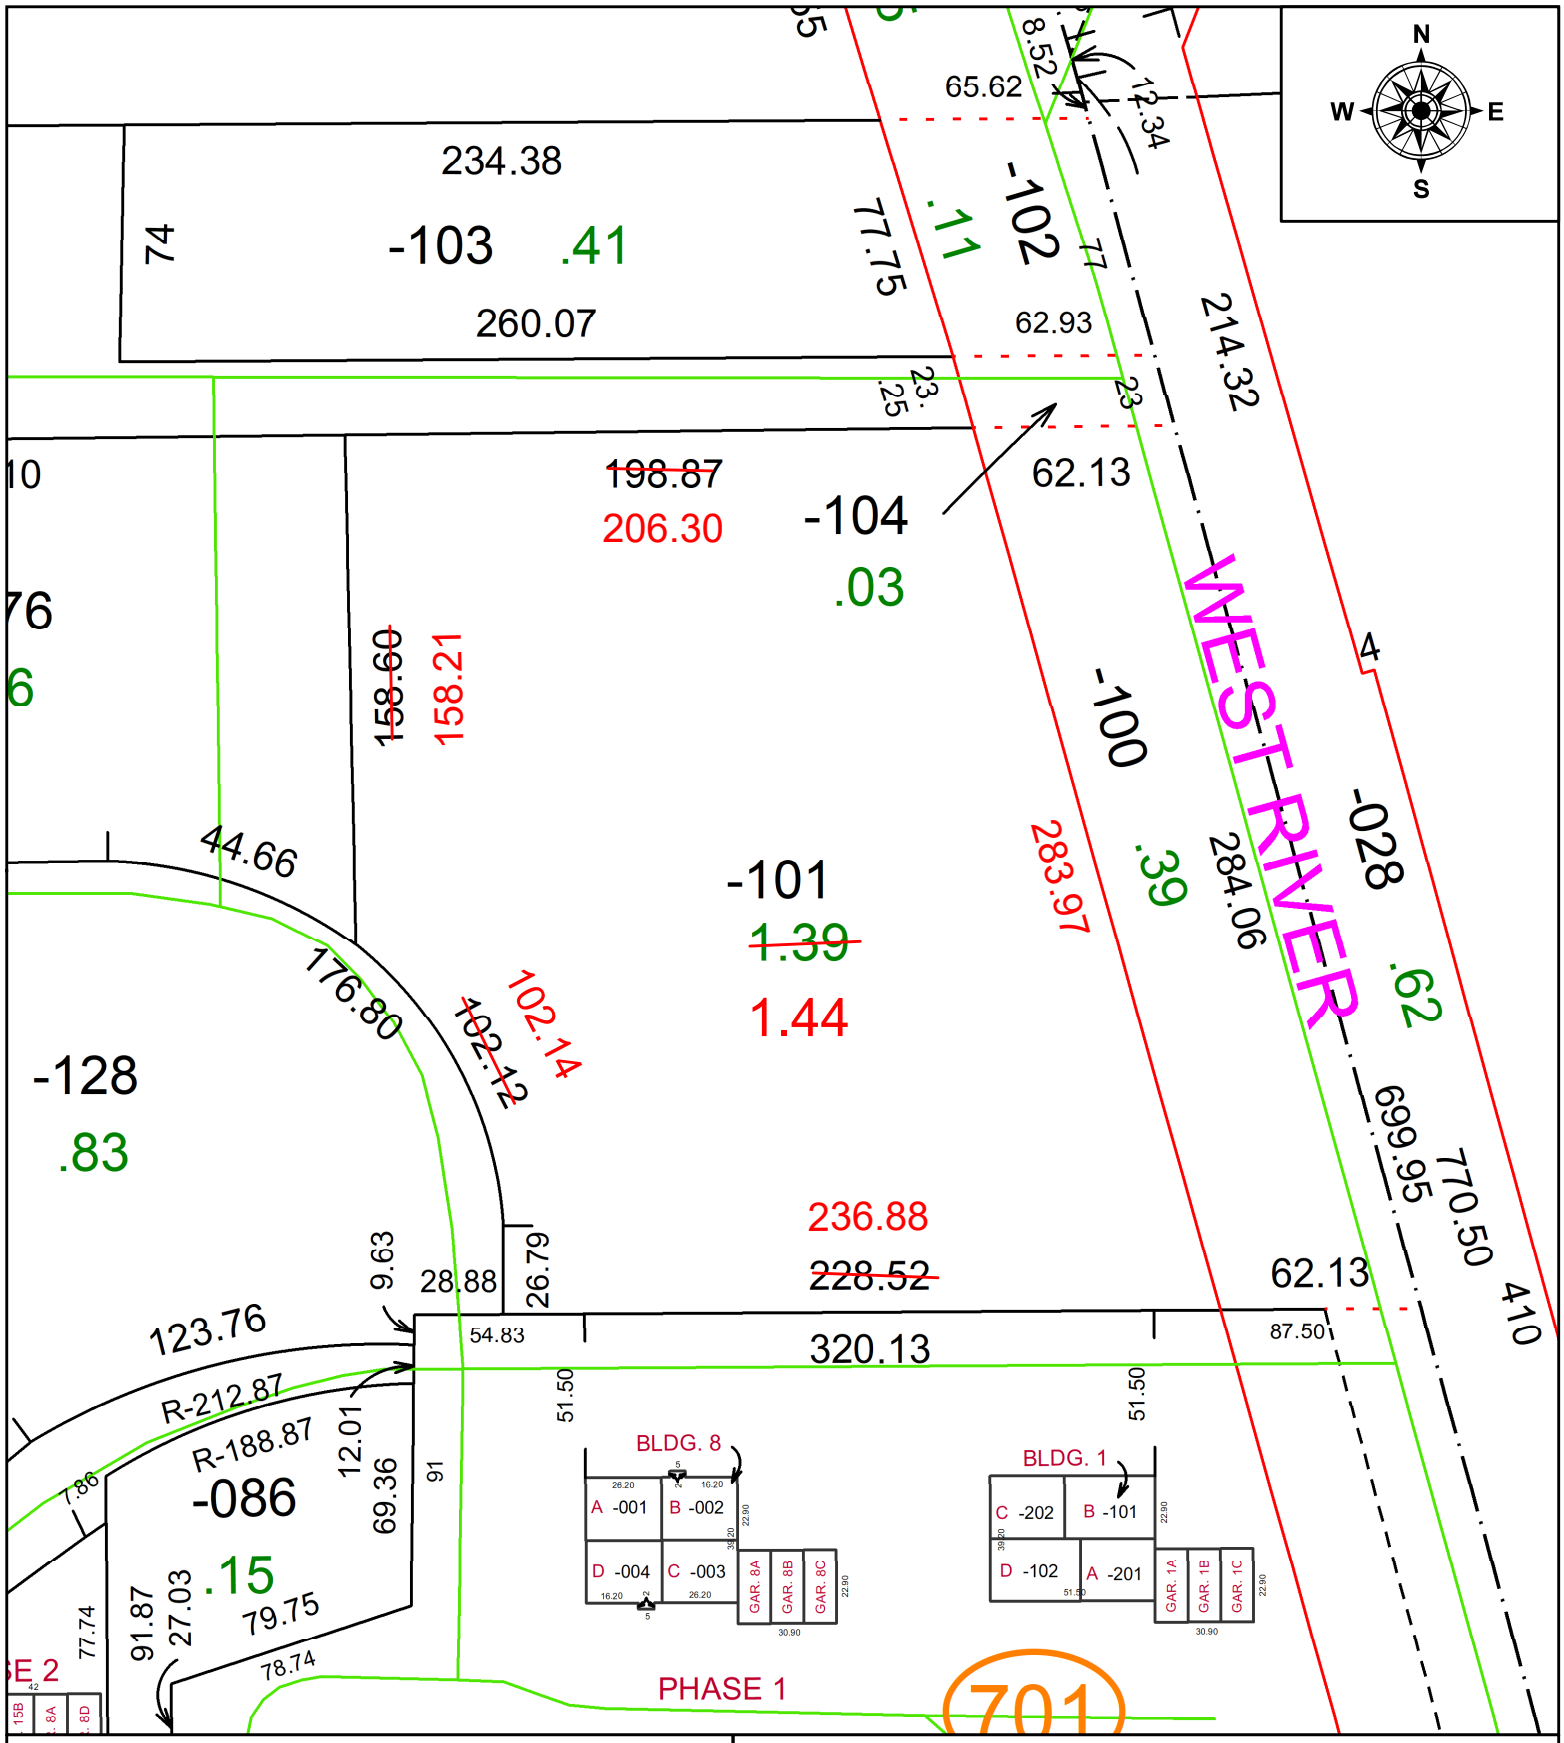

SPLITS/DEEDS PROCESSED

LORAIN COUNTY TAX MAP DEPARTMENT
226 MIDDLE AVE. ELYRIA, OH

SURVEYED BY: THOMAS A. SIMON **SURV # 51112**

CLOSURE: 1: 231066

MAP PAGE(S): 06-24-030

APPOVED BY: AC **DATE:** January 18, 2024

SCALE: 1 in = 60 ft **PRIOR INSTRUMENT:** 2014- 0499359