PARENT PARCEL: 03-00-108-107-018

CHILD PARCEL: AC CORR PER PRIOR DEED PER INSTRUMENT NO. 2007- 0210141

STARTING POINT:

24-05251-C

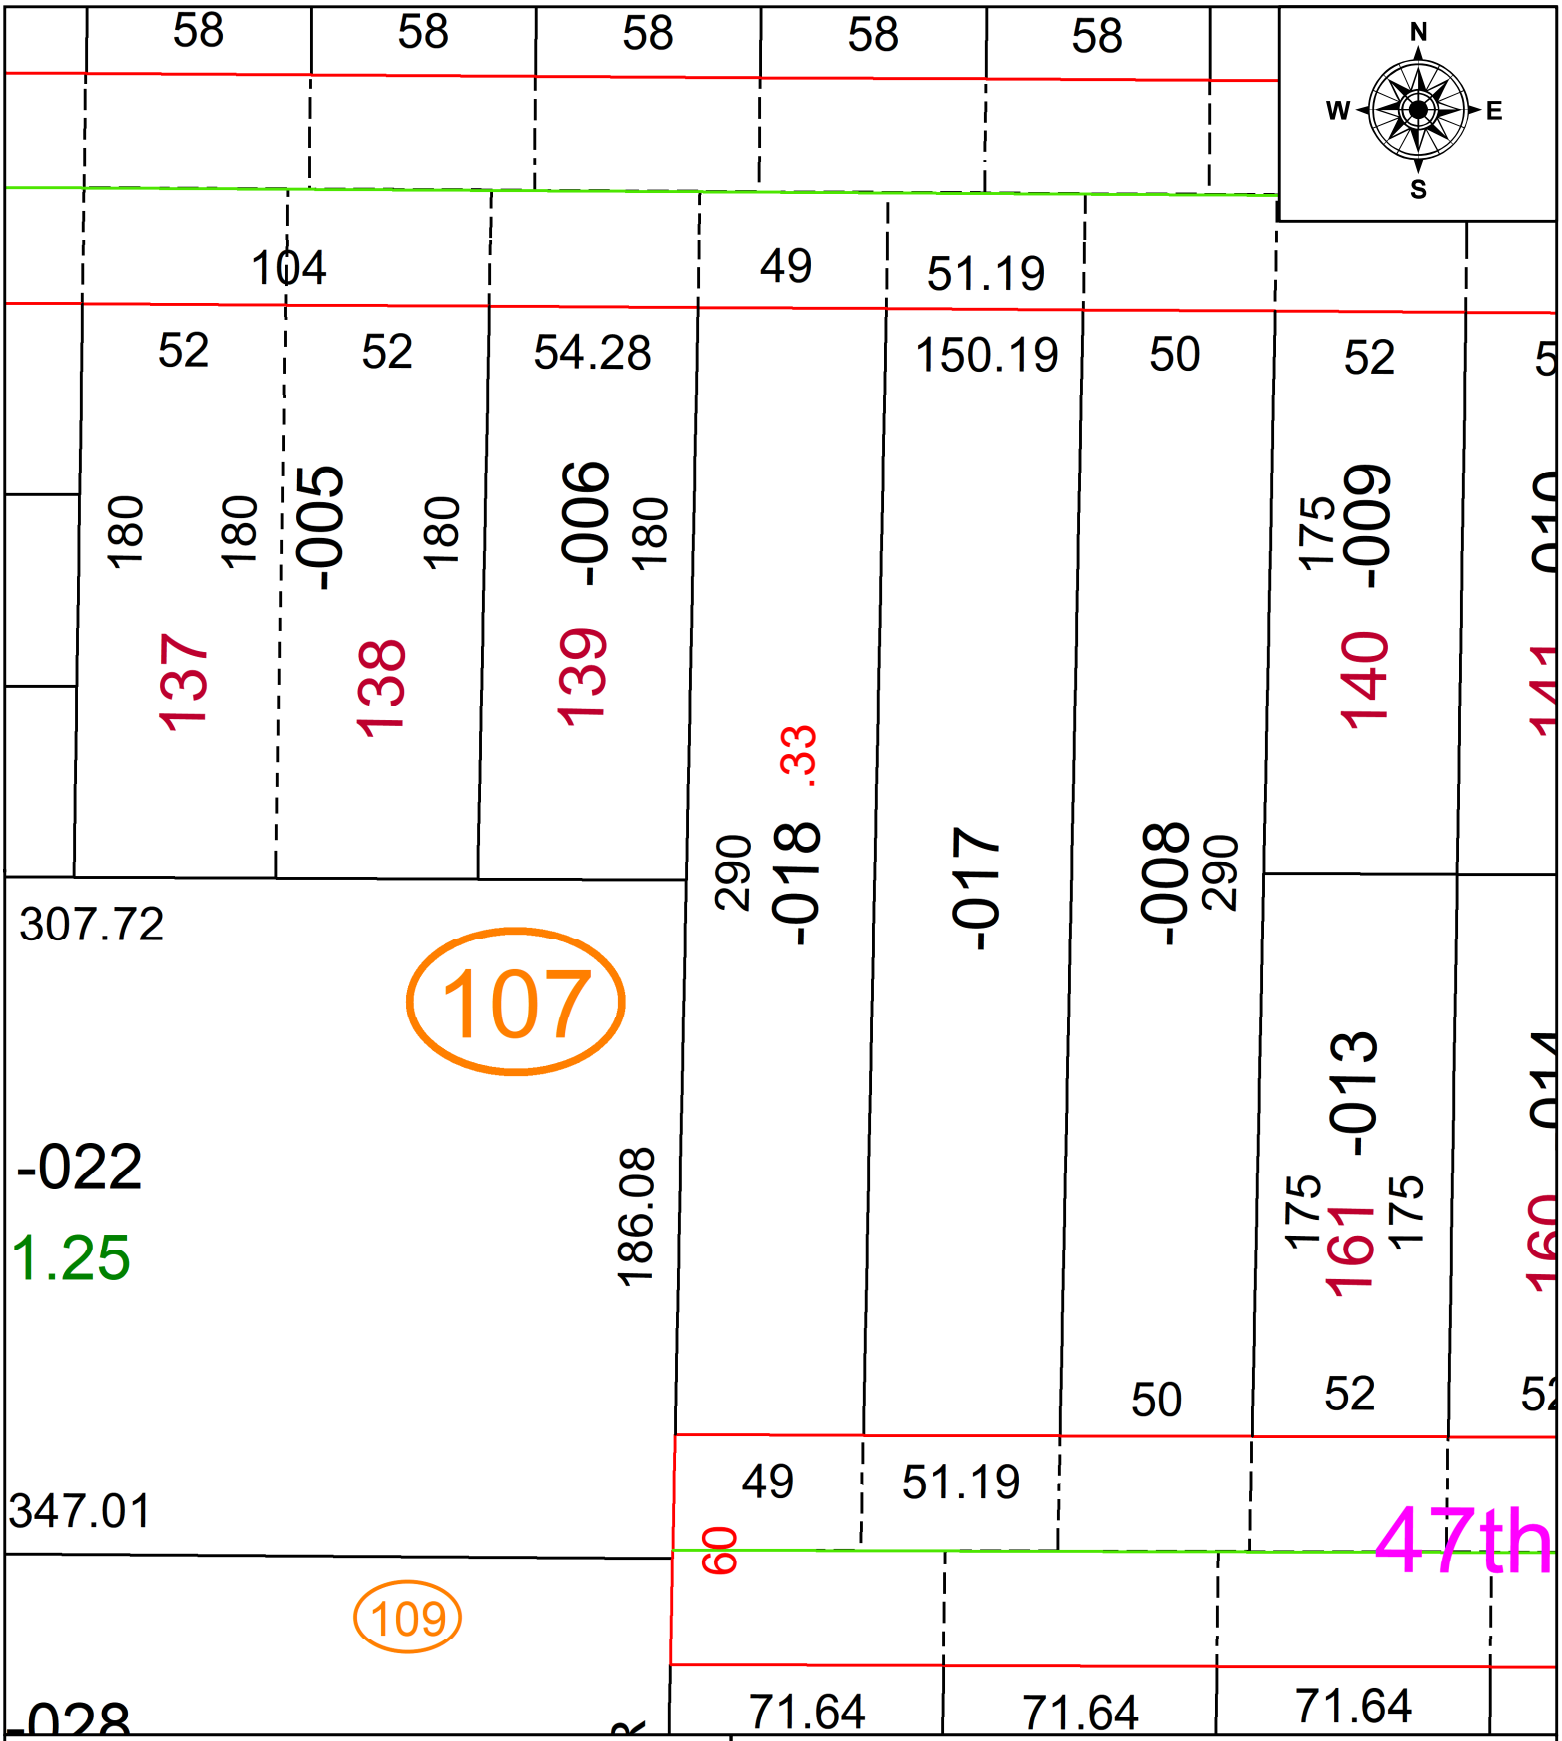

SPLITS/DEEDS PROCESSED

LORAIN COUNTY TAX MAP DEPARTMENT
226 MIDDLE AVE. ELYRIA, OH

SURVEYED BY: N/A **SURV # N/A**

CLOSURE: N/A

MAP PAGE(S): 03-00-108

APPOVED BY: AC **DATE:** February 22, 2024

SCALE: 1 in = 50 ft **PRIOR INSTRUMENT:** 2007- 0210141