PARENT PARCEL: 07-00-004-104-025

CHILD PARCEL: AC CORR PER SURV BY THOMAS A. SIMON

STARTING POINT: C/L OF MILLS CREEK LN AND CHEASTNUT RIDGE RD

24-05283-C

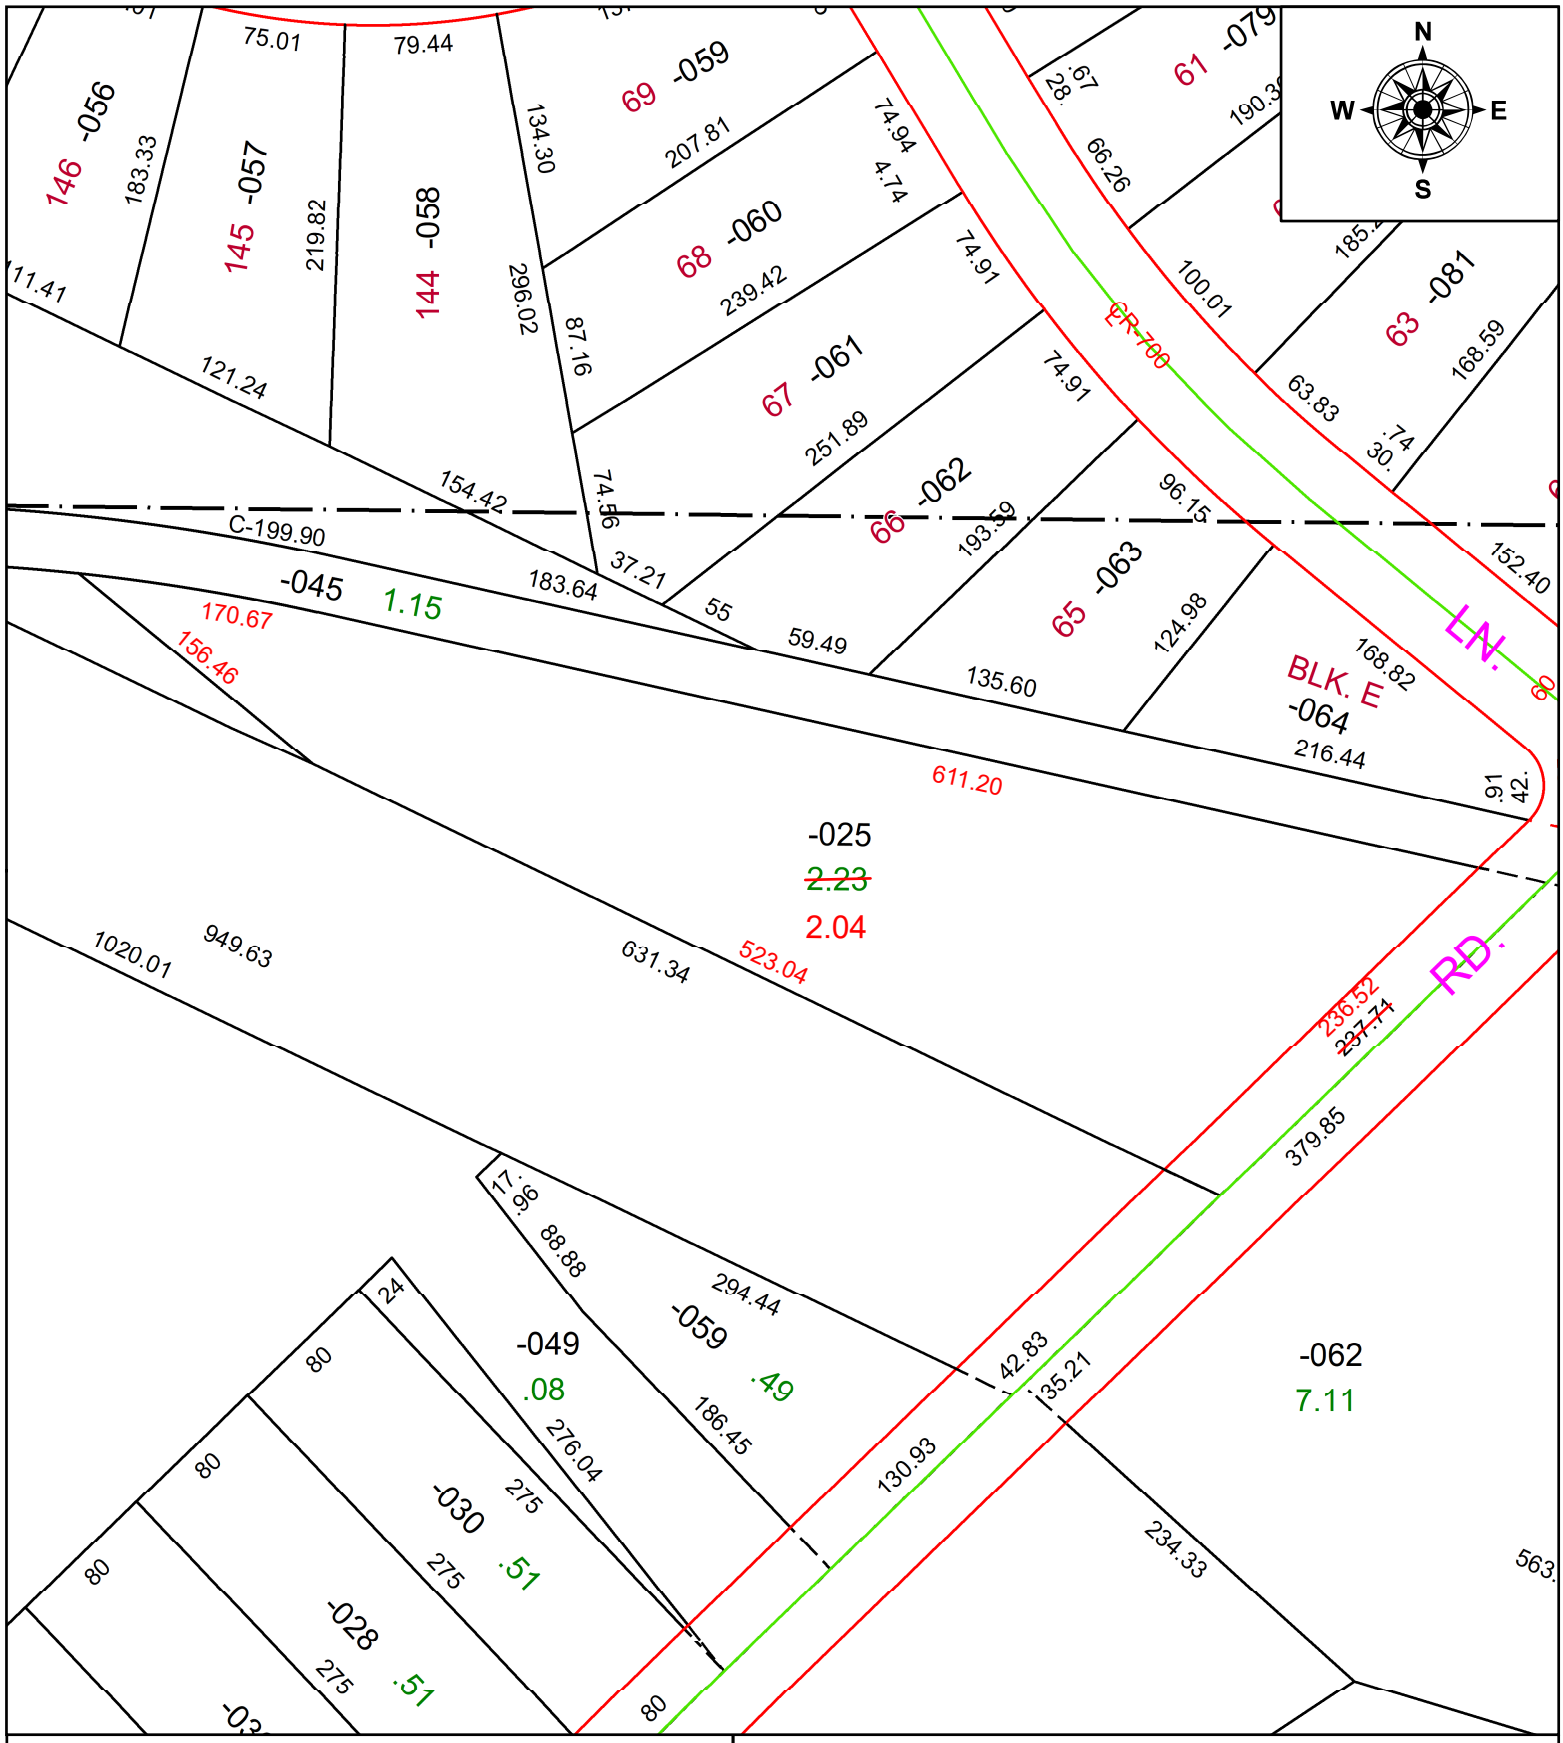

SPLITS/DEEDS PROCESSED

LORAIN COUNTY TAX MAP DEPARTMENT
226 MIDDLE AVE. ELYRIA, OH

SURVEYED BY: THOMAS A. SIMON **SURV # 51169**

CLOSURE: 1: 592227

MAP PAGE(S): 06-25-021

APPOVED BY: AC **DATE:** April 22, 2024

SCALE: 1 in = 100 ft **PRIOR INSTRUMENT:** 2021- 0827458