PARENT PARCEL: 01-00-027-000-055

CHILD PARCEL: MAP CORRECTION

STARTING POINT: I.P. FD. CL OF COOPER FOSTER RD. & EAST LINE OF LAND CONVEYED TO HIKADE OR 935/730

24-05286-C

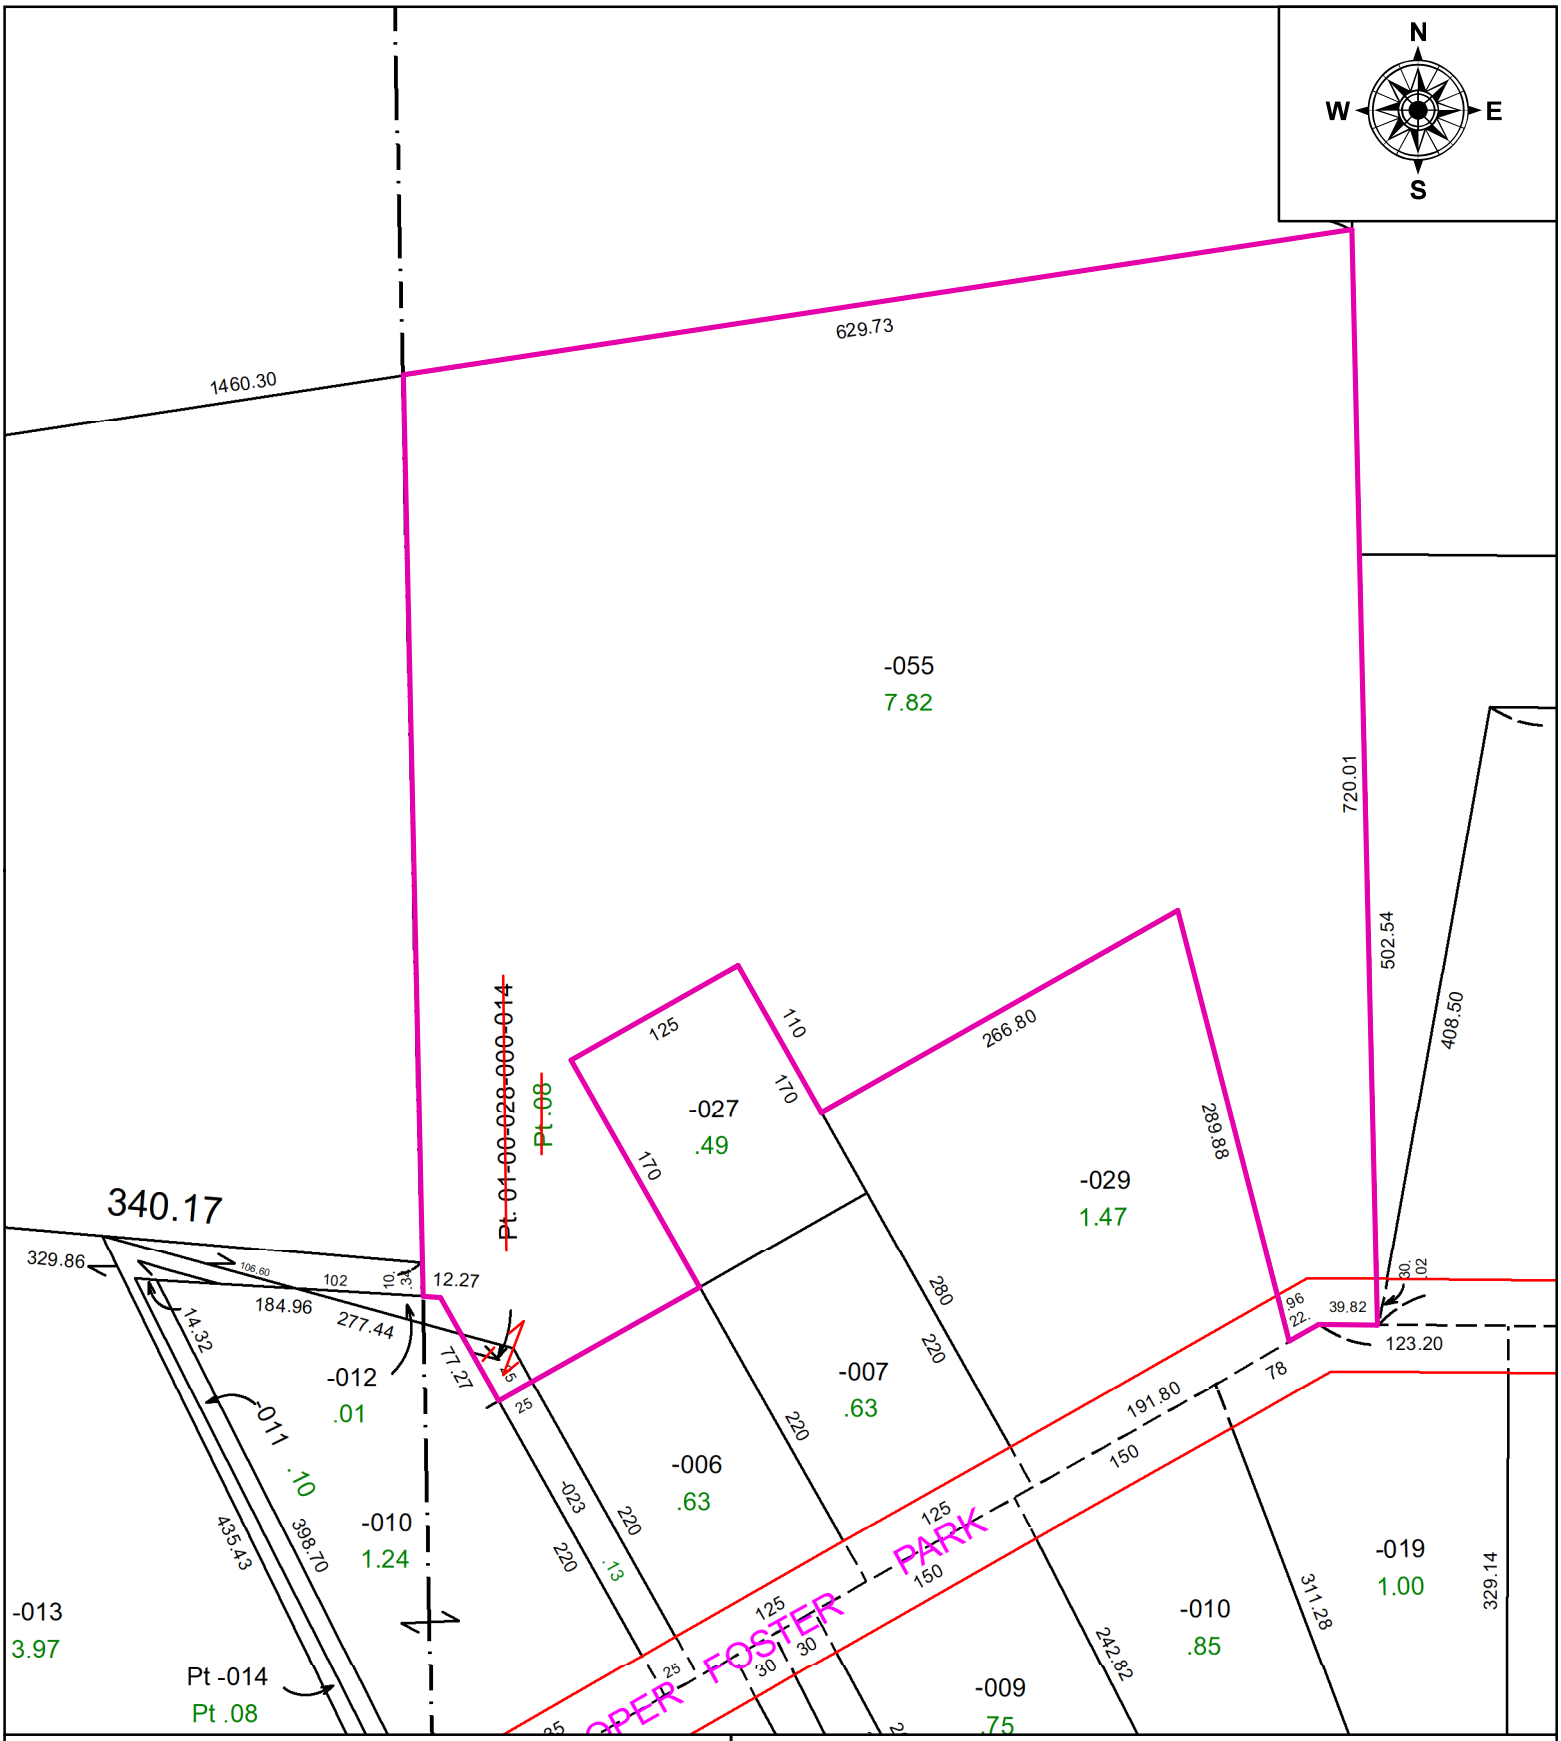

SPLITS/DEEDS PROCESSED

LORAIN COUNTY TAX MAP DEPARTMENT
226 MIDDLE AVE. ELYRIA, OH

SURVEYED BY: GEORGE HOFFMAN
CLOSURE: 1: INF
MAP PAGE(S): 1-00-027
APPOVED BY: TJS **DATE:** 7/17/2022
SCALE: 1" = 125' **PRIOR INSTRUMENT:** 2024-0008025