PARENT PARCEL: 01-00-059-000-031 & 01-00-070-000-017 UNCOMBINATION & AC CORR PER SURVEYOR THOMAS SIMON

CHILD PARCEL: 01-00-058-000-030, 01-00-059-000-032, 01-00-070-000-018, 01-00-071-000-036, 01-00-054-084(S.T.), 01-00-059-000-026(S.T.), -022(S.T.), & -023 (S.T.)

STARTING POINT: MONUMENT BOX @ INTERSECTION OF C/LS OF BAUMHART RD & MIDDLE RIDGE RD

24-05288-C
24-05289-C

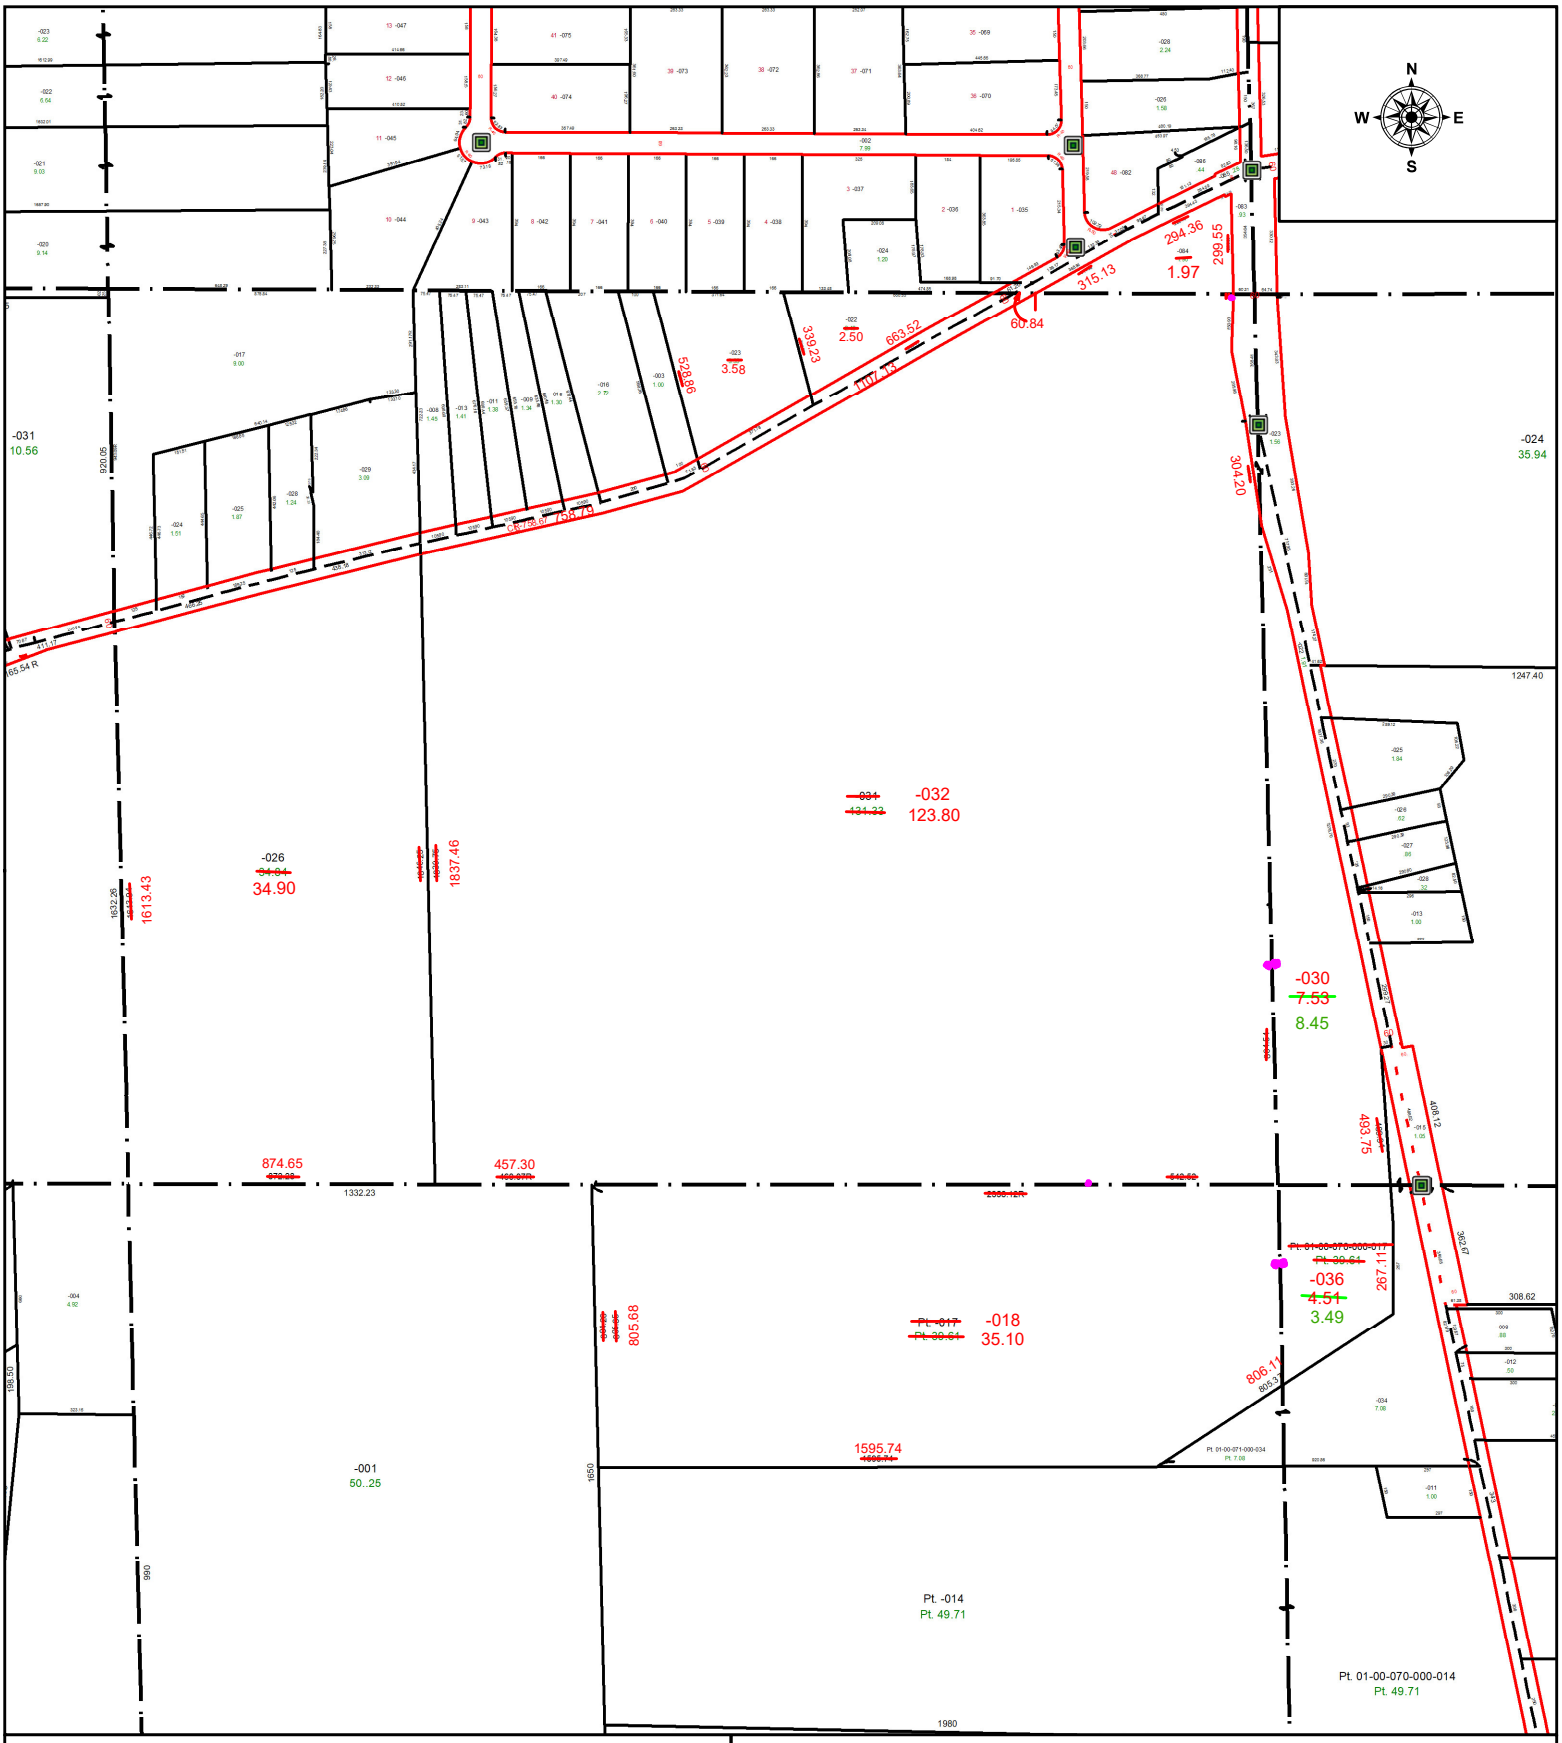

SPLITS/DEEDS PROCESSED

LORAIN COUNTY TAX MAP DEPARTMENT
226 MIDDLE AVE. ELYRIA, OH

SURVEYED BY: THOMAS SIMON SURVEY # 51176 / 51177
CLOSURE: 1: 946637
MAP PAGE(S): 01-00-054, 01-00-058, 01-00-059, 01-00-070, & 01-00-071
APPOVED BY: WRZ **DATE:** 5/8/2024
SCALE: 1" = 550 **PRIOR INSTRUMENT:** #2020-0770752