**PARENT PARCEL:** 01-00-059-000-031, 01-00-070-000-017, & 01-00-054-000-084 (S.T.)

**CHILD PARCEL:** 01-00-058-000-030, 01-00-059-000-032, 01-00-070-000-018, 01-00-071-000-036, & 01-00-054-000-084 (S.T.)

**STARTING POINT:** UNCOMBINATION & AC CORR PER SURVEYOR THOMAS SIMON
MONUMENT BOX @ INTERSECTION OF C/LS OF BAUMHART RD & MIDDLE RIDGE RD

# 24-05289-C

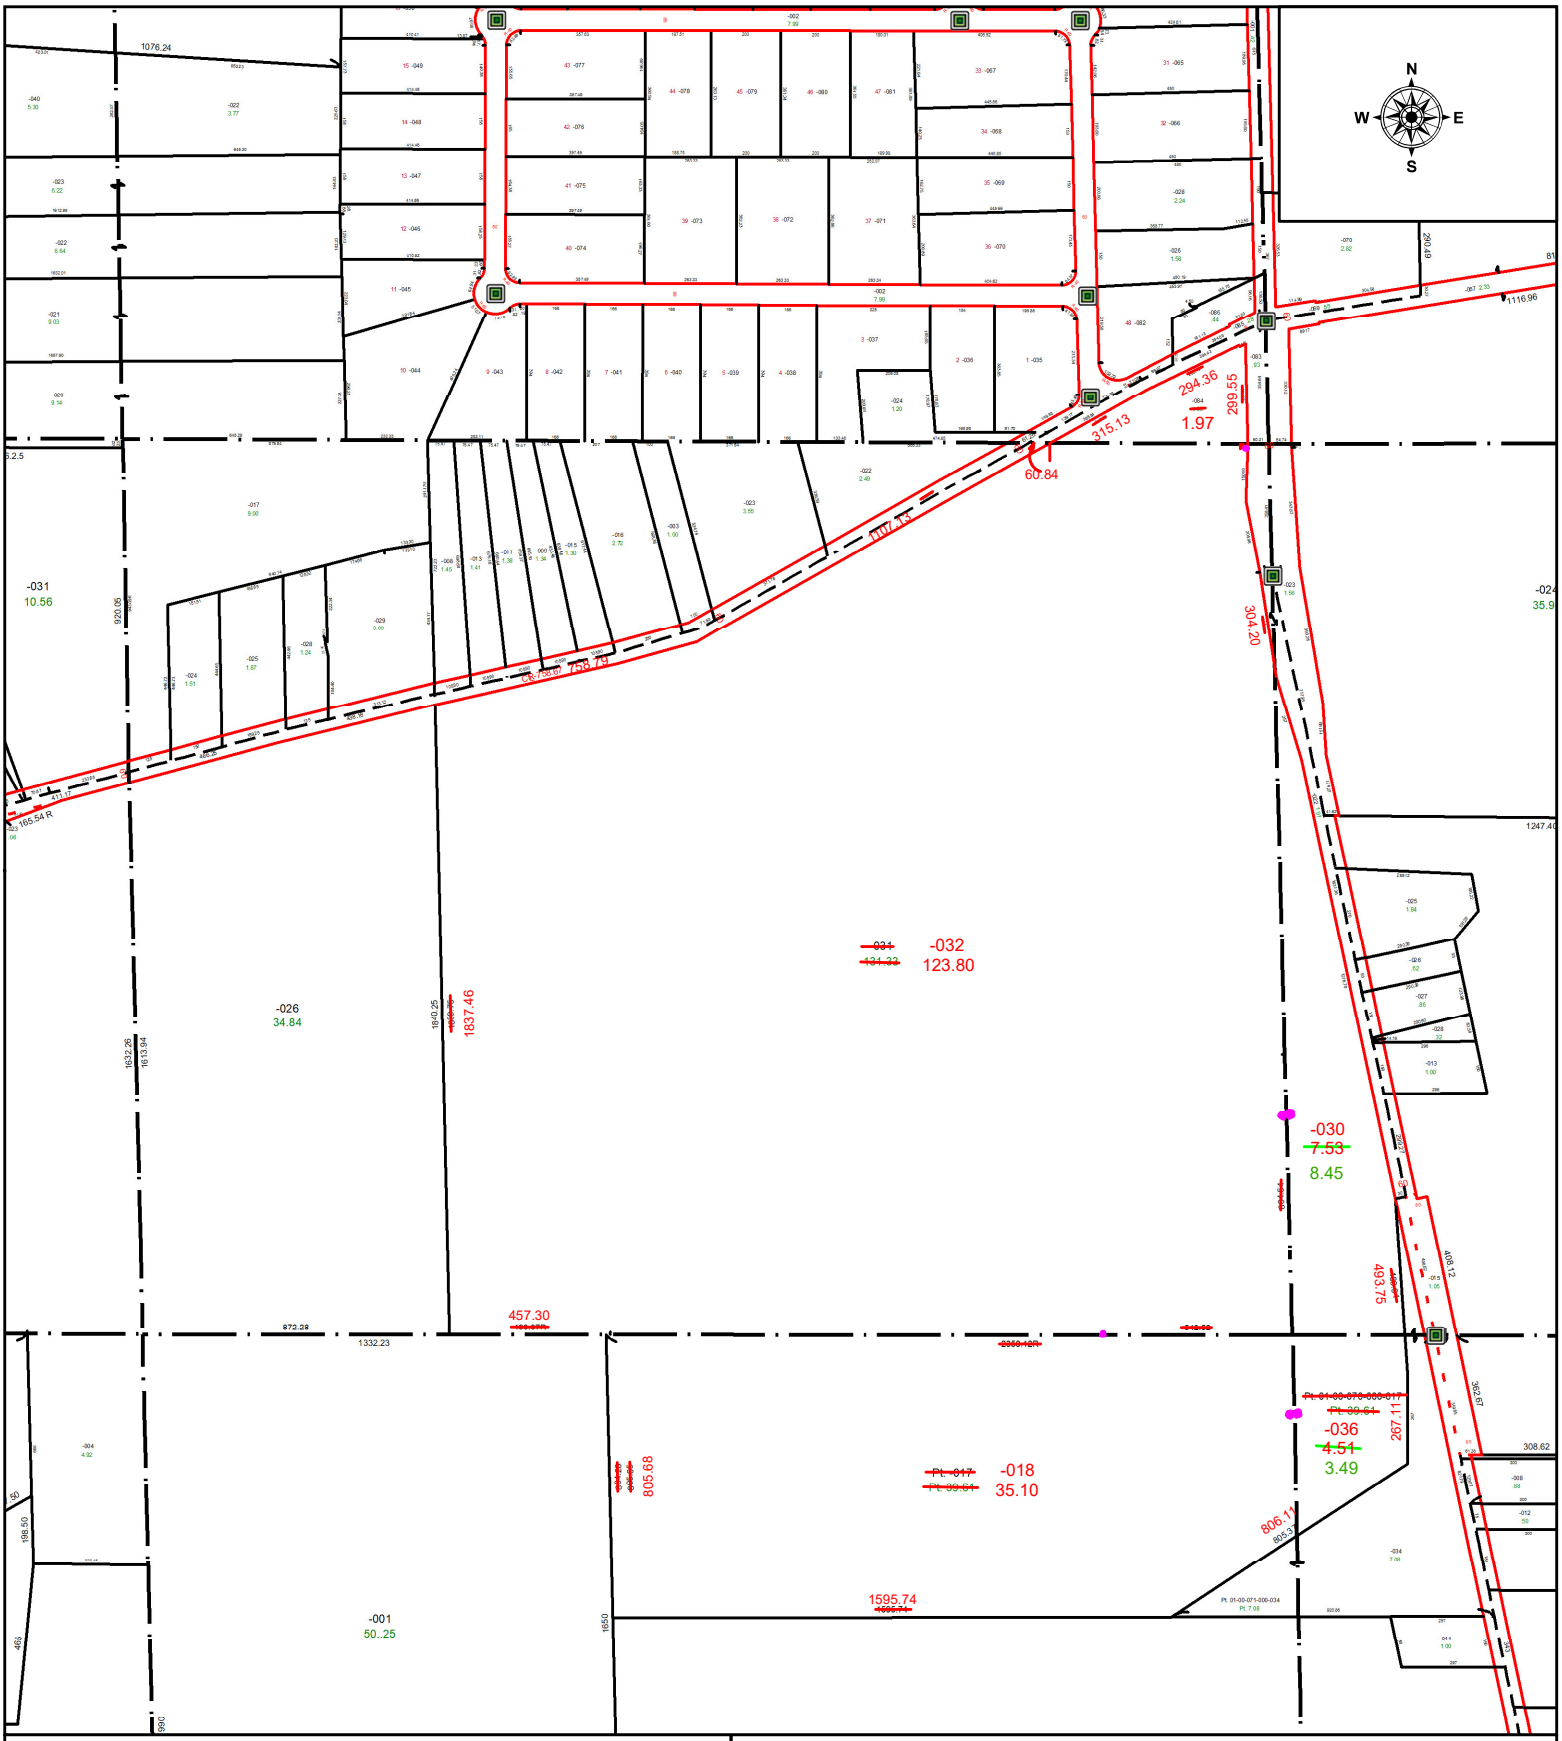


**SPLITS/DEEDS PROCESSED**

LORAIN COUNTY TAX MAP DEPARTMENT
226 MIDDLE AVE. ELYRIA, OH

**SURVEYED BY:** THOMAS SIMON SURVEY # 51176
**CLOSURE:** 1: 946637
**MAP PAGE(S):** 01-00-054, 01-00-058, 01-00-059, 01-00-070, & 01-00-071
**APPOVED BY:** WRZ **DATE:** 5/8/2024
**SCALE:** 1" = 550 **PRIOR INSTRUMENT:** #2020-0770752