PARENT PARCEL: 04-00-010-113-051

CHILD PARCEL: AC. CORR PER SURVEY ROBERT RUFFIING

STARTING POINT: C/L OF DETROIT RD. & FRENCH CREEK RD.

24-05295-A

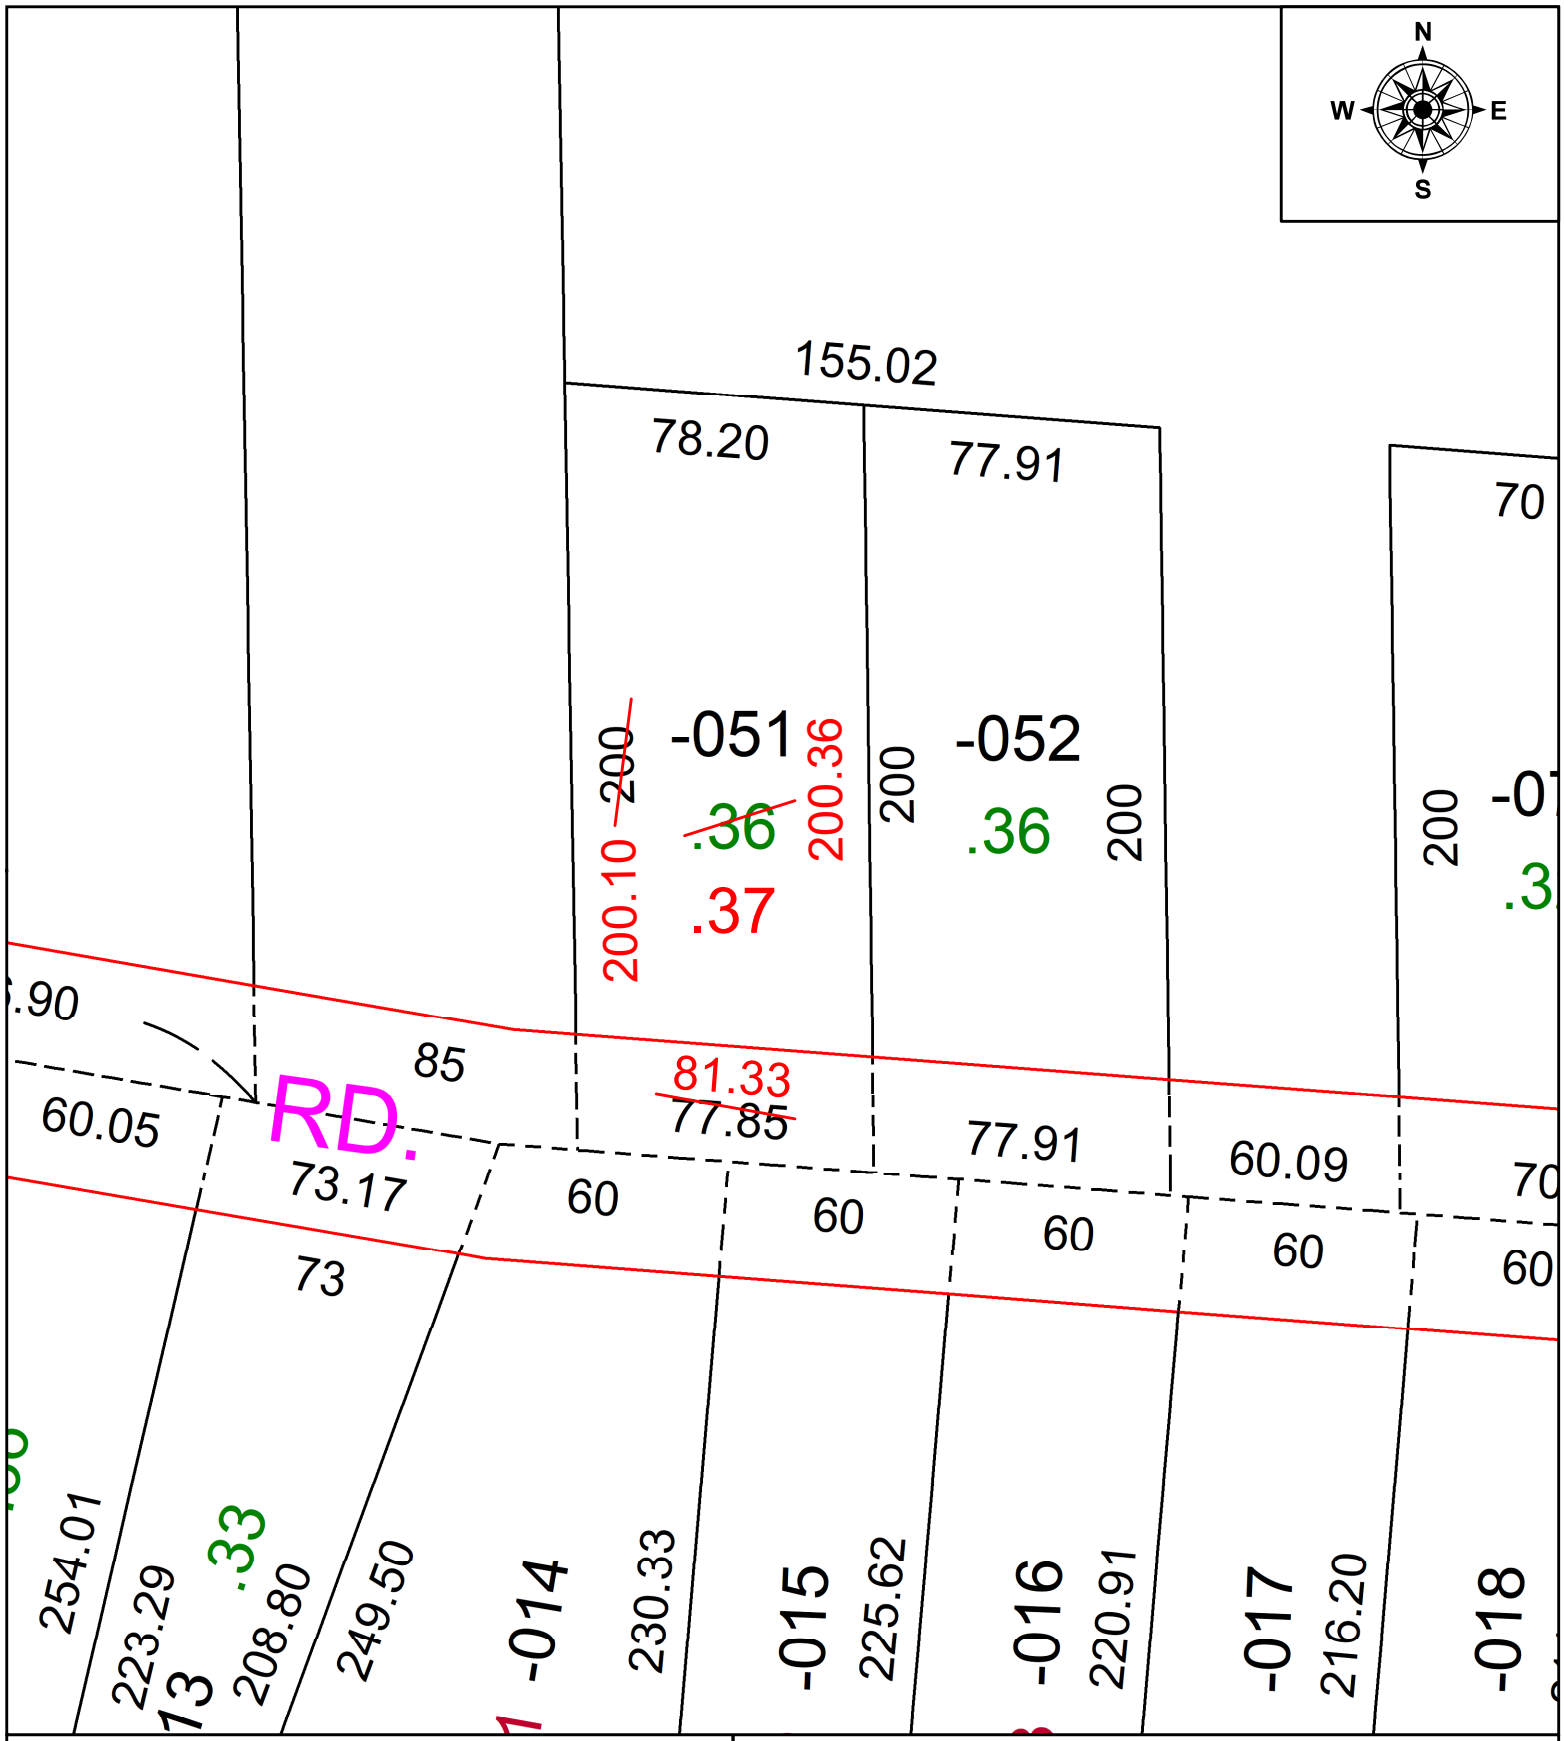

SPLITS/DEEDS PROCESSED

LORAIN COUNTY TAX MAP DEPARTMENT
226 MIDDLE AVE. ELYRIA, OH

SURVEYED BY: ROBERT RUFFING **SURVEY #:** 51184
CLOSURE: 1:145206
MAP PAGE(S): 04-00-010
APPOVED BY: DMA **DATE:** 5/13/2024
SCALE: 1" = 50' **PRIOR INSTRUMENT:** 2017-0644526