PARENT PARCEL: 09-00-087-101-023 & -026
CHILD PARCEL: 09-00-087-101-051
STARTING POINT: COMBINATION PER PRIOR #2023-0911107

24-05299-C

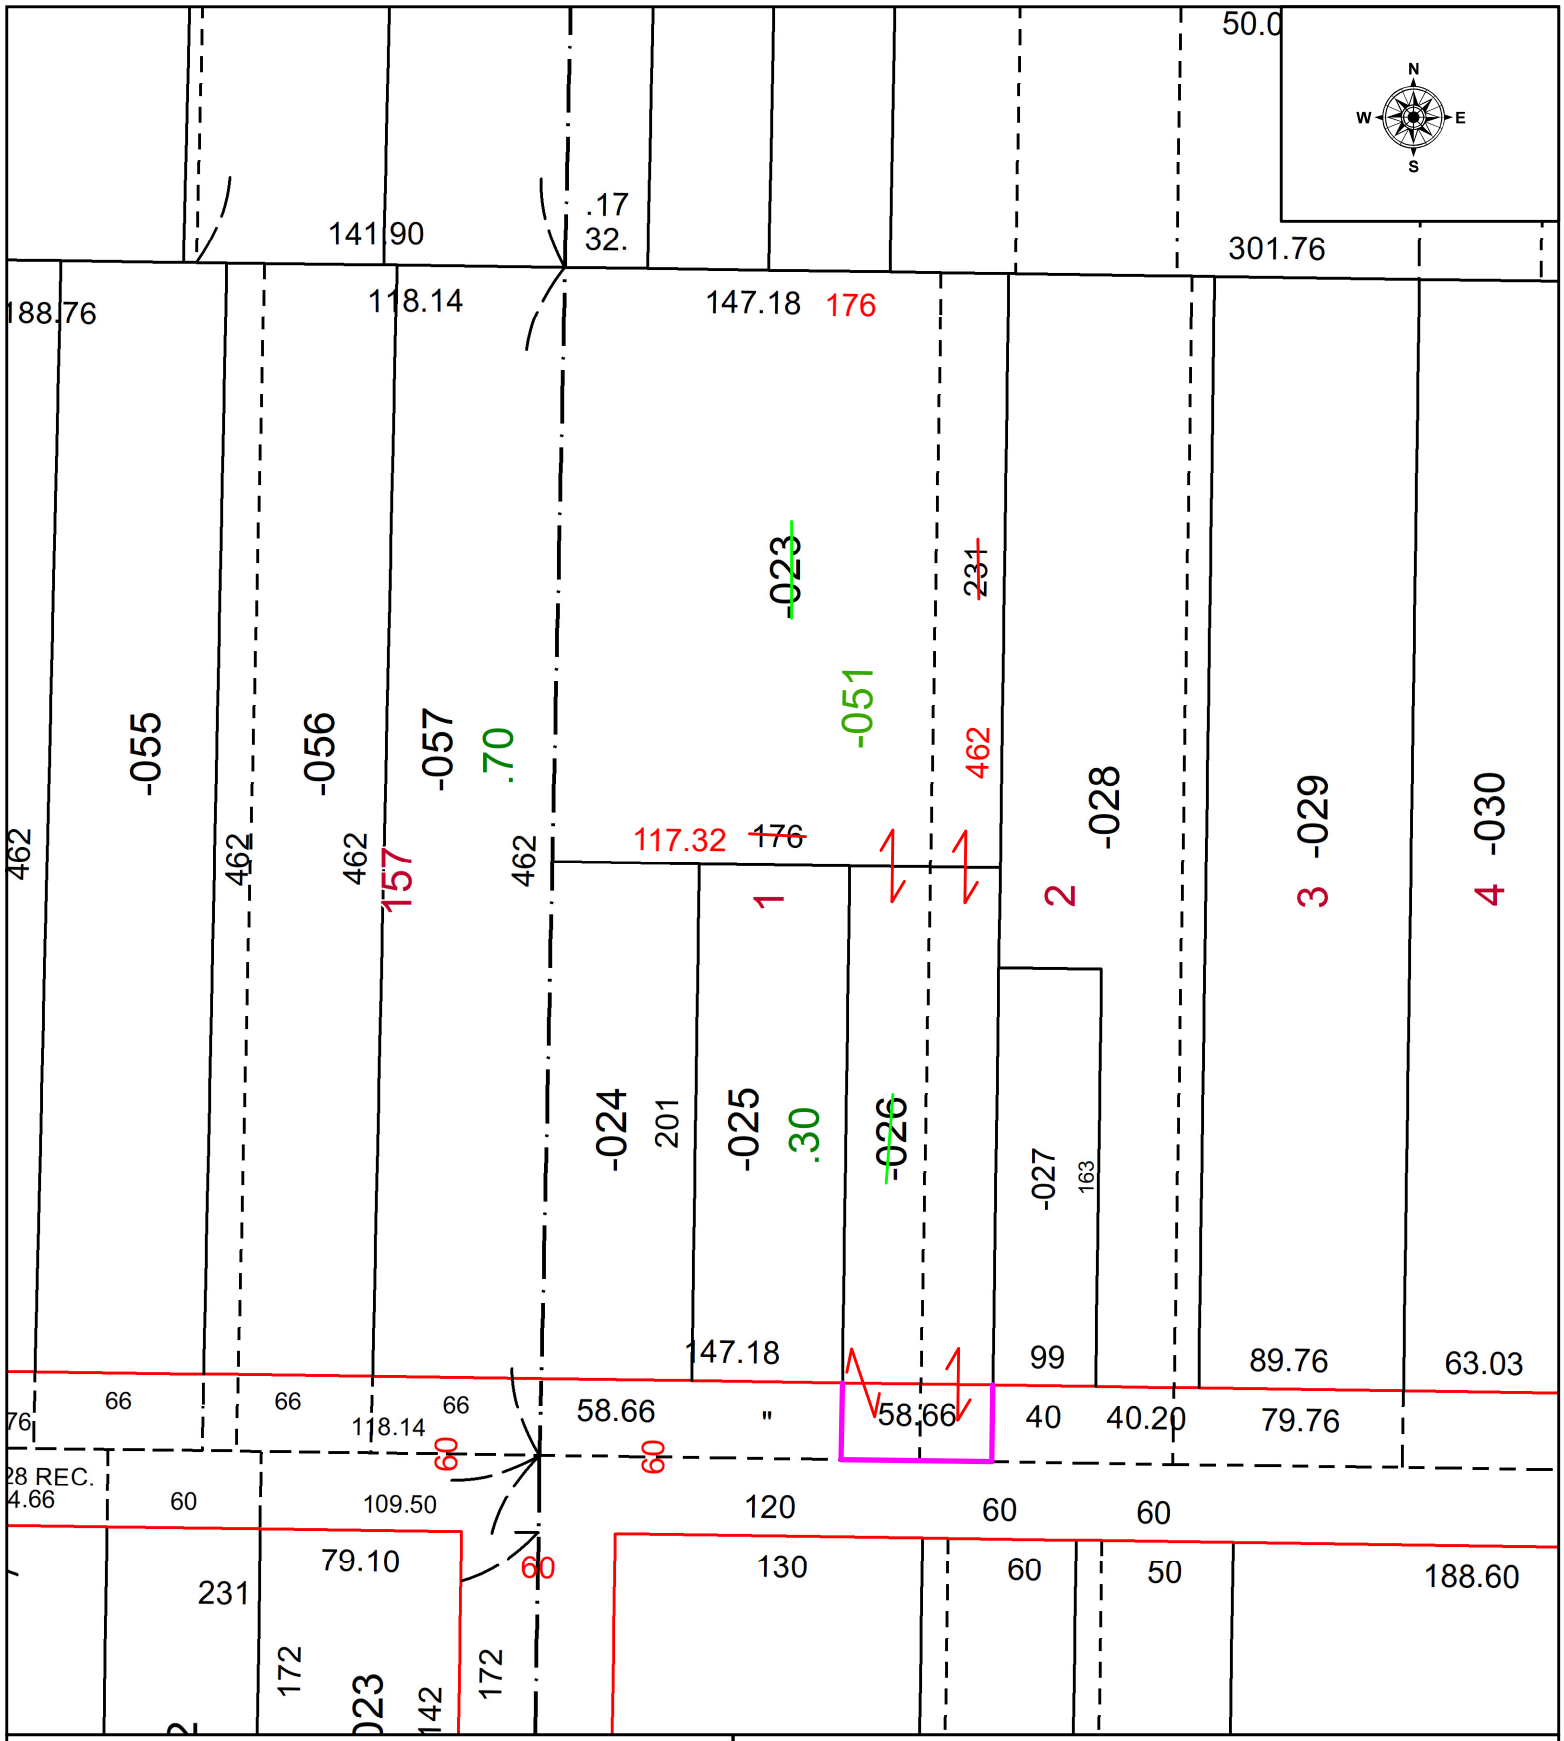

SPLITS/DEEDS PROCESSED
LORAIN COUNTY TAX MAP DEPARTMENT
226 MIDDLE AVE. ELYRIA, OH

SURVEYED BY: N/A SURVEY #
CLOSURE: 1:
MAP PAGE(S): 09-00-087
APPOVED BY: WRZ **DATE:** 5/16/2024
SCALE: 1" = 75 **PRIOR INSTRUMENT:** #2023-0911107