PARENT PARCEL: 07-00-004-109-016

CHILD PARCEL: AC CORR PER SURV BY WILFREDO BARBOSA

STARTING POINT: C/L OF CHESTNUT RIDGE AND LEAR NAGLE RD

24-05309-C

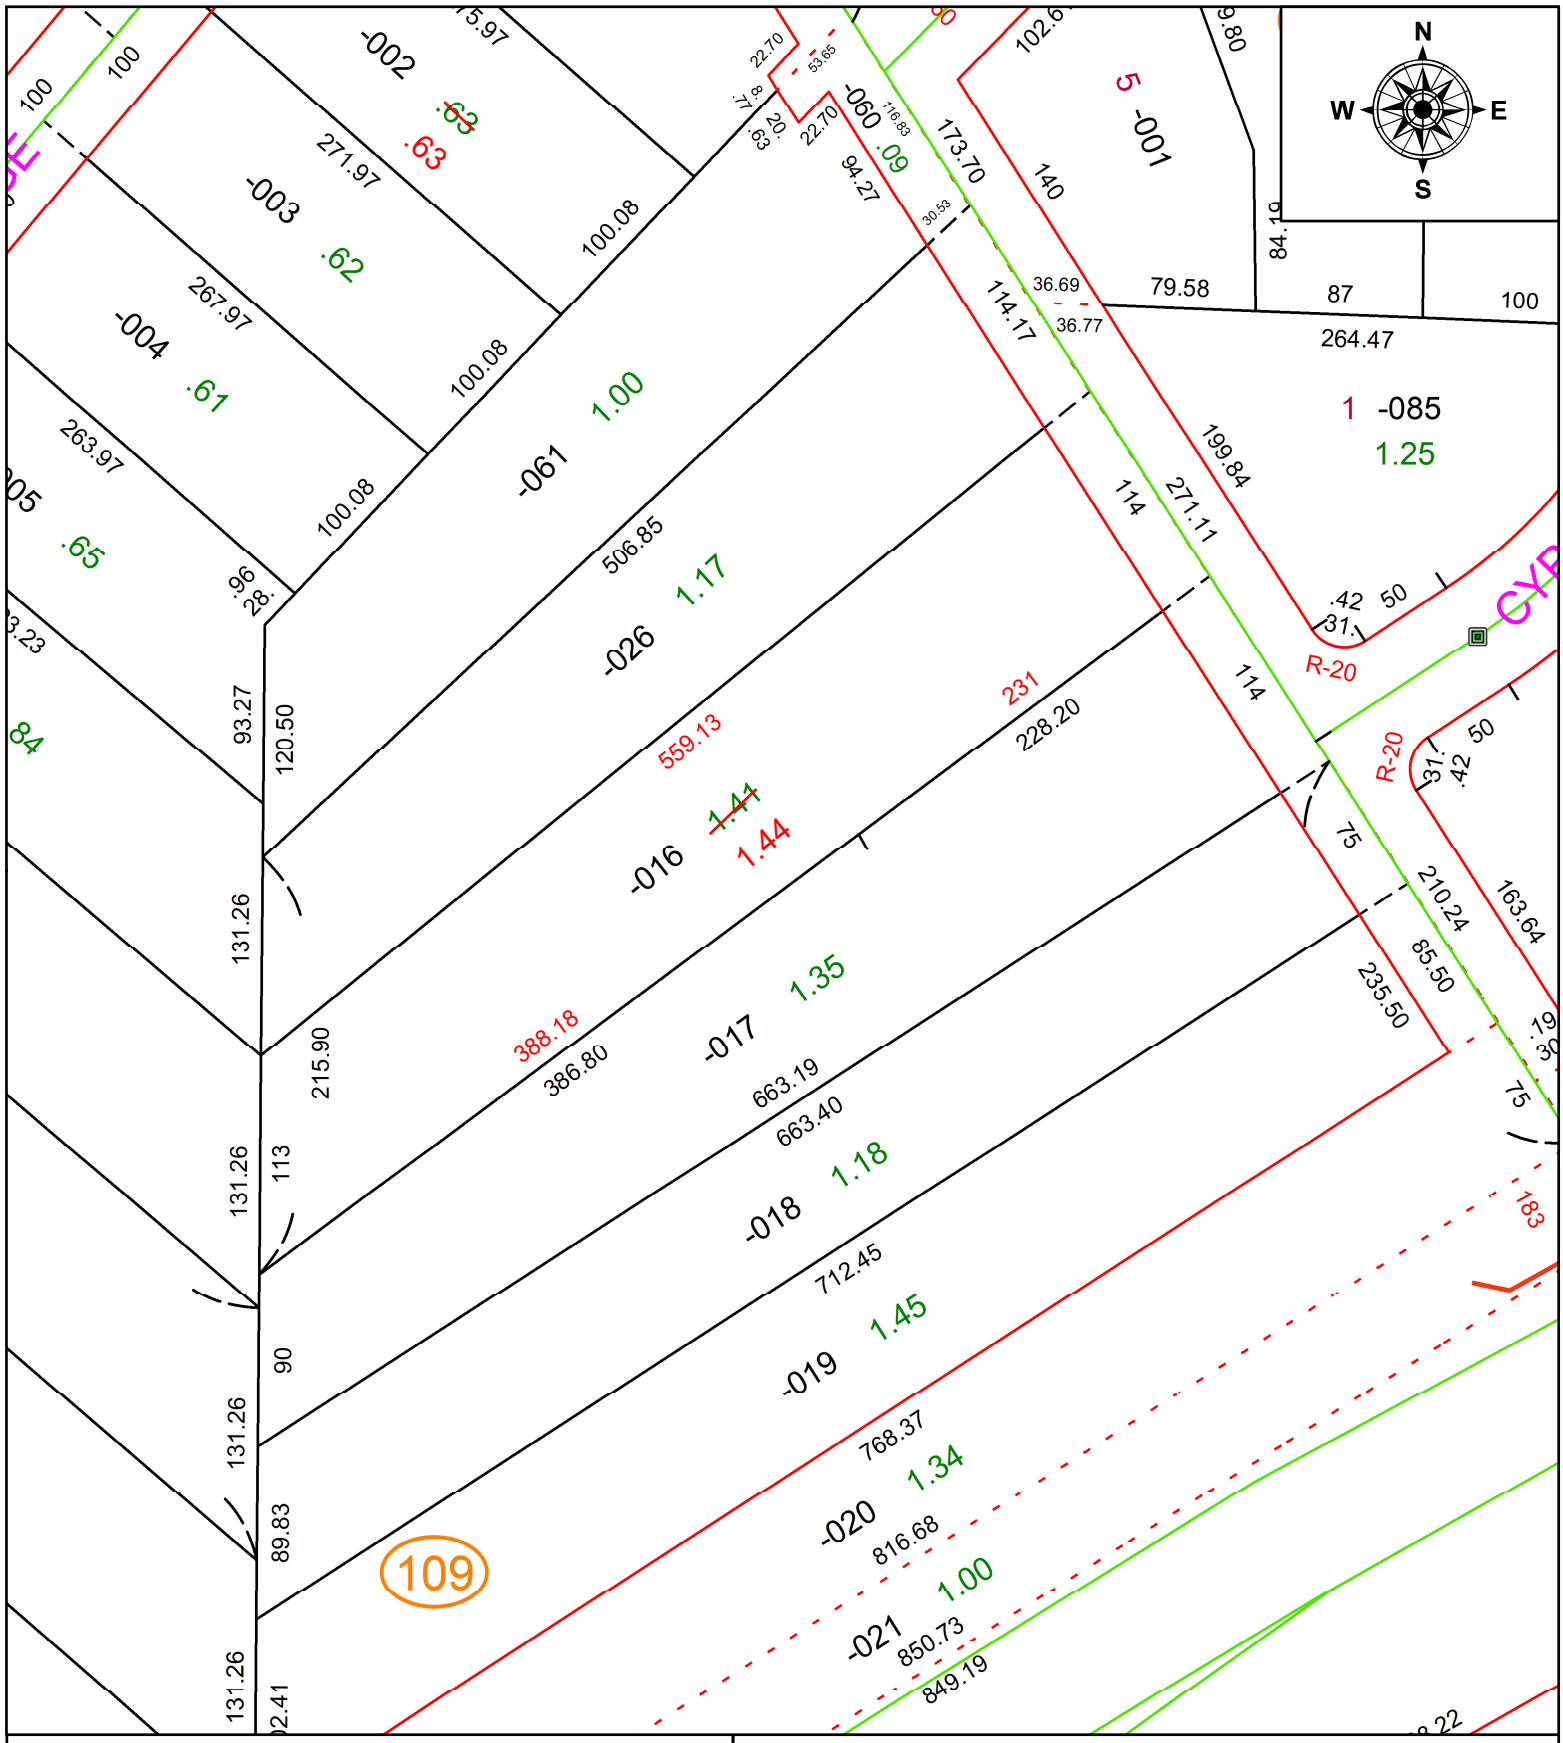

SPLITS/DEEDS PROCESSED

LORAIN COUNTY TAX MAP DEPARTMENT
226 MIDDLE AVE. ELYRIA, OH

SURVEYED BY: WILFREDO BARBOSA **SURV # 51201**

CLOSURE: 1: 1329517

MAP PAGE(S): 07-00-004

APPOVED BY: AC **DATE:** June 07, 2024

SCALE: 1 in = 100 ft **PRIOR INSTRUMENT:** 2023- 0922996