PARENT PARCEL: 03-00-037-103-010

CHILD PARCEL: AC CORR PER SURV BY WILFREDO BARBOSA

STARTING POINT: NE CORNER OF S/L 15

24-05310-C

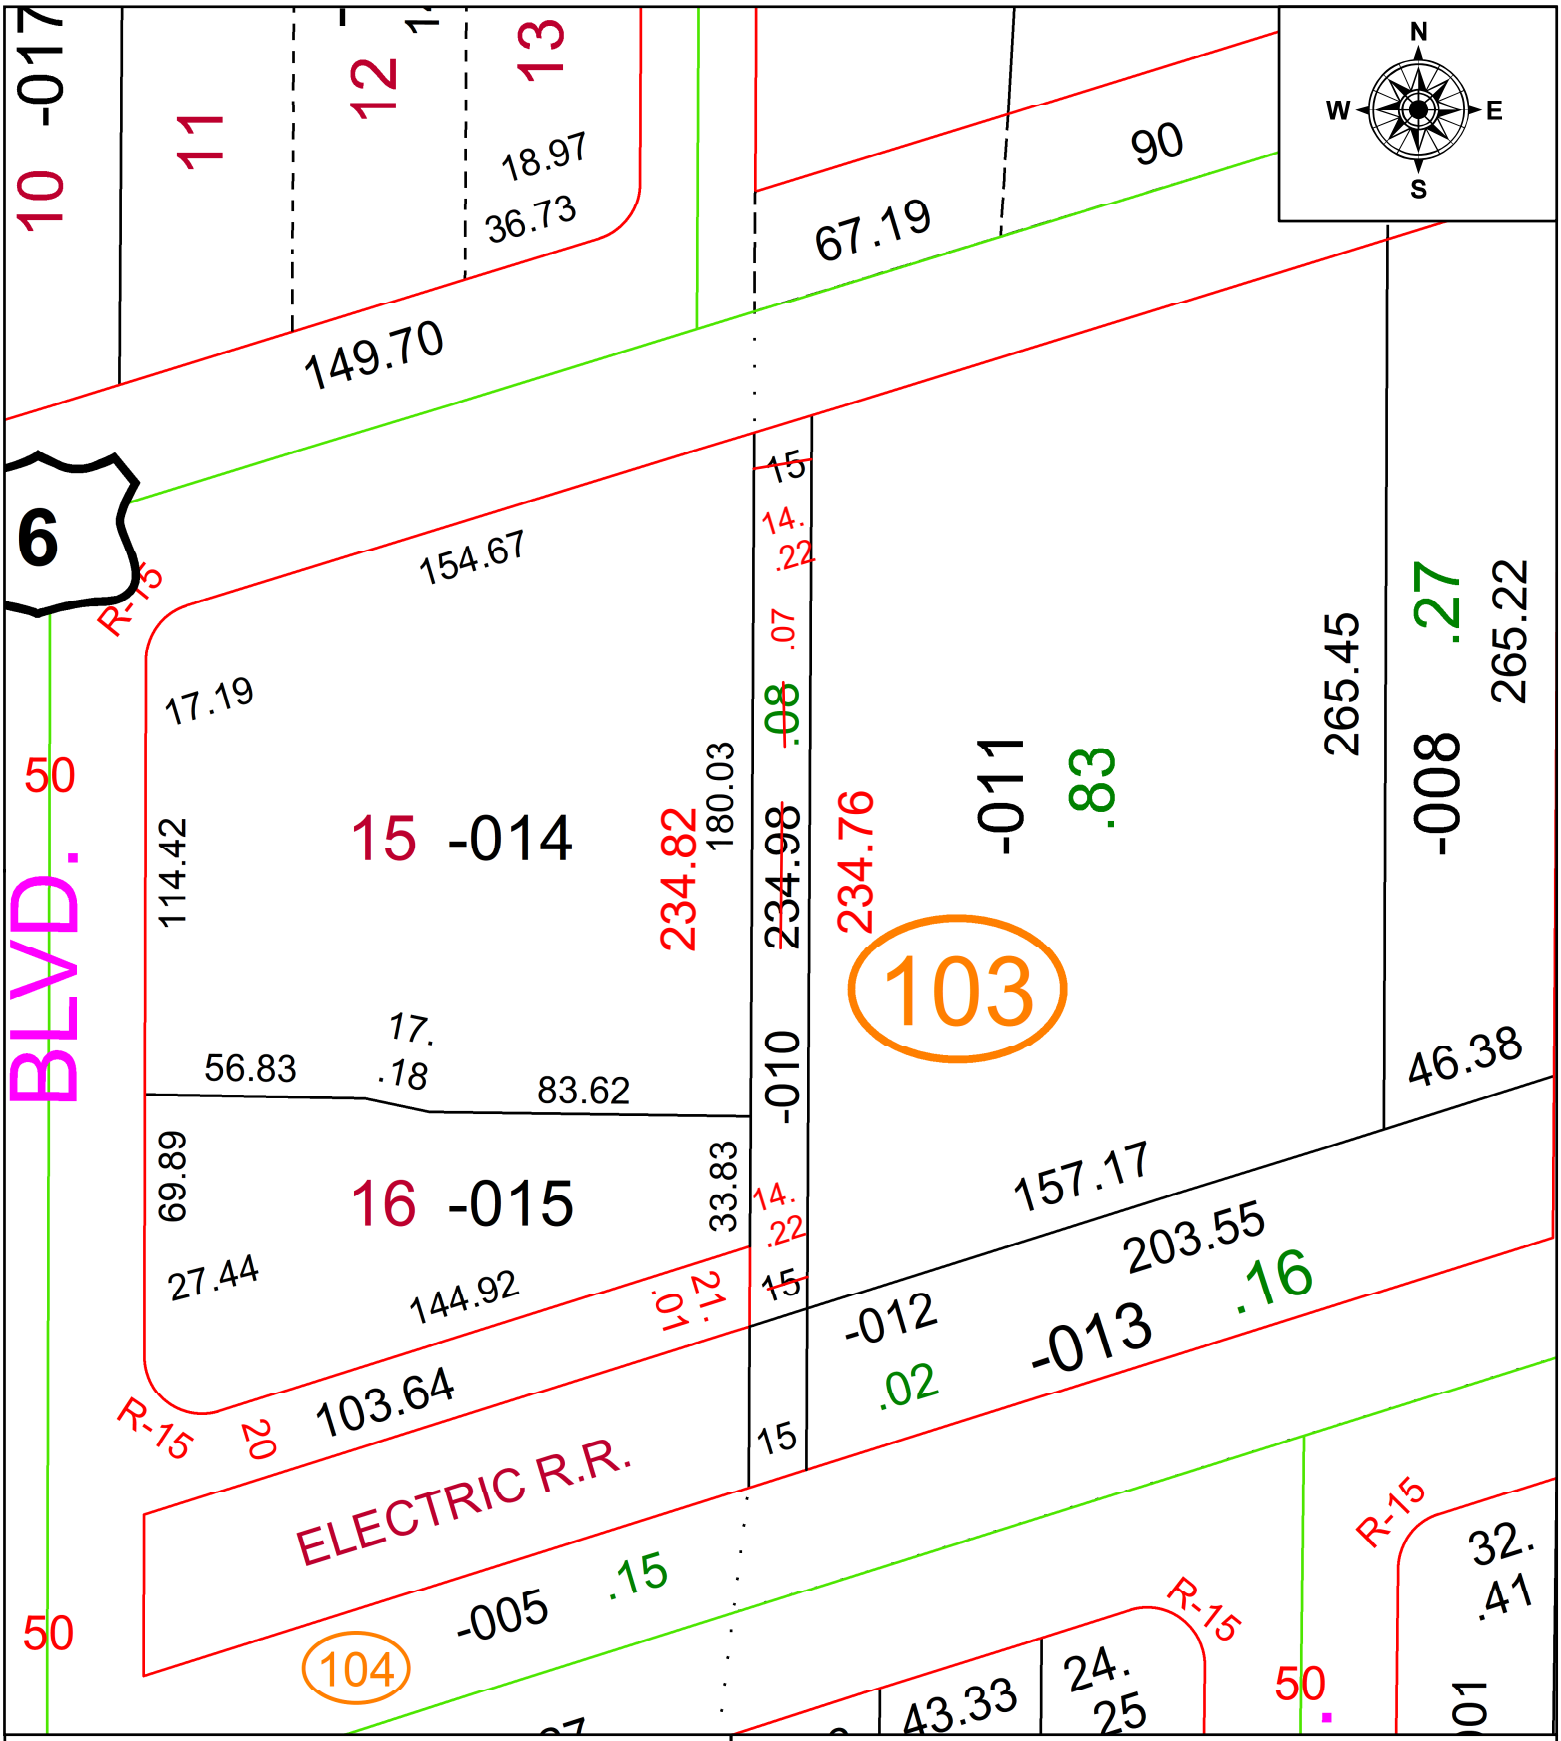

SPLITS/DEEDS PROCESSED

LORAIN COUNTY TAX MAP DEPARTMENT
226 MIDDLE AVE. ELYRIA, OH

SURVEYED BY: WILFREDO BARBOSA **SURV # 51206**

CLOSURE: 1: 100789

MAP PAGE(S): 03-00-037

APPOVED BY: AC **DATE:** June 13, 2024

SCALE: 1 in = 50 ft **PRIOR INSTRUMENT:** 2022- 0894413