PARENT PARCEL: 05-00-041-108-004 & -006

CHILD PARCEL: FR & DPTH TO AC CORR PER SURVEYOR AMY KELLY

STARTING POINT: INTERSECTION OF C/LS SPRUCE TREE LN & ROCK CREEK RUN

24-05315-C

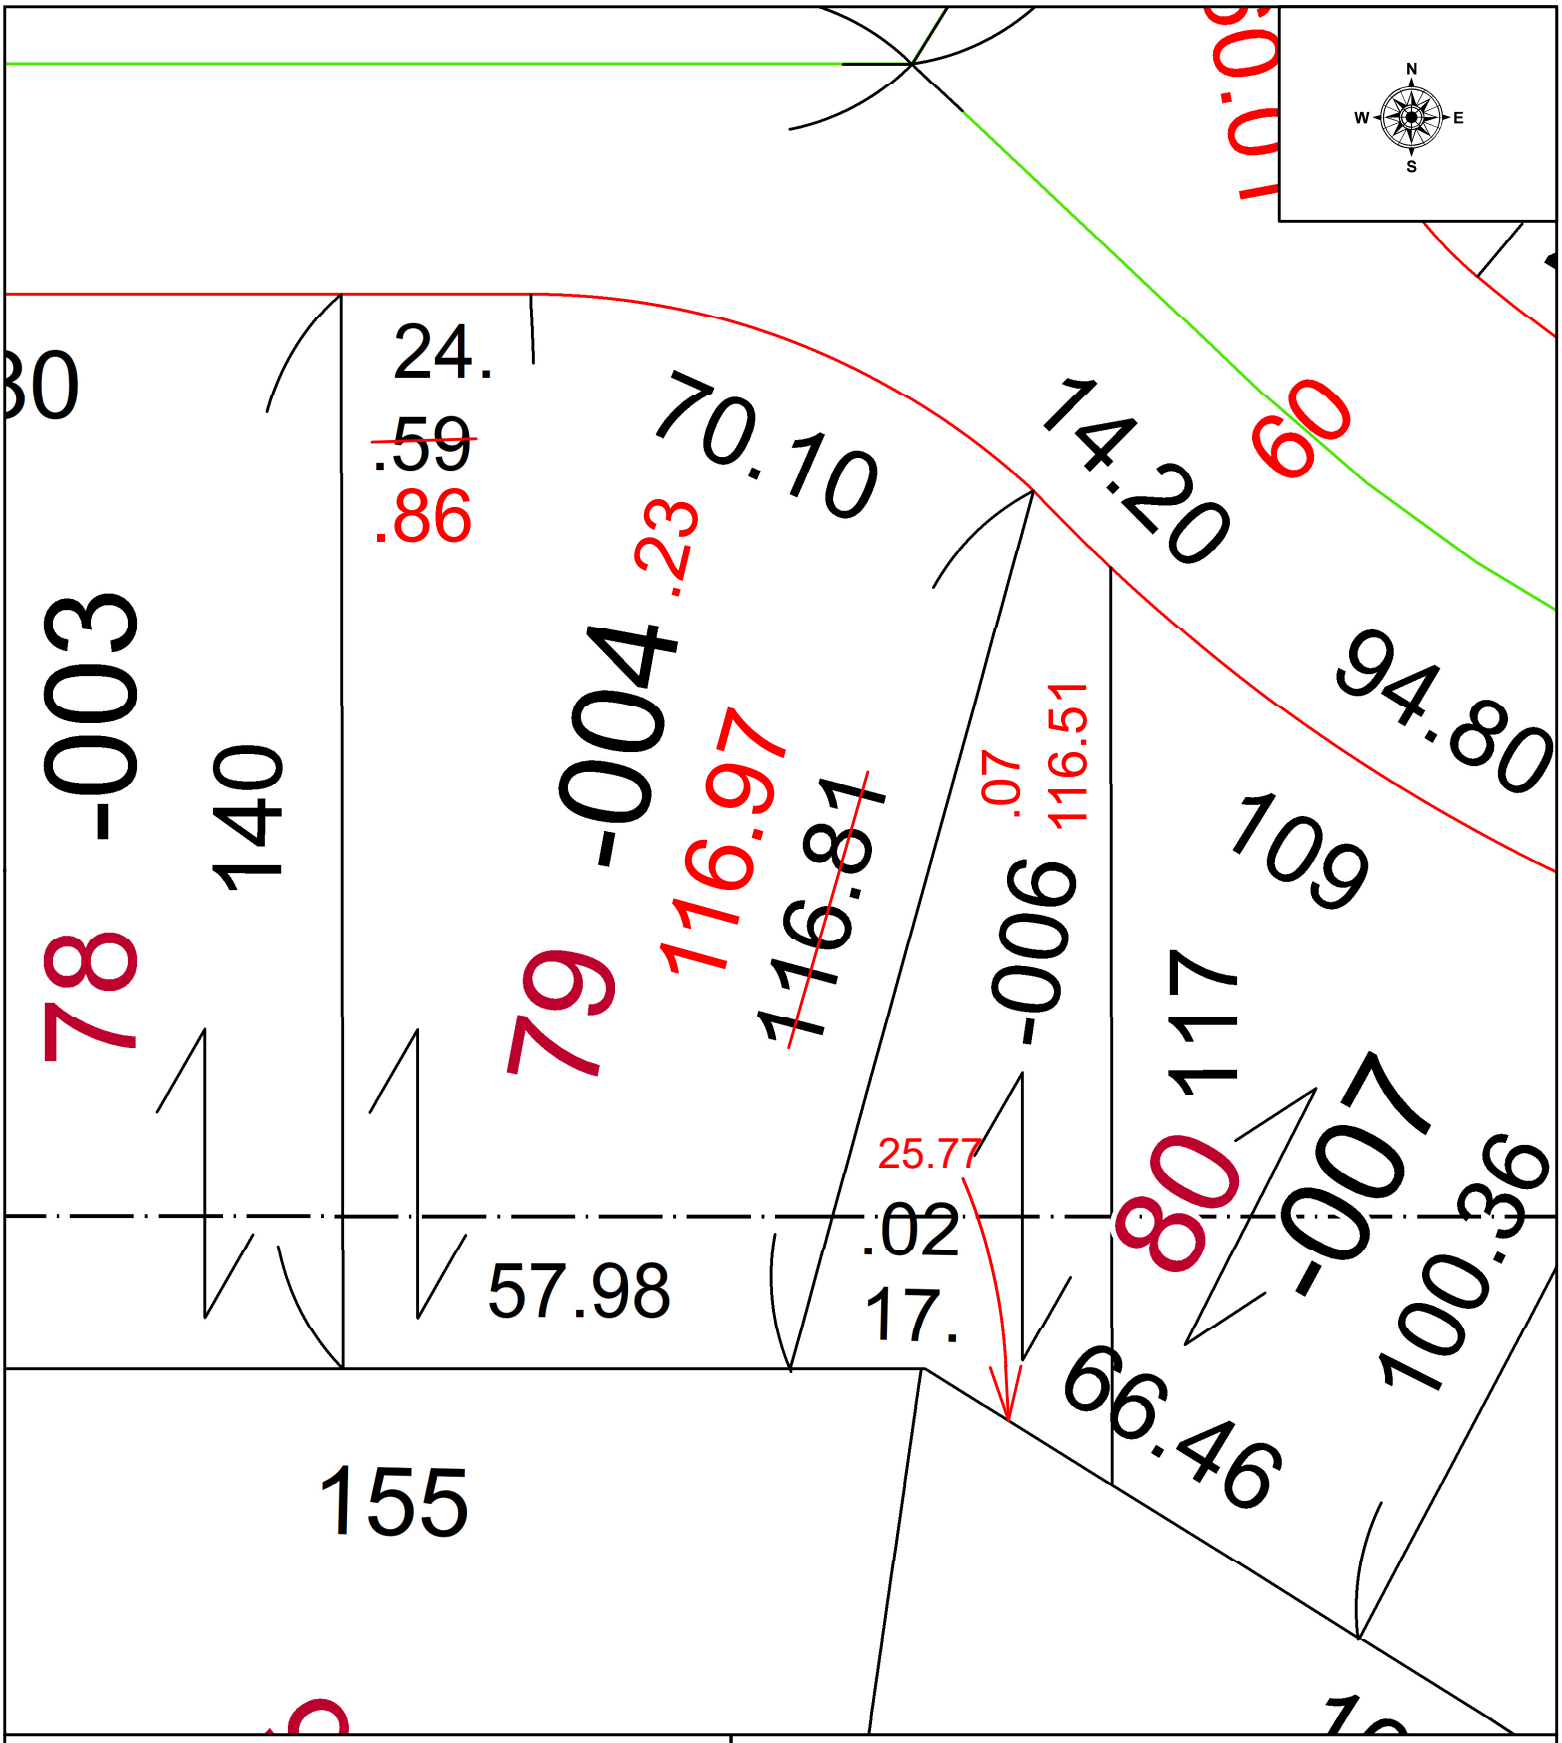

SPLITS/DEEDS PROCESSED

LORAIN COUNTY TAX MAP DEPARTMENT
226 MIDDLE AVE. ELYRIA, OH

SURVEYED BY: AMY KELLY SURVEY # 51212

CLOSURE: 1: 106773

MAP PAGE(S): 05-00-041

APPOVED BY: WRZ **DATE:** 6/20/2024

SCALE: 1" = 25 **PRIOR INSTRUMENT:** #2019-0713483