PARENT PARCEL: 17-06-007-000-010, 17-06-008-000-005, 17-06-009-000-008, 17-06-012-000-011

CHILD PARCEL:

STARTING POINT: C/L OF GORE ORPHANAGE RD AND SW CORNER OF O/L 8, TRACT 6

24-05317-C

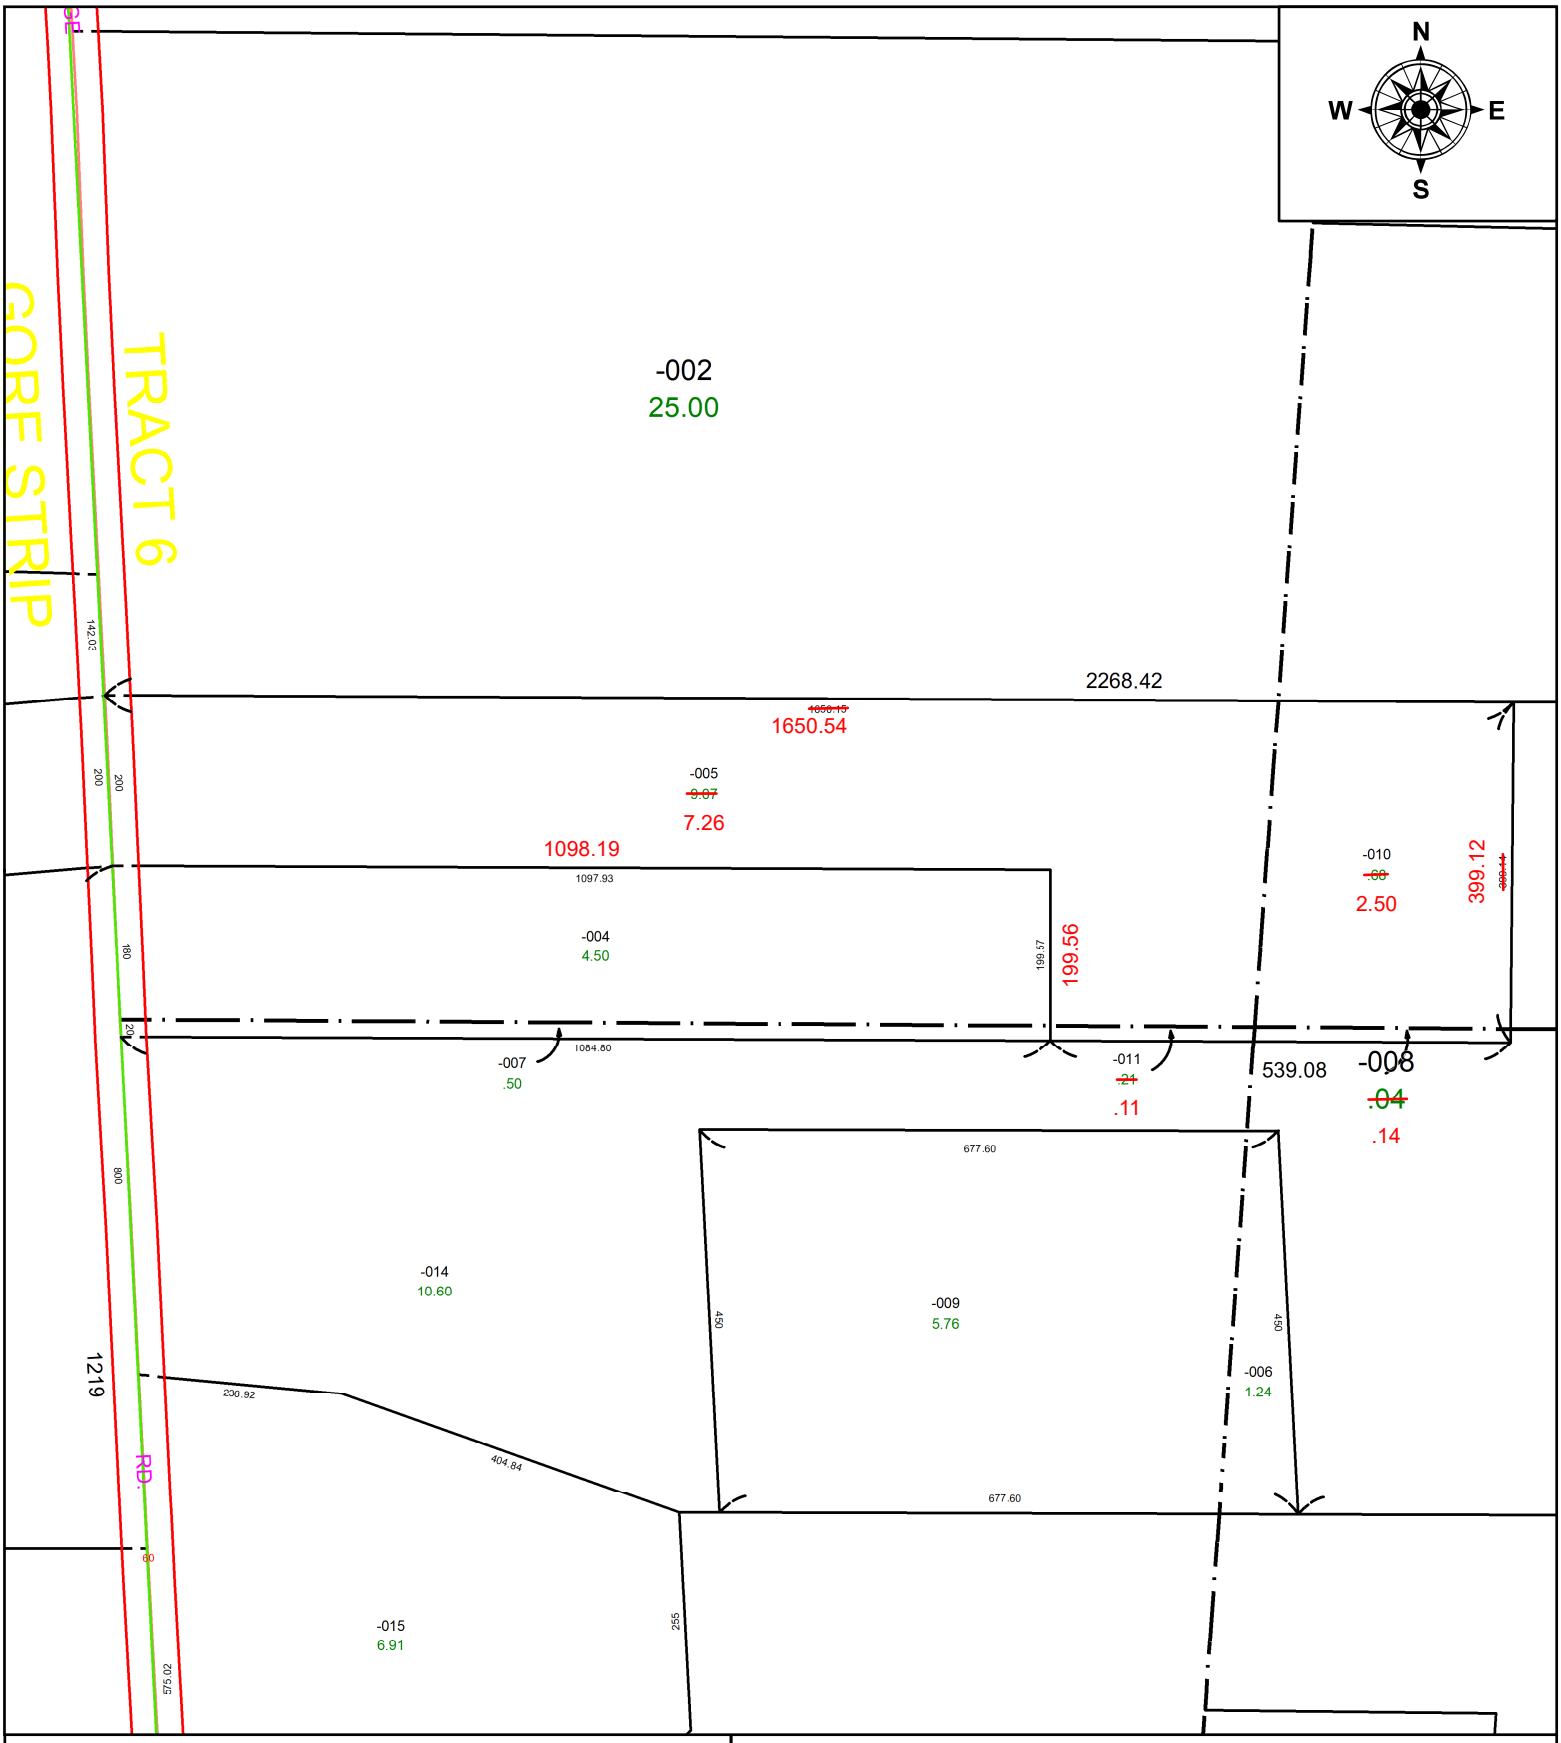

SPLITS/DEEDS PROCESSED

LORAIN COUNTY TAX MAP DEPARTMENT
226 MIDDLE AVE. ELYRIA, OH

SURVEYED BY: THOMAS A. SIMON **SURV # 51217**

CLOSURE: 1: 1514894

MAP PAGE(S): 17-06-007

APPOVED BY: AC **DATE:** June 28, 2024

SCALE: 1 in = 225 ft **PRIOR INSTRUMENT:** 2023- 0939330