PARENT PARCEL: 06-21-003-101-002 and -001

CHILD PARCEL: MAP CORRECTION

STARTING POINT: INTERSECTION OF C/LS OF LAKE AVE AND NORTH RIDGE RD

24-05320-C

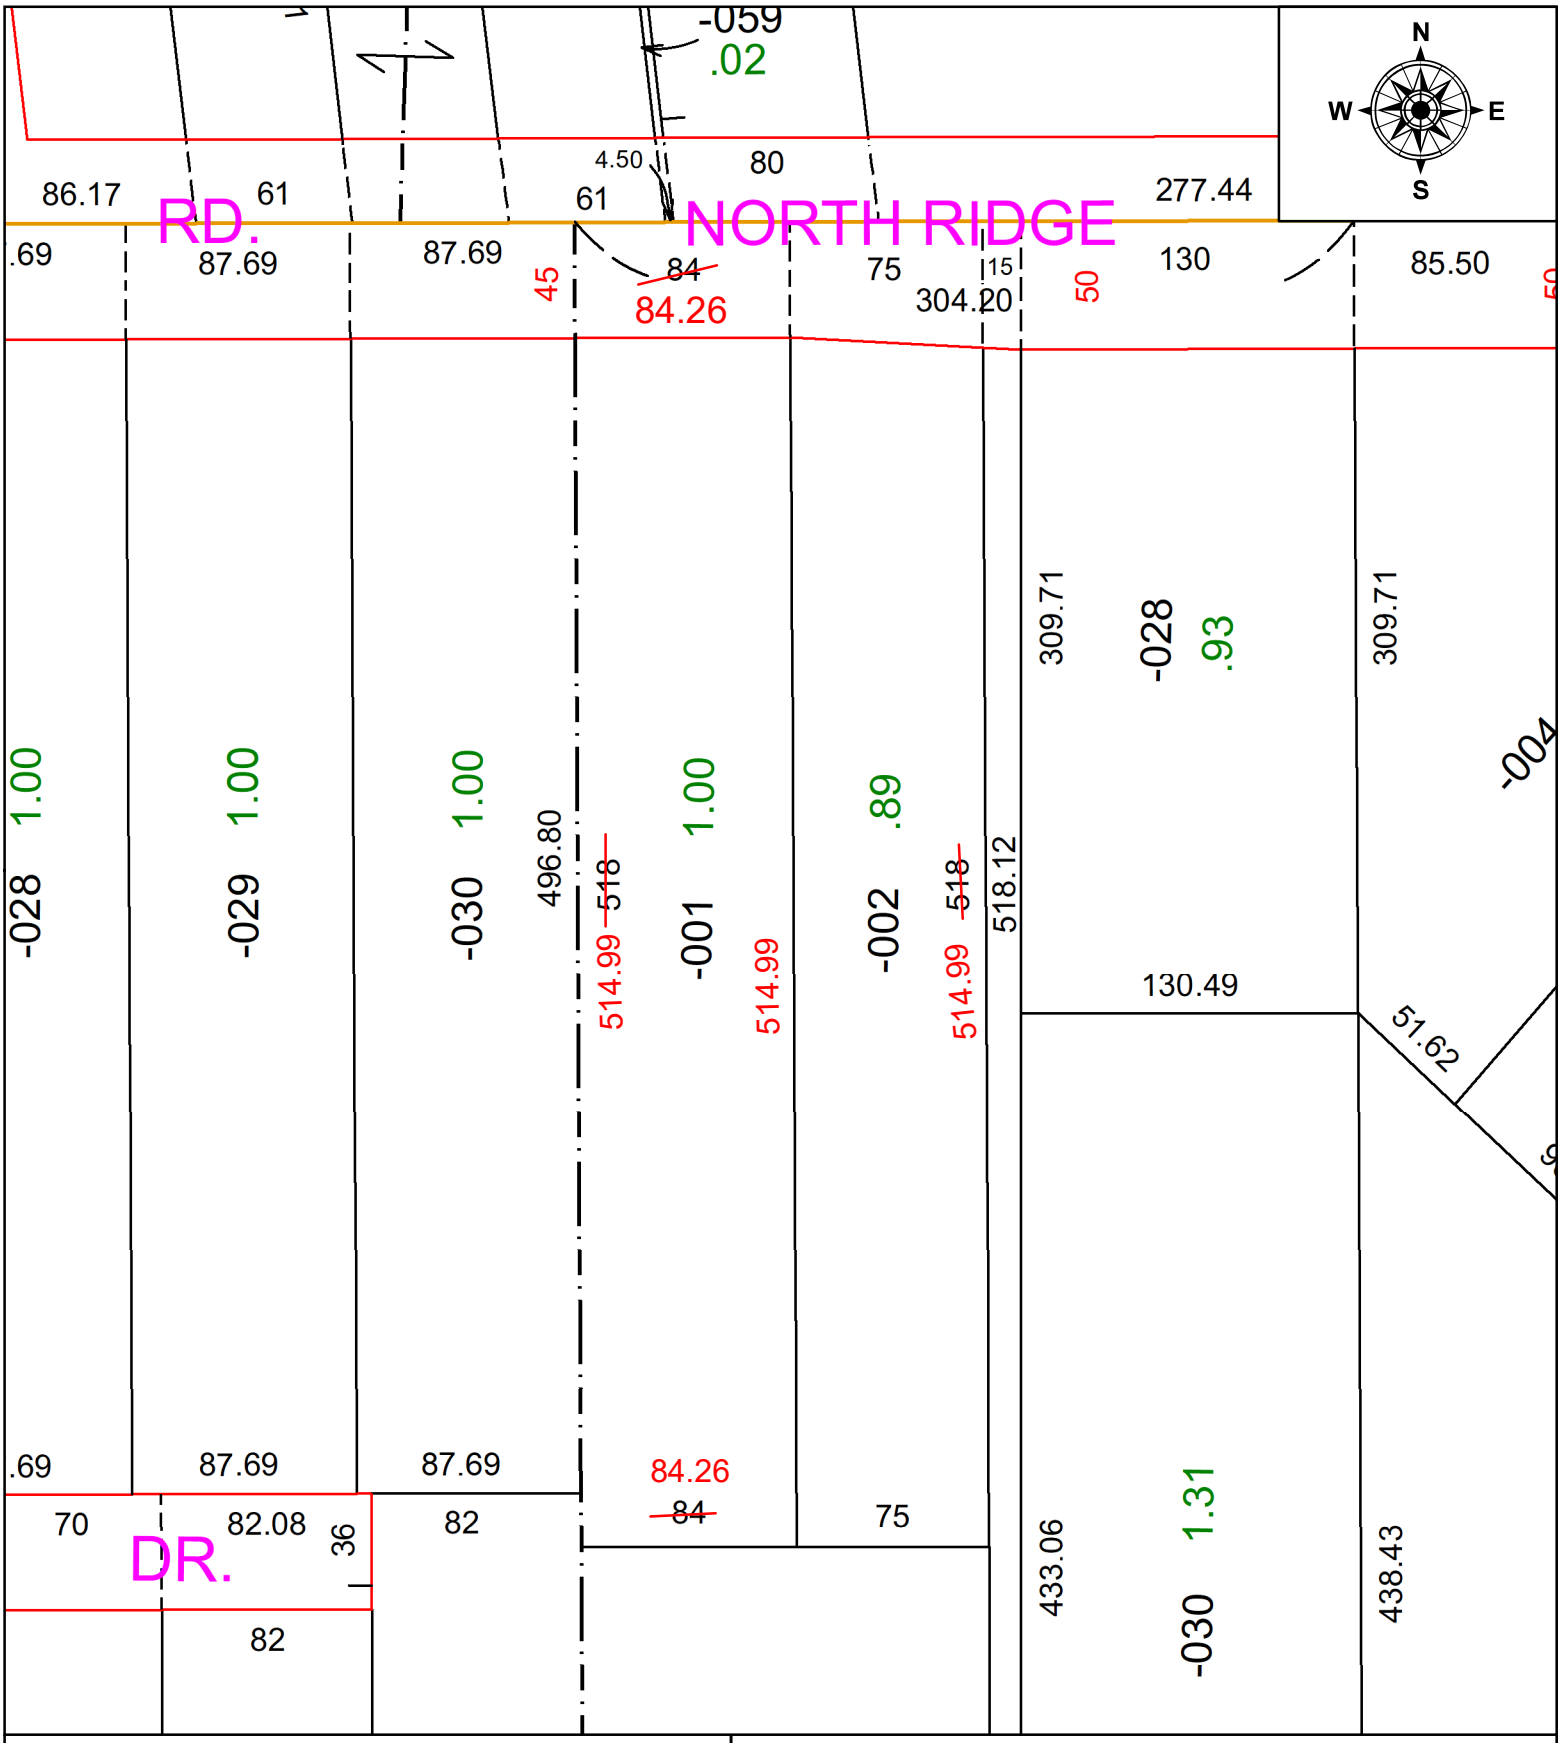

SPLITS/DEEDS PROCESSED

LORAIN COUNTY TAX MAP DEPARTMENT
226 MIDDLE AVE. ELYRIA, OH

SURVEYED BY: THOMAS SIMON **SURVEY #:** 51223
CLOSURE: 1: INF
MAP PAGE(S): 06-21-003
APPOVED BY: BB **DATE:** 7/8/2024
SCALE: 1" = 75' **PRIOR INSTRUMENT:** #2022-0874594