PARENT PARCEL: 05-00-041-110-003 & -009

CHILD PARCEL: AC CORR PER SURVEYOR MICHAEL SPELLACY

STARTING POINT: INTERSECTION OF C/L OF N. DEWEY RD & NORTH LINE OF O.L. 42

24-05325-C

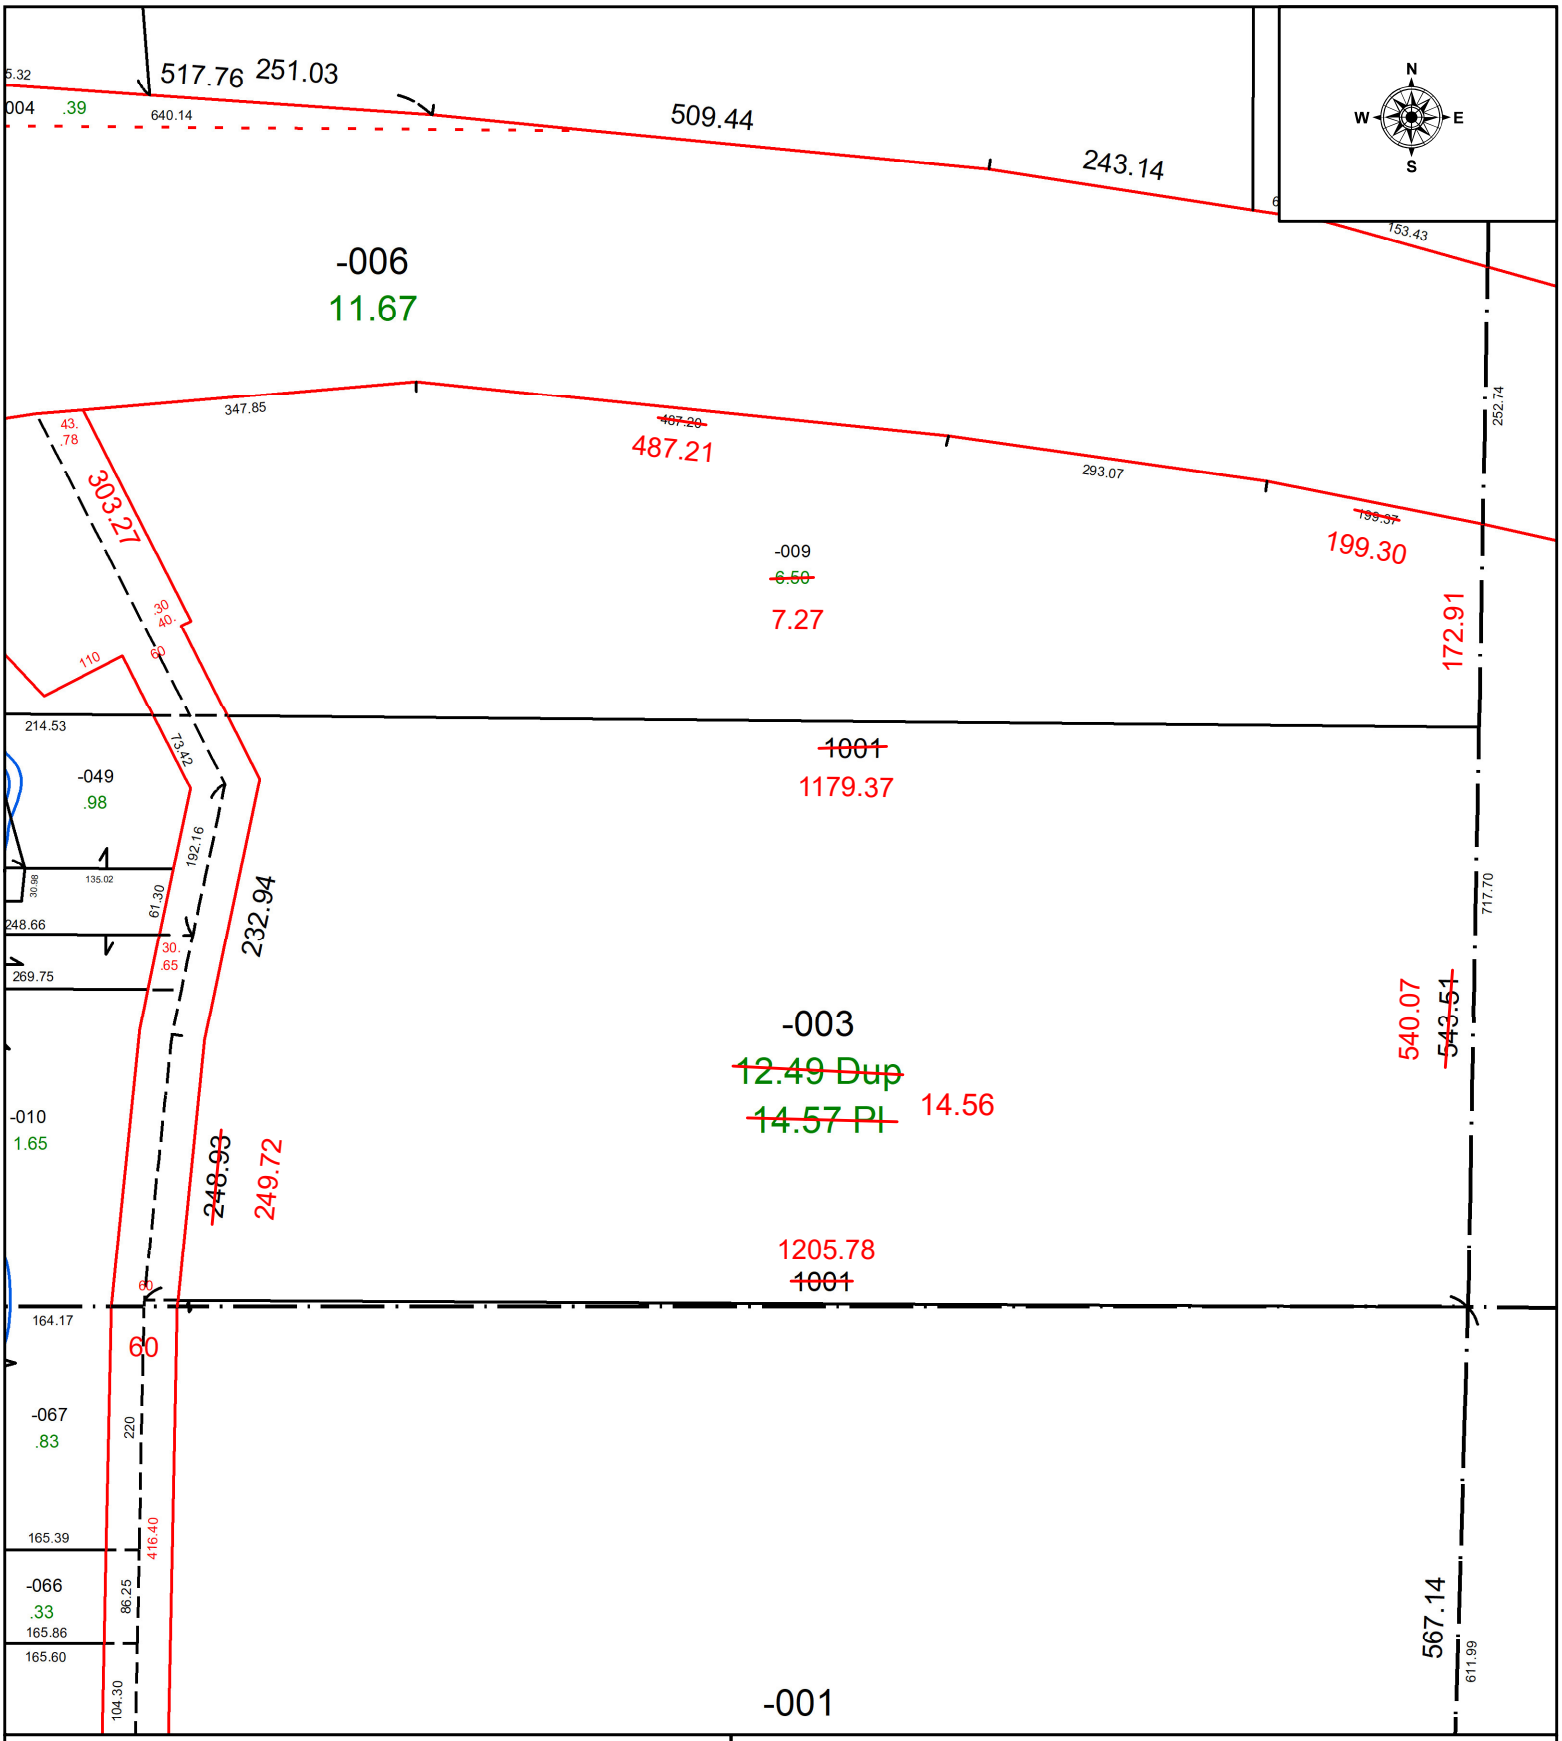

SPLITS/DEEDS PROCESSED

LORAIN COUNTY TAX MAP DEPARTMENT
226 MIDDLE AVE. ELYRIA, OH

SURVEYED BY: MICHAEL SPELLACY SURVEY # 51230

CLOSURE: 1: 515835

MAP PAGE(S): 05-00-041

APPOVED BY: WRZ **DATE:** 7/11/2024

SCALE: 1" = 175 **PRIOR INSTRUMENT:** #2018-0681329