PARENT PARCEL: 10-00-006-113-014 & -015

CHILD PARCEL: 10-00-006-113-035

STARTING POINT: COMBINATION PER PRIOR DEED INSTRUMENT NO. 2020- 0764308

24-05328-C

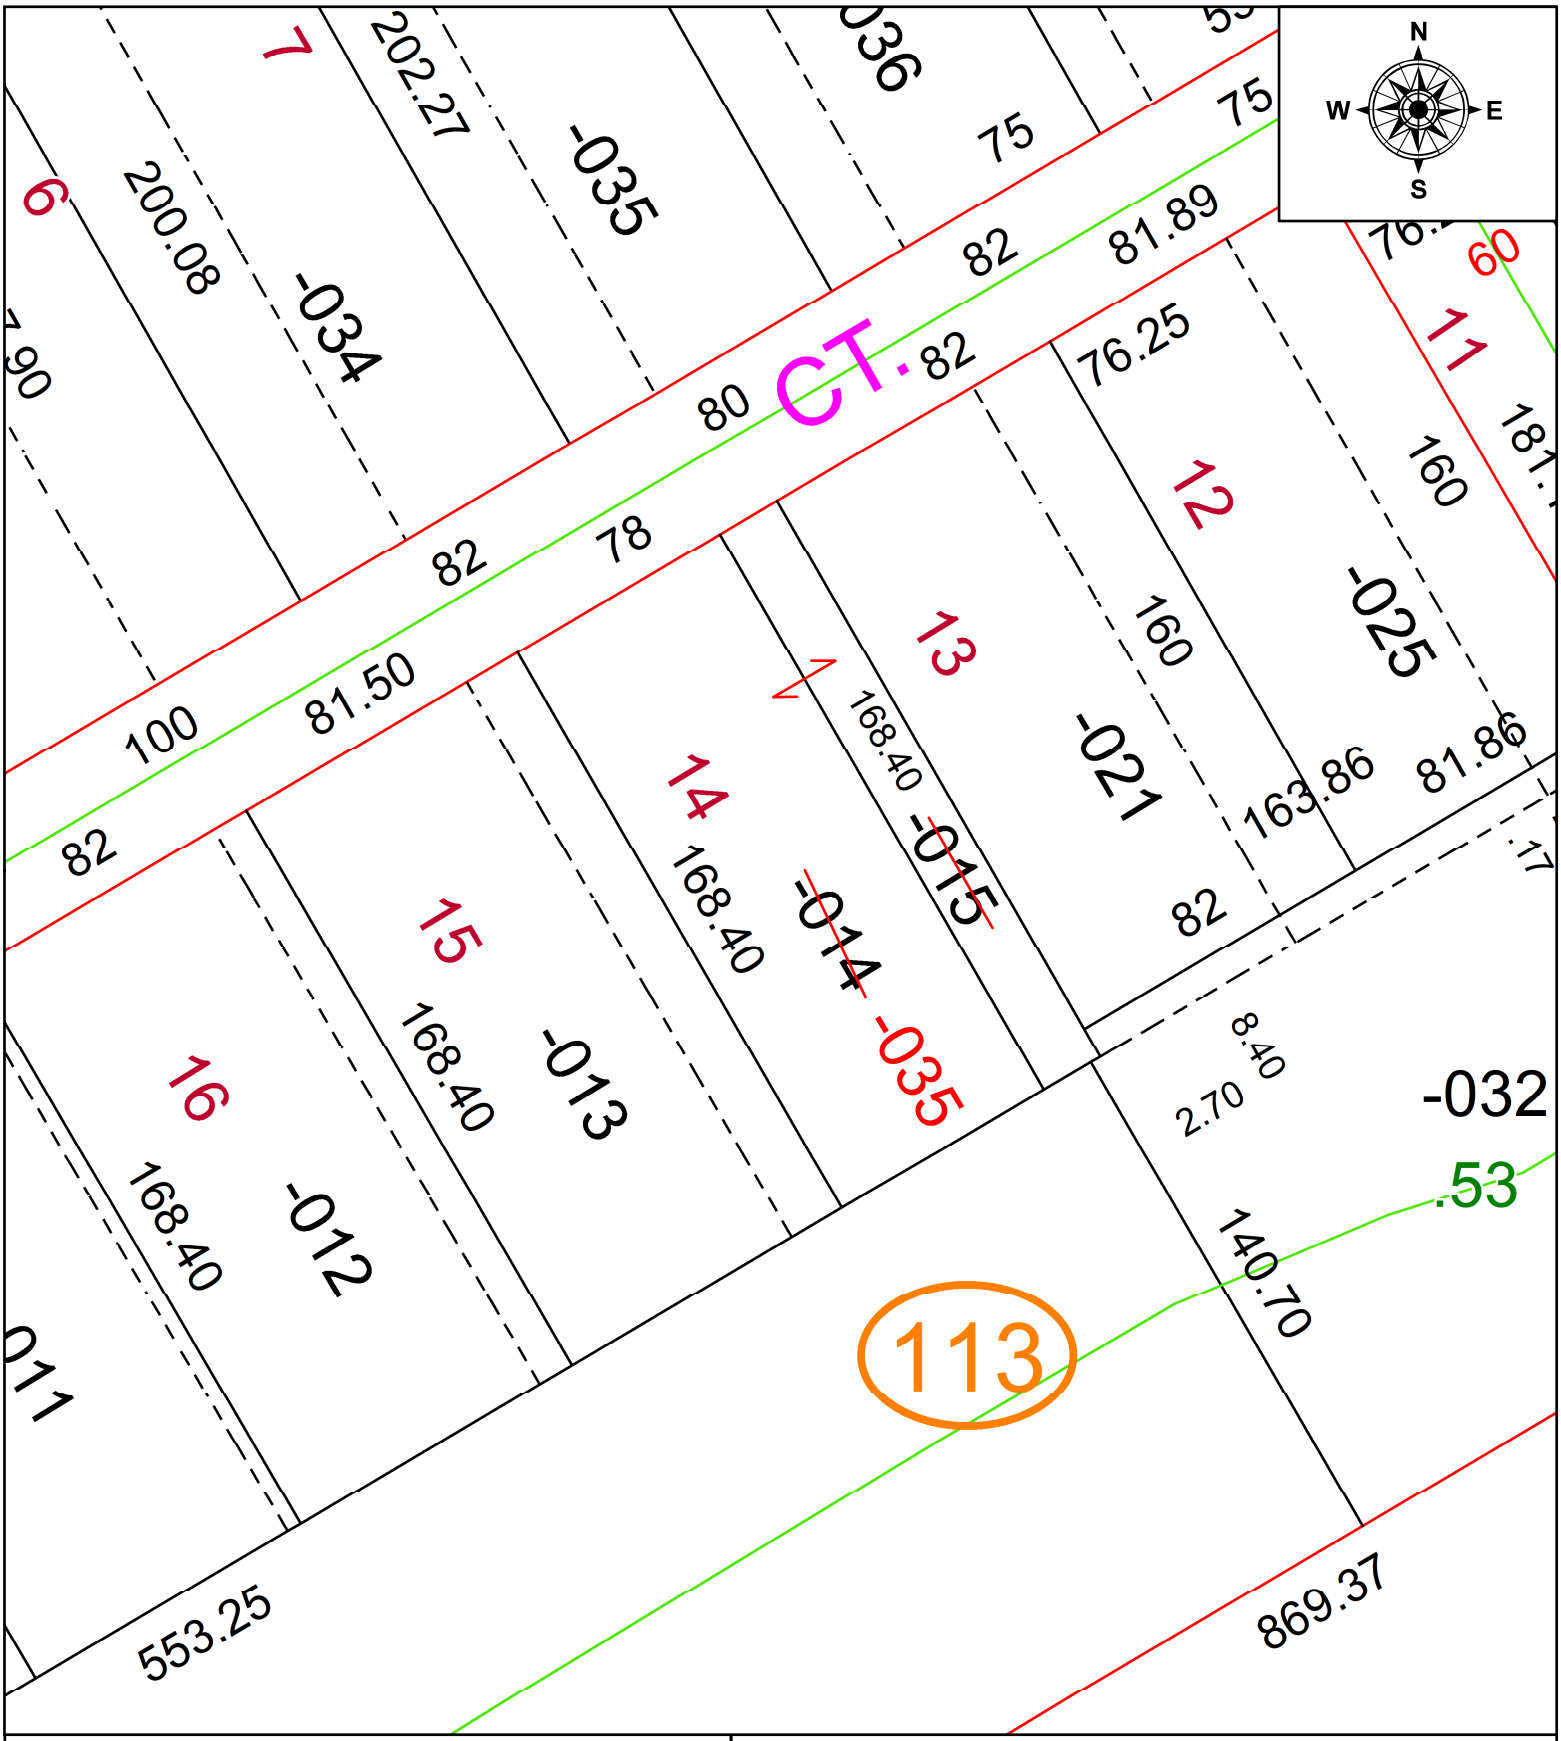

SPLITS/DEEDS PROCESSED

LORAIN COUNTY TAX MAP DEPARTMENT
226 MIDDLE AVE. ELYRIA, OH

SURVEYED BY: C. E. PENFOUND **SURV # N/A**

CLOSURE: 1: INF

MAP PAGE(S): 10-00-006

APPOVED BY: AC **DATE:** July 17, 2024

SCALE: 1 in = 50 ft **PRIOR INSTRUMENT:** 2020- 0764308