PARENT PARCEL: 07-00-027-107-038, -050, & -051

CHILD PARCEL: 07-00-027-107-052

STARTING POINT: NW CORNER OF S/L 35 AND S LINE OF WESTWOOD DR

24-05329-C

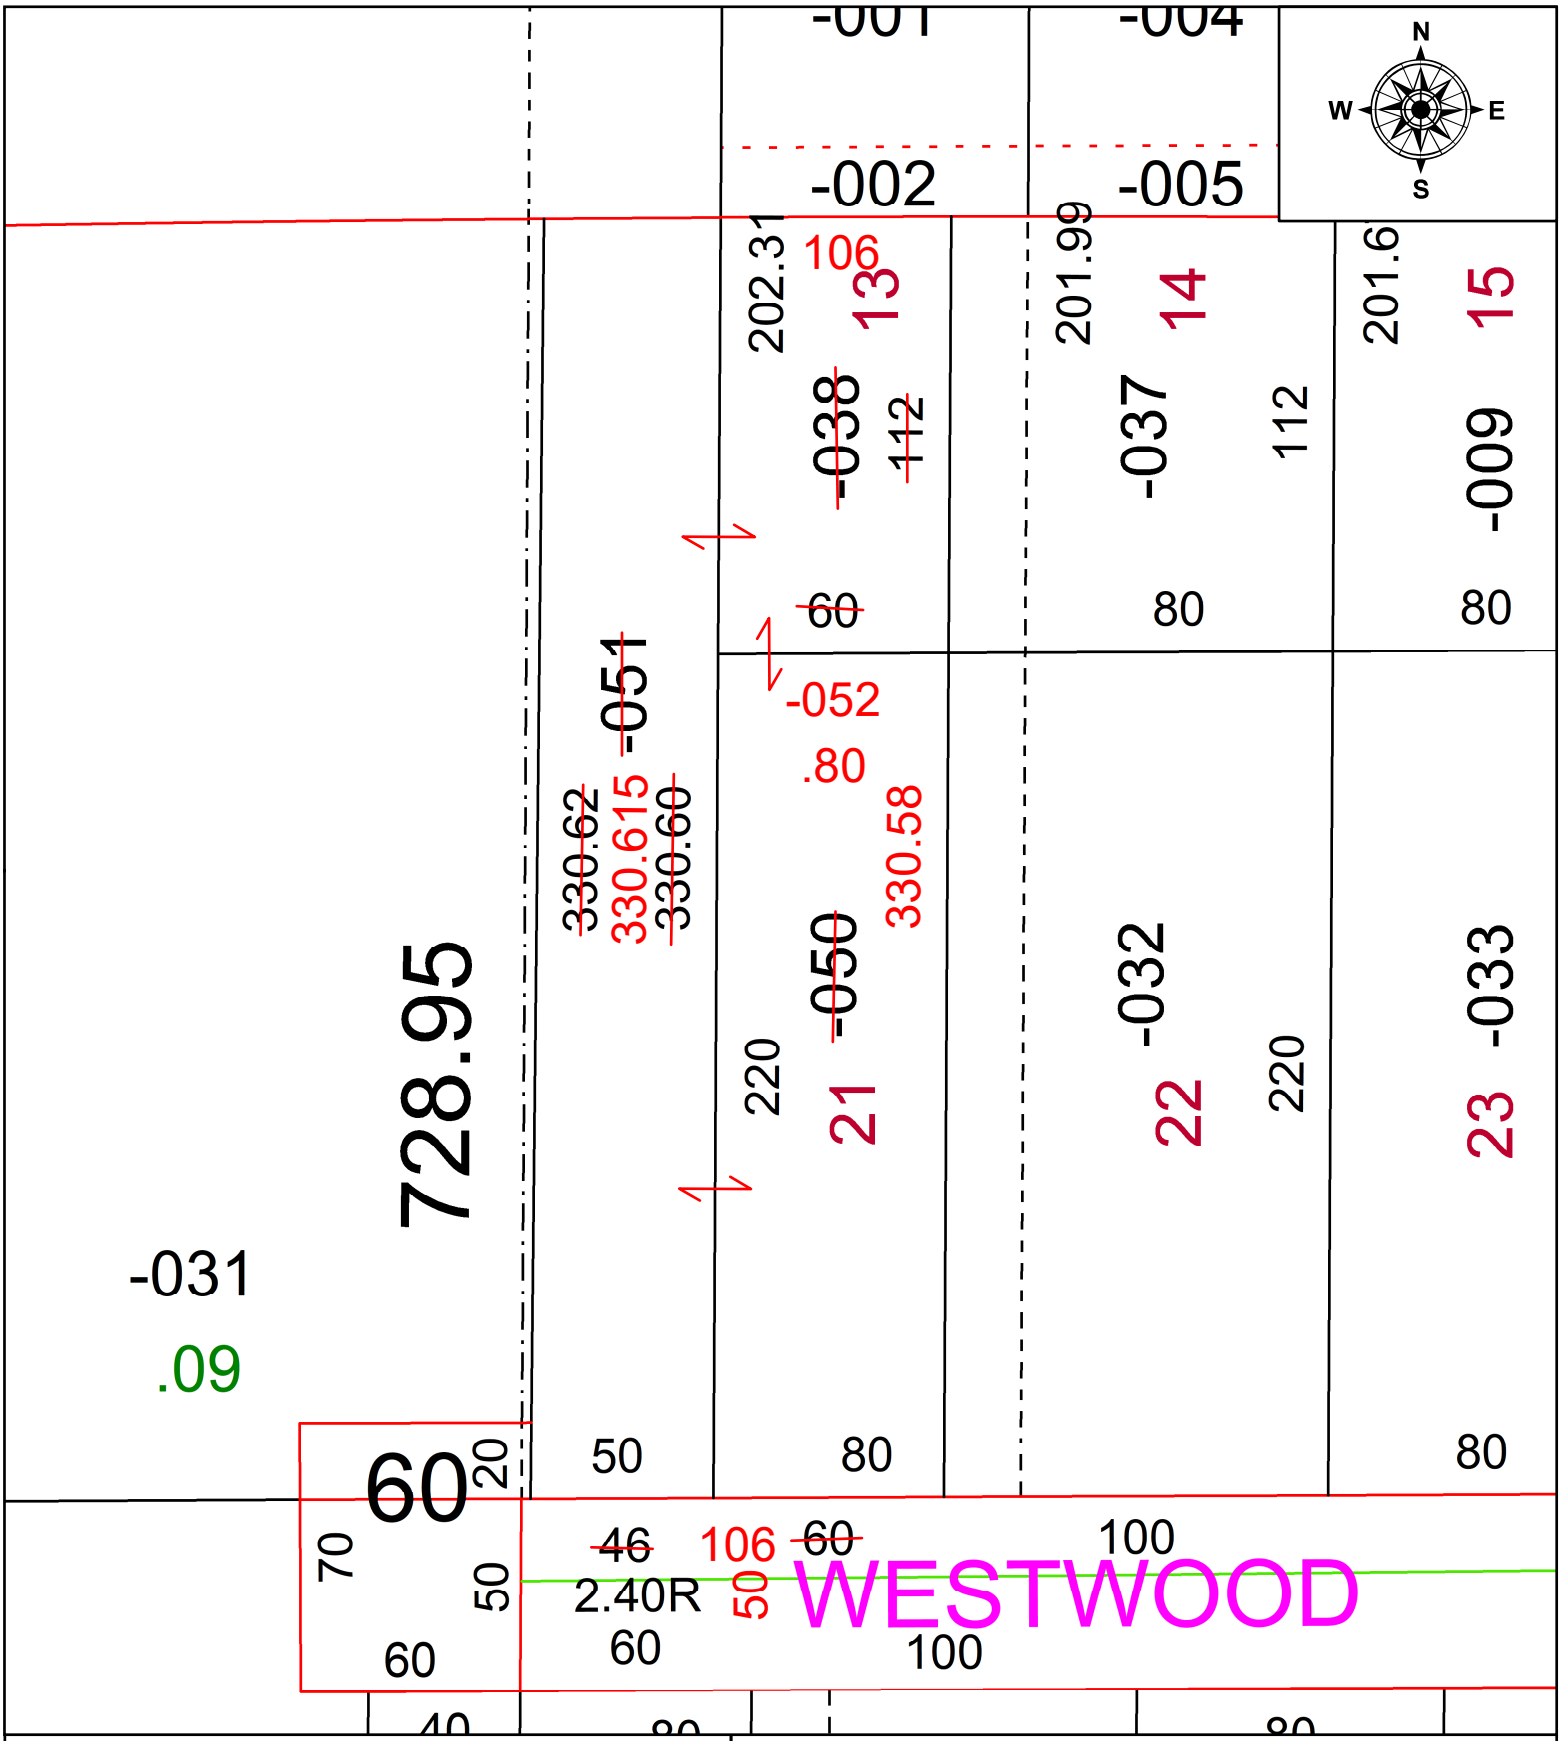

SPLITS/DEEDS PROCESSED

LORAIN COUNTY TAX MAP DEPARTMENT
226 MIDDLE AVE. ELYRIA, OH

SURVEYED BY: RODGER SIMON **SURV # N/A**

CLOSURE: 1: 1236923

MAP PAGE(S): 07-00-027

APPOVED BY: AC **DATE:** July 18, 2024

SCALE: 1 in = 50 ft **PRIOR INSTRUMENT:** 2024- 0013278