PARENT PARCEL: 06-25-021-106-056

CHILD PARCEL: AC CORR PER SURVEYOR SEAN BOLAND

STARTING POINT: INTERSECTION OF THE WEST LINE OF ABBE RD & NORTH LINE OF CLEVELAND ST

24-05331-C

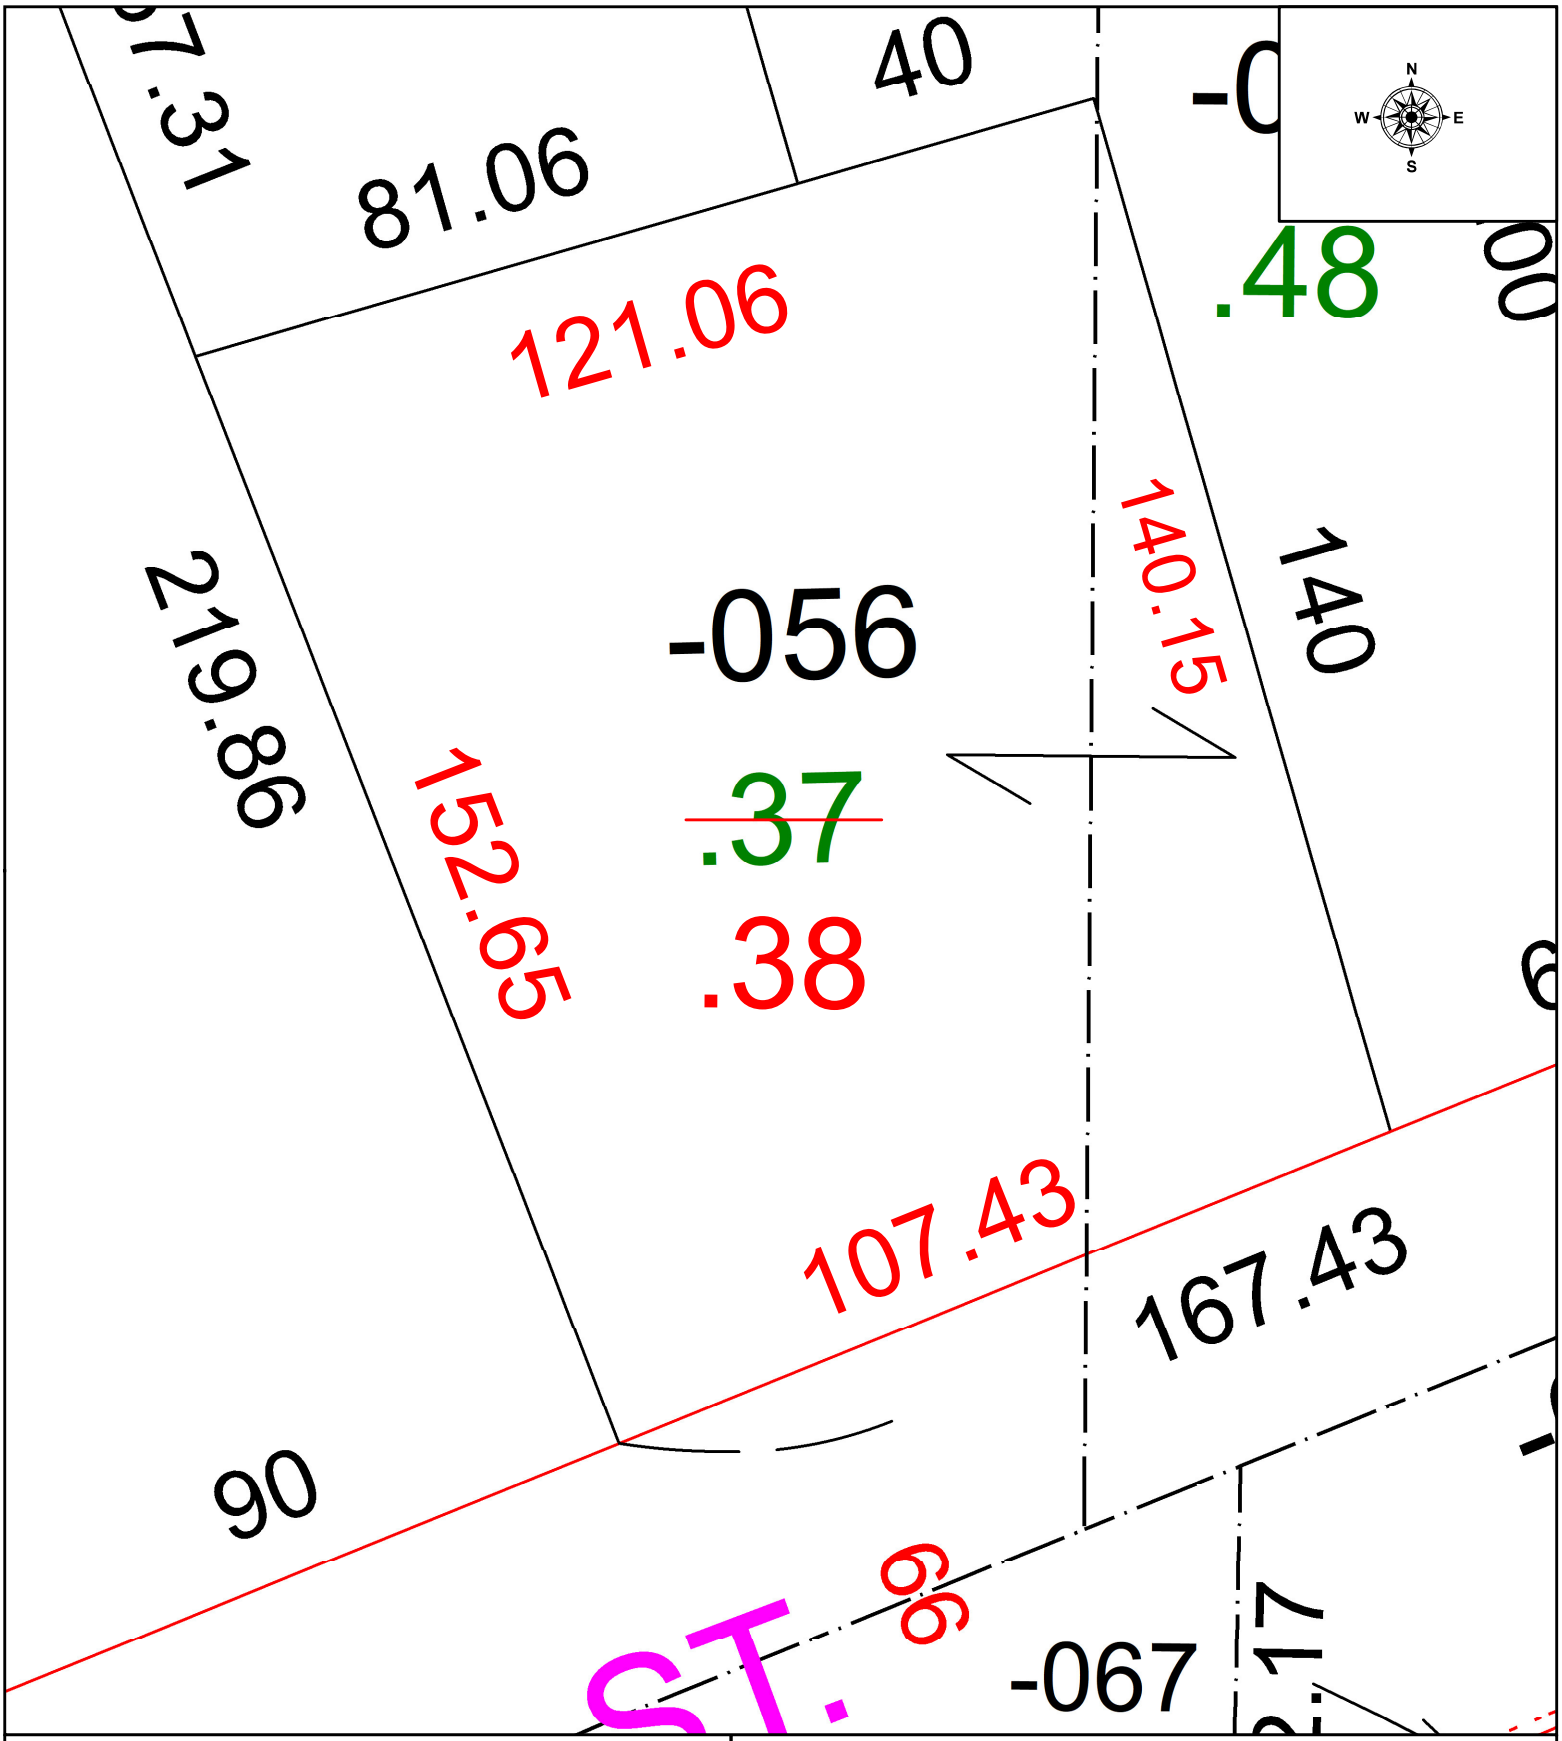

SPLITS/DEEDS PROCESSED

LORAIN COUNTY TAX MAP DEPARTMENT
226 MIDDLE AVE. ELYRIA, OH

SURVEYED BY: SEAN BOLAND SURVEY # 51236

CLOSURE: 1: 3132781

MAP PAGE(S): 06-25-021

APPOVED BY: WRZ **DATE:** 7/25/2024

SCALE: 1" = 25 **PRIOR INSTRUMENT:** #2021-0840892